PERM. PARCEL No. 12 - 00 - 062 - 000 - 003 COL.

LOT SPLIT MAP

FOR MRS. LYNDA H. FETCHET

PART OF ORIGINAL COLUMBIA TWP. LOT NO. 62

COUNTY OF LORAIN, OHIO

0 40' 80'

MAY 14, 1997
JULY 8, 1997
JULY 9, 1997
AUG. 12, 1997

I HEREBY STATE THAT THIS IS A TRUE AND ACCURATE REPRESENTATION OF THE PREMISES SHOWN HEREON AND THAT IT WAS BASED ON AN ACTUAL SURVEY PERFORMED BY ME ON THE GROUND ON MAY 14, 1997 AND THAT IT WAS DONE IN ACCORDANCE WITH THE MINIMUM STANDARDS FOR BOUNDRY SURVEYS IN THE STATE OF OHIO AS ADOPTED IN CHAPTER 4733-37, OF THE ADMINISTRATIVE CODE, ALL TO THE BEST OF MY KNOWLEDGE, INFORMATION AND PERSONAL BELIEFS. DISTANCES ARE GIVEN IN FEET AND DECIMAL PARTS THEREOF. COURSES ARE GIVEN TO AN ASSUMED MERIDIAN AND ARE USED TO INDICATE ANGLES ONLY.

CIPS - CAPPED 5/8" IRON PIN SET

BY JAMES B. ROOT
REGISTERED SURVEYOR NO. 5045

#22260
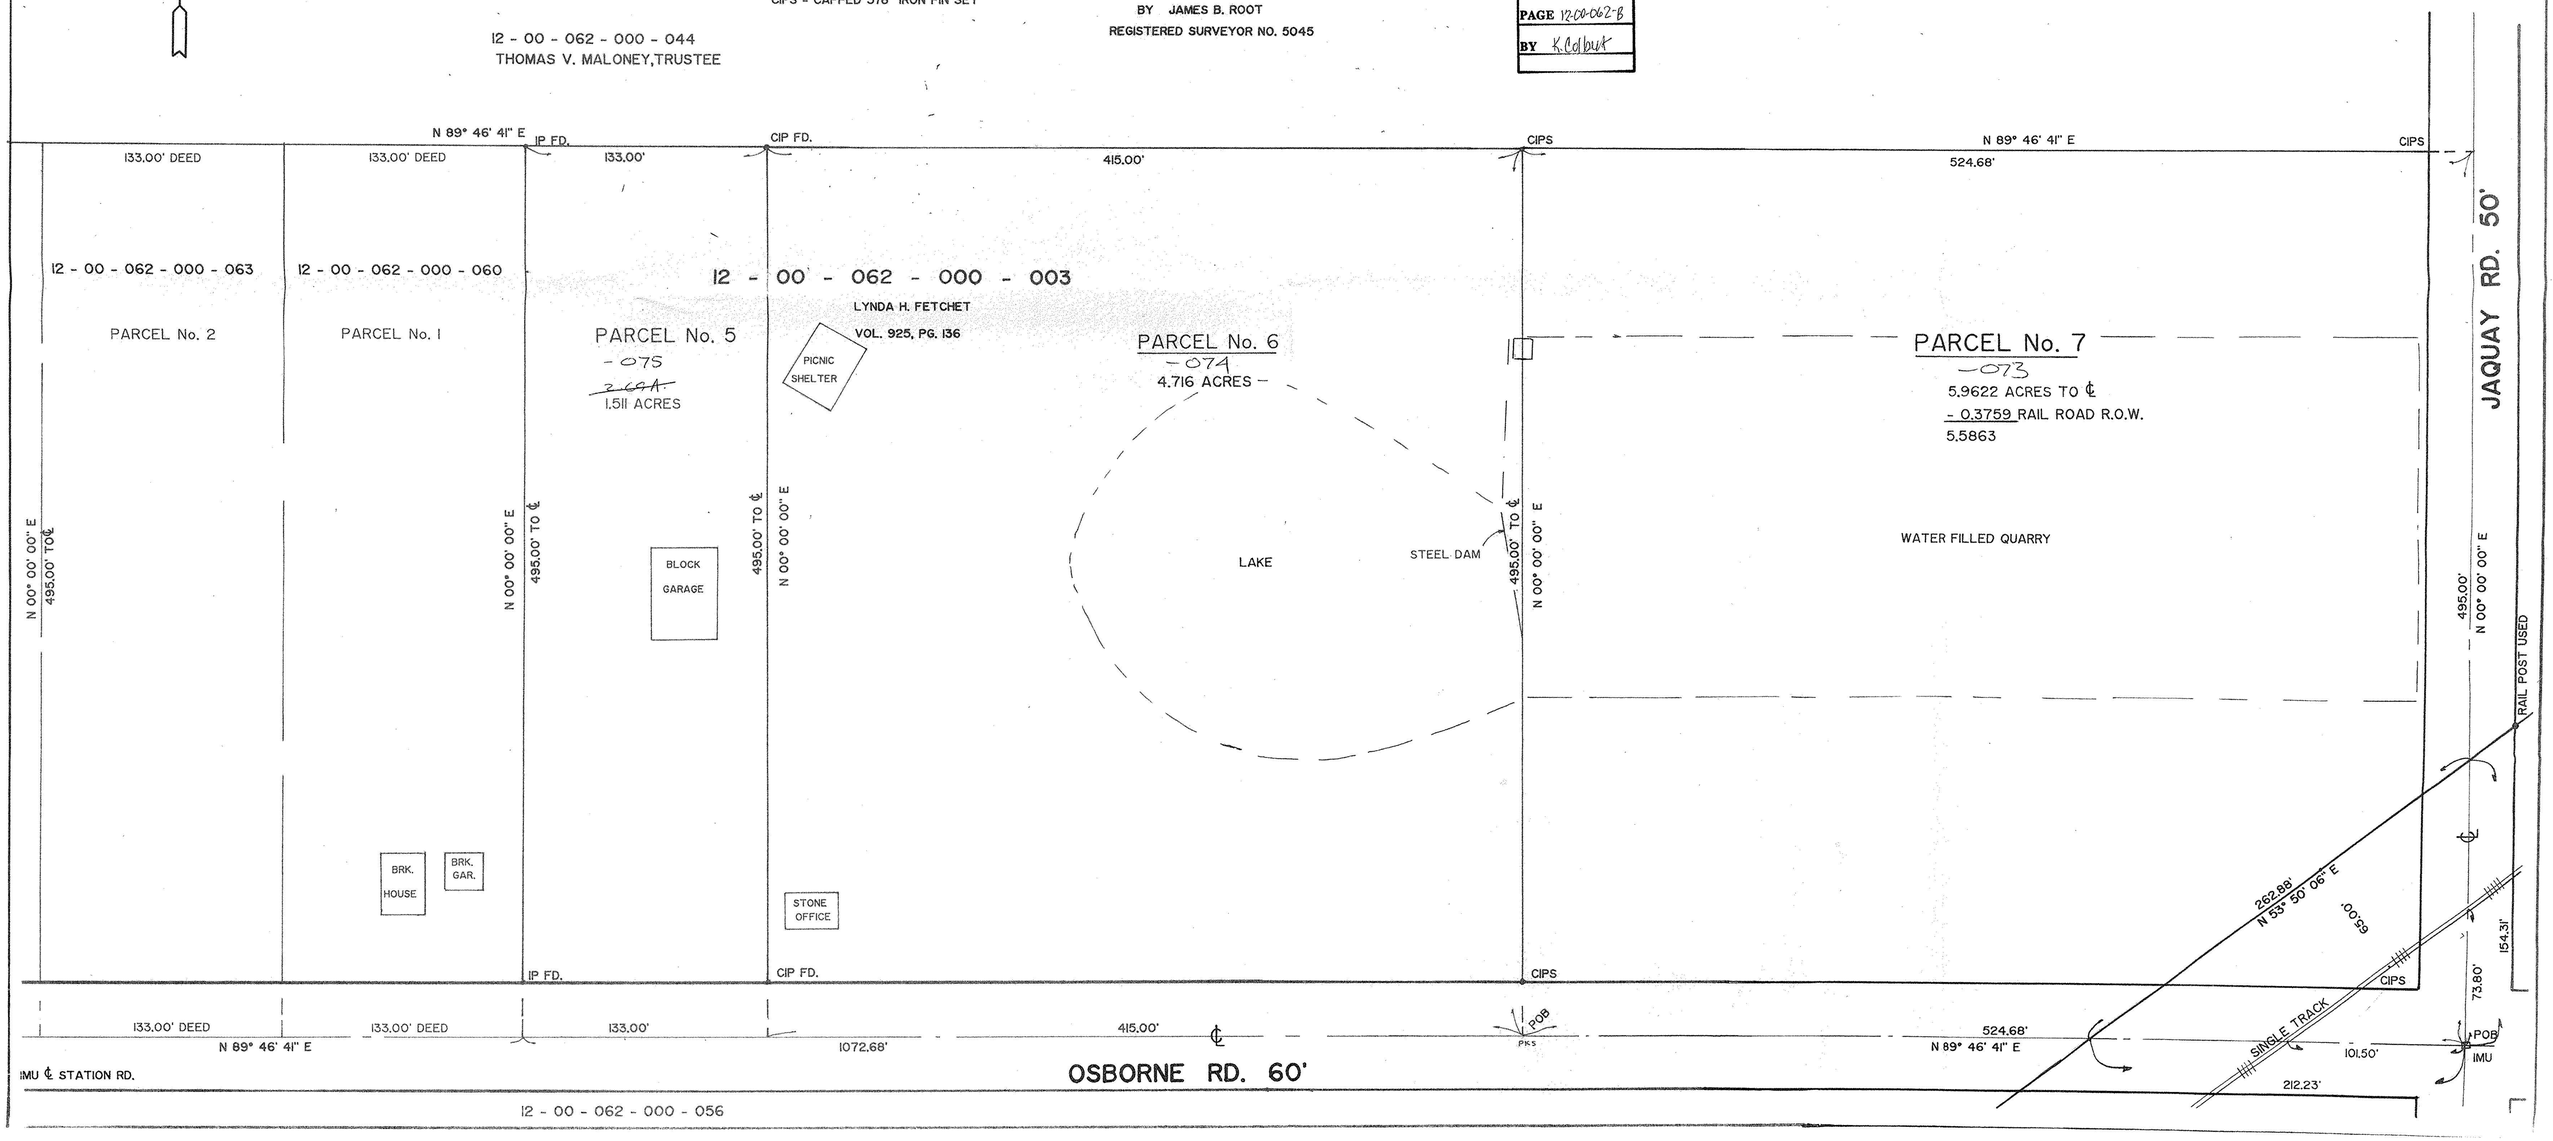
APPROVED LORAIN CO. MAP DEPT
DATE 8/14/97
PAGE 12-00-062-B
BY K.Colbert