


17. 12. 11
O.L. 64
77

#

12-00-064
12-00-077-

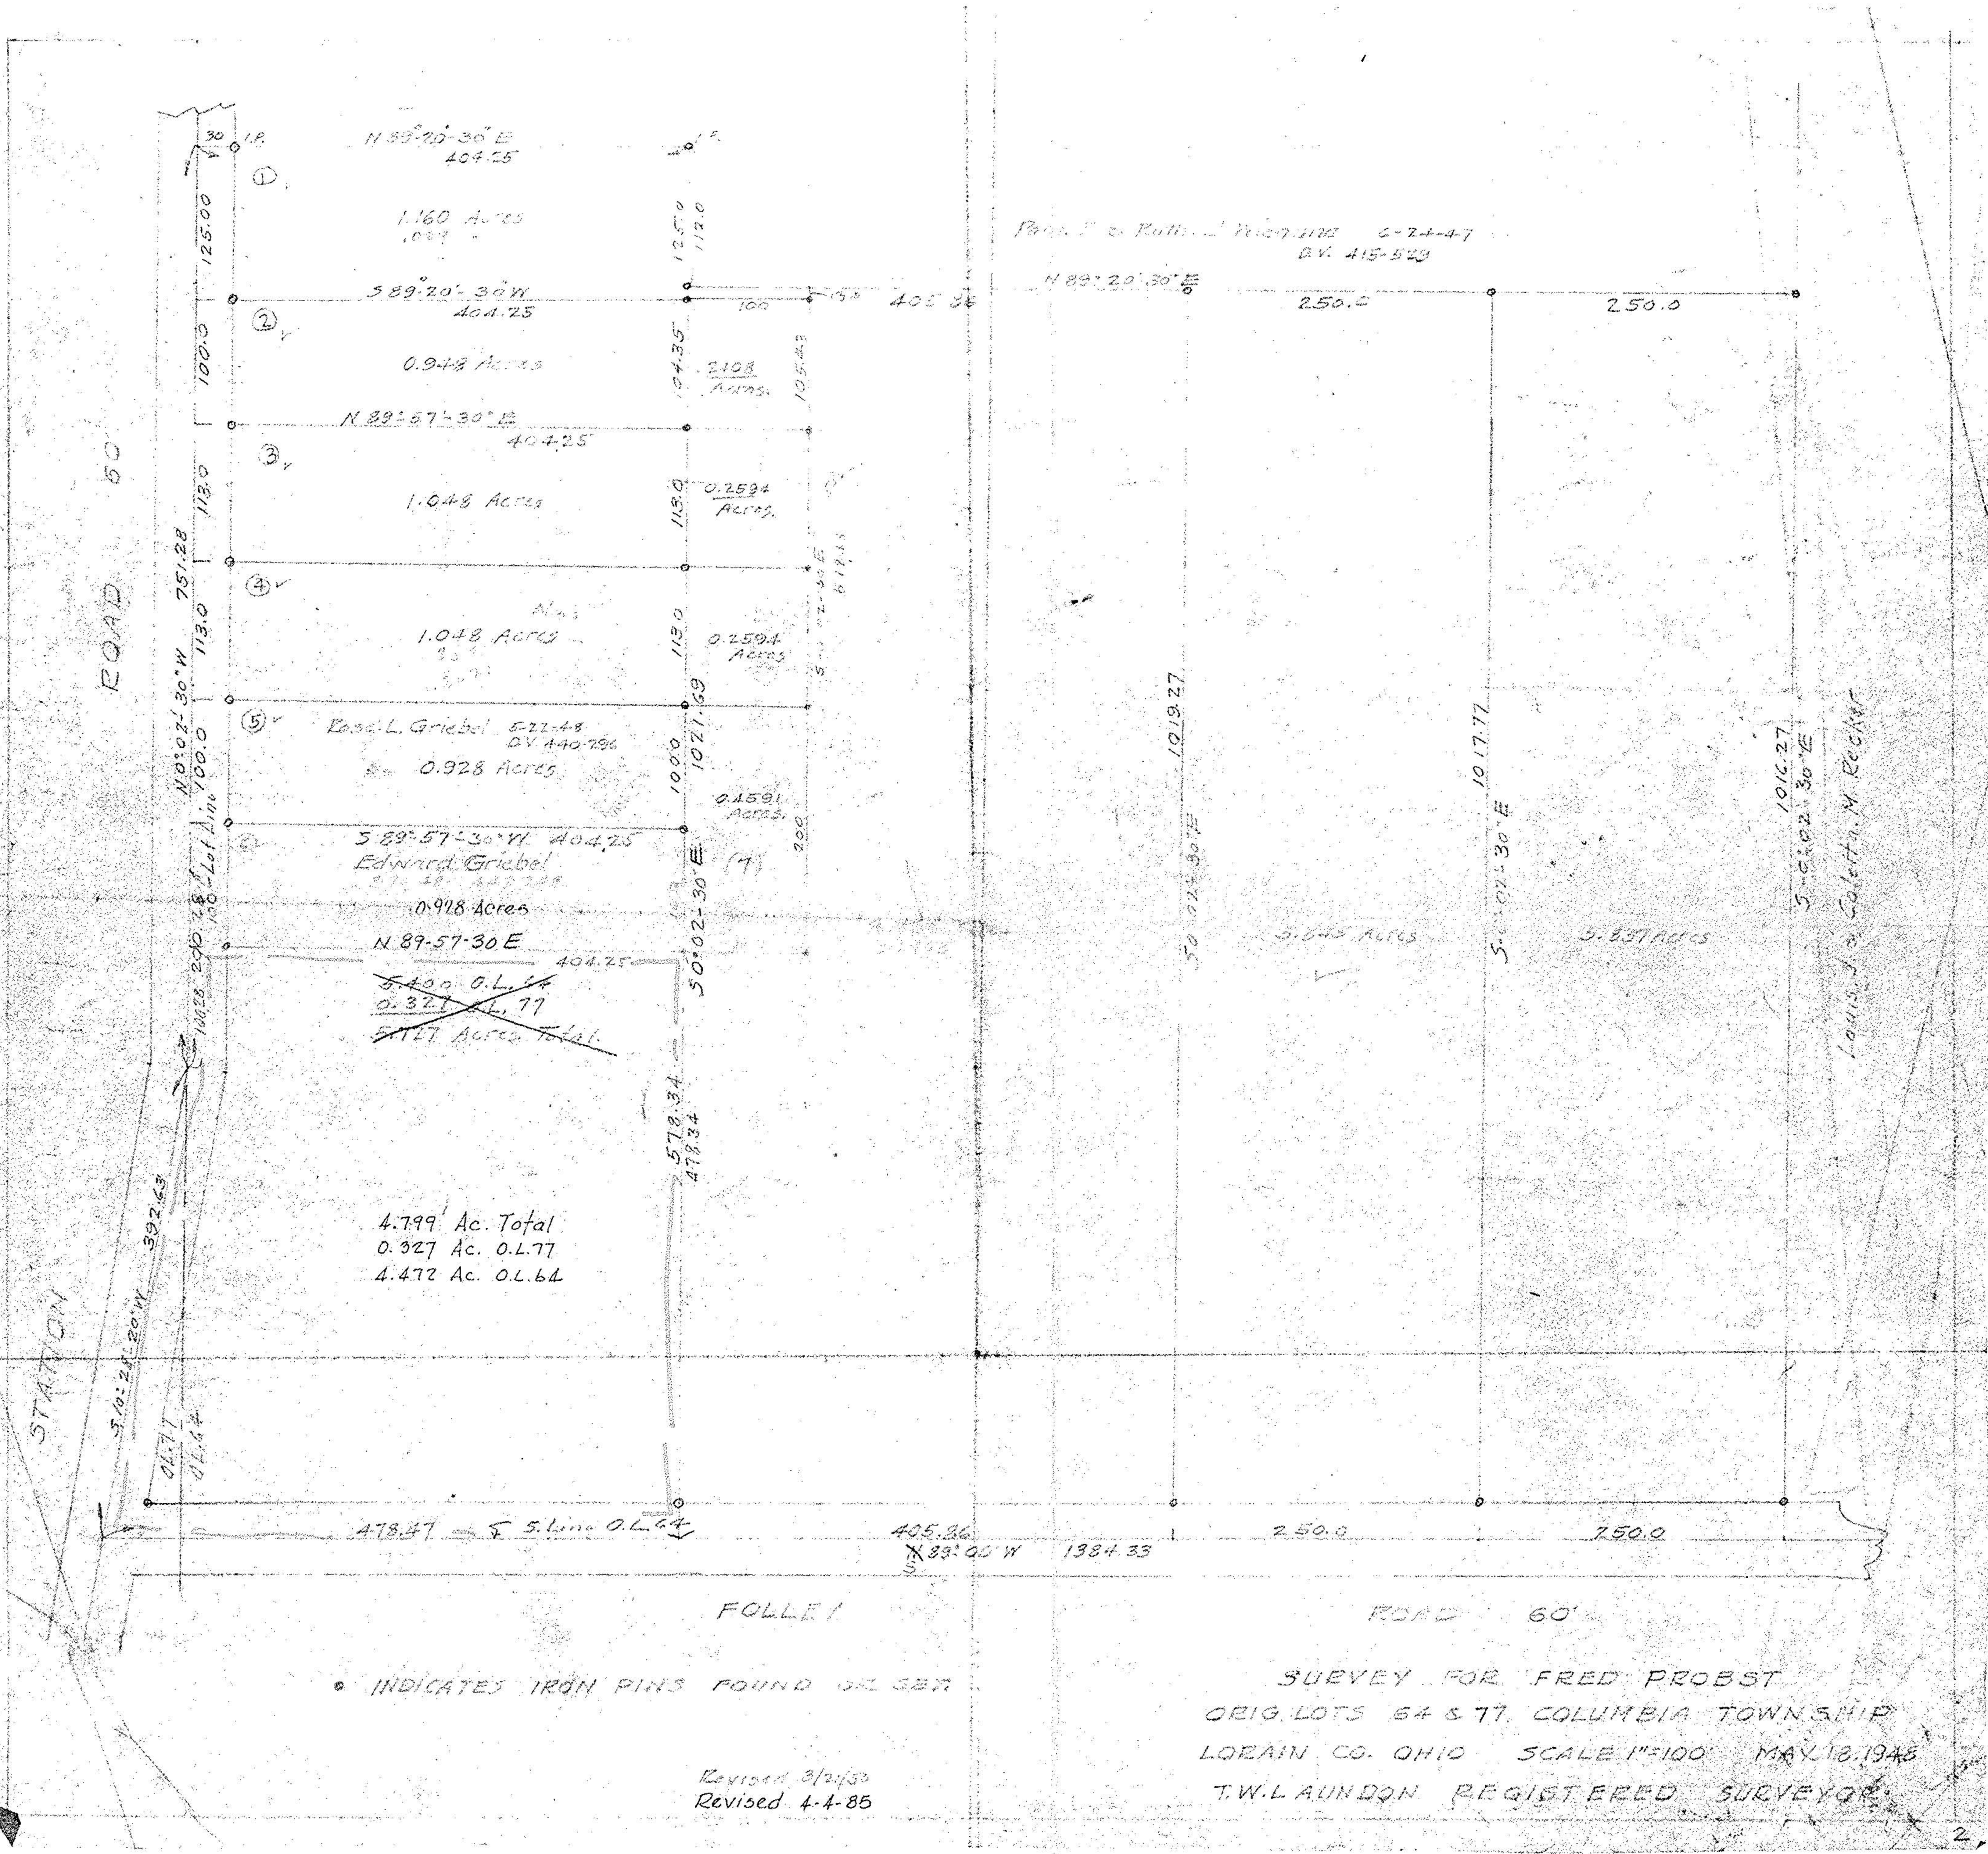

Pg. 12-A Pg. 12-00-064-A
12-00-077-

12-00-064-101-022 4.40 A.
12-00-077-000, 012 0.33 A.

L - 0.026354
D - 2.508340
P 1853.97
Ac. = 4.786968 A.