LAUNDON . SIMON . CAHL & ASSOC. INC.
CONSULTING ENGINEERS & SURVEYORS
219 COURT ST. ELYRIA, OHIO 44035

SURVEY FOR:
TIMOTHY M. & ELAINE M. MAYHER
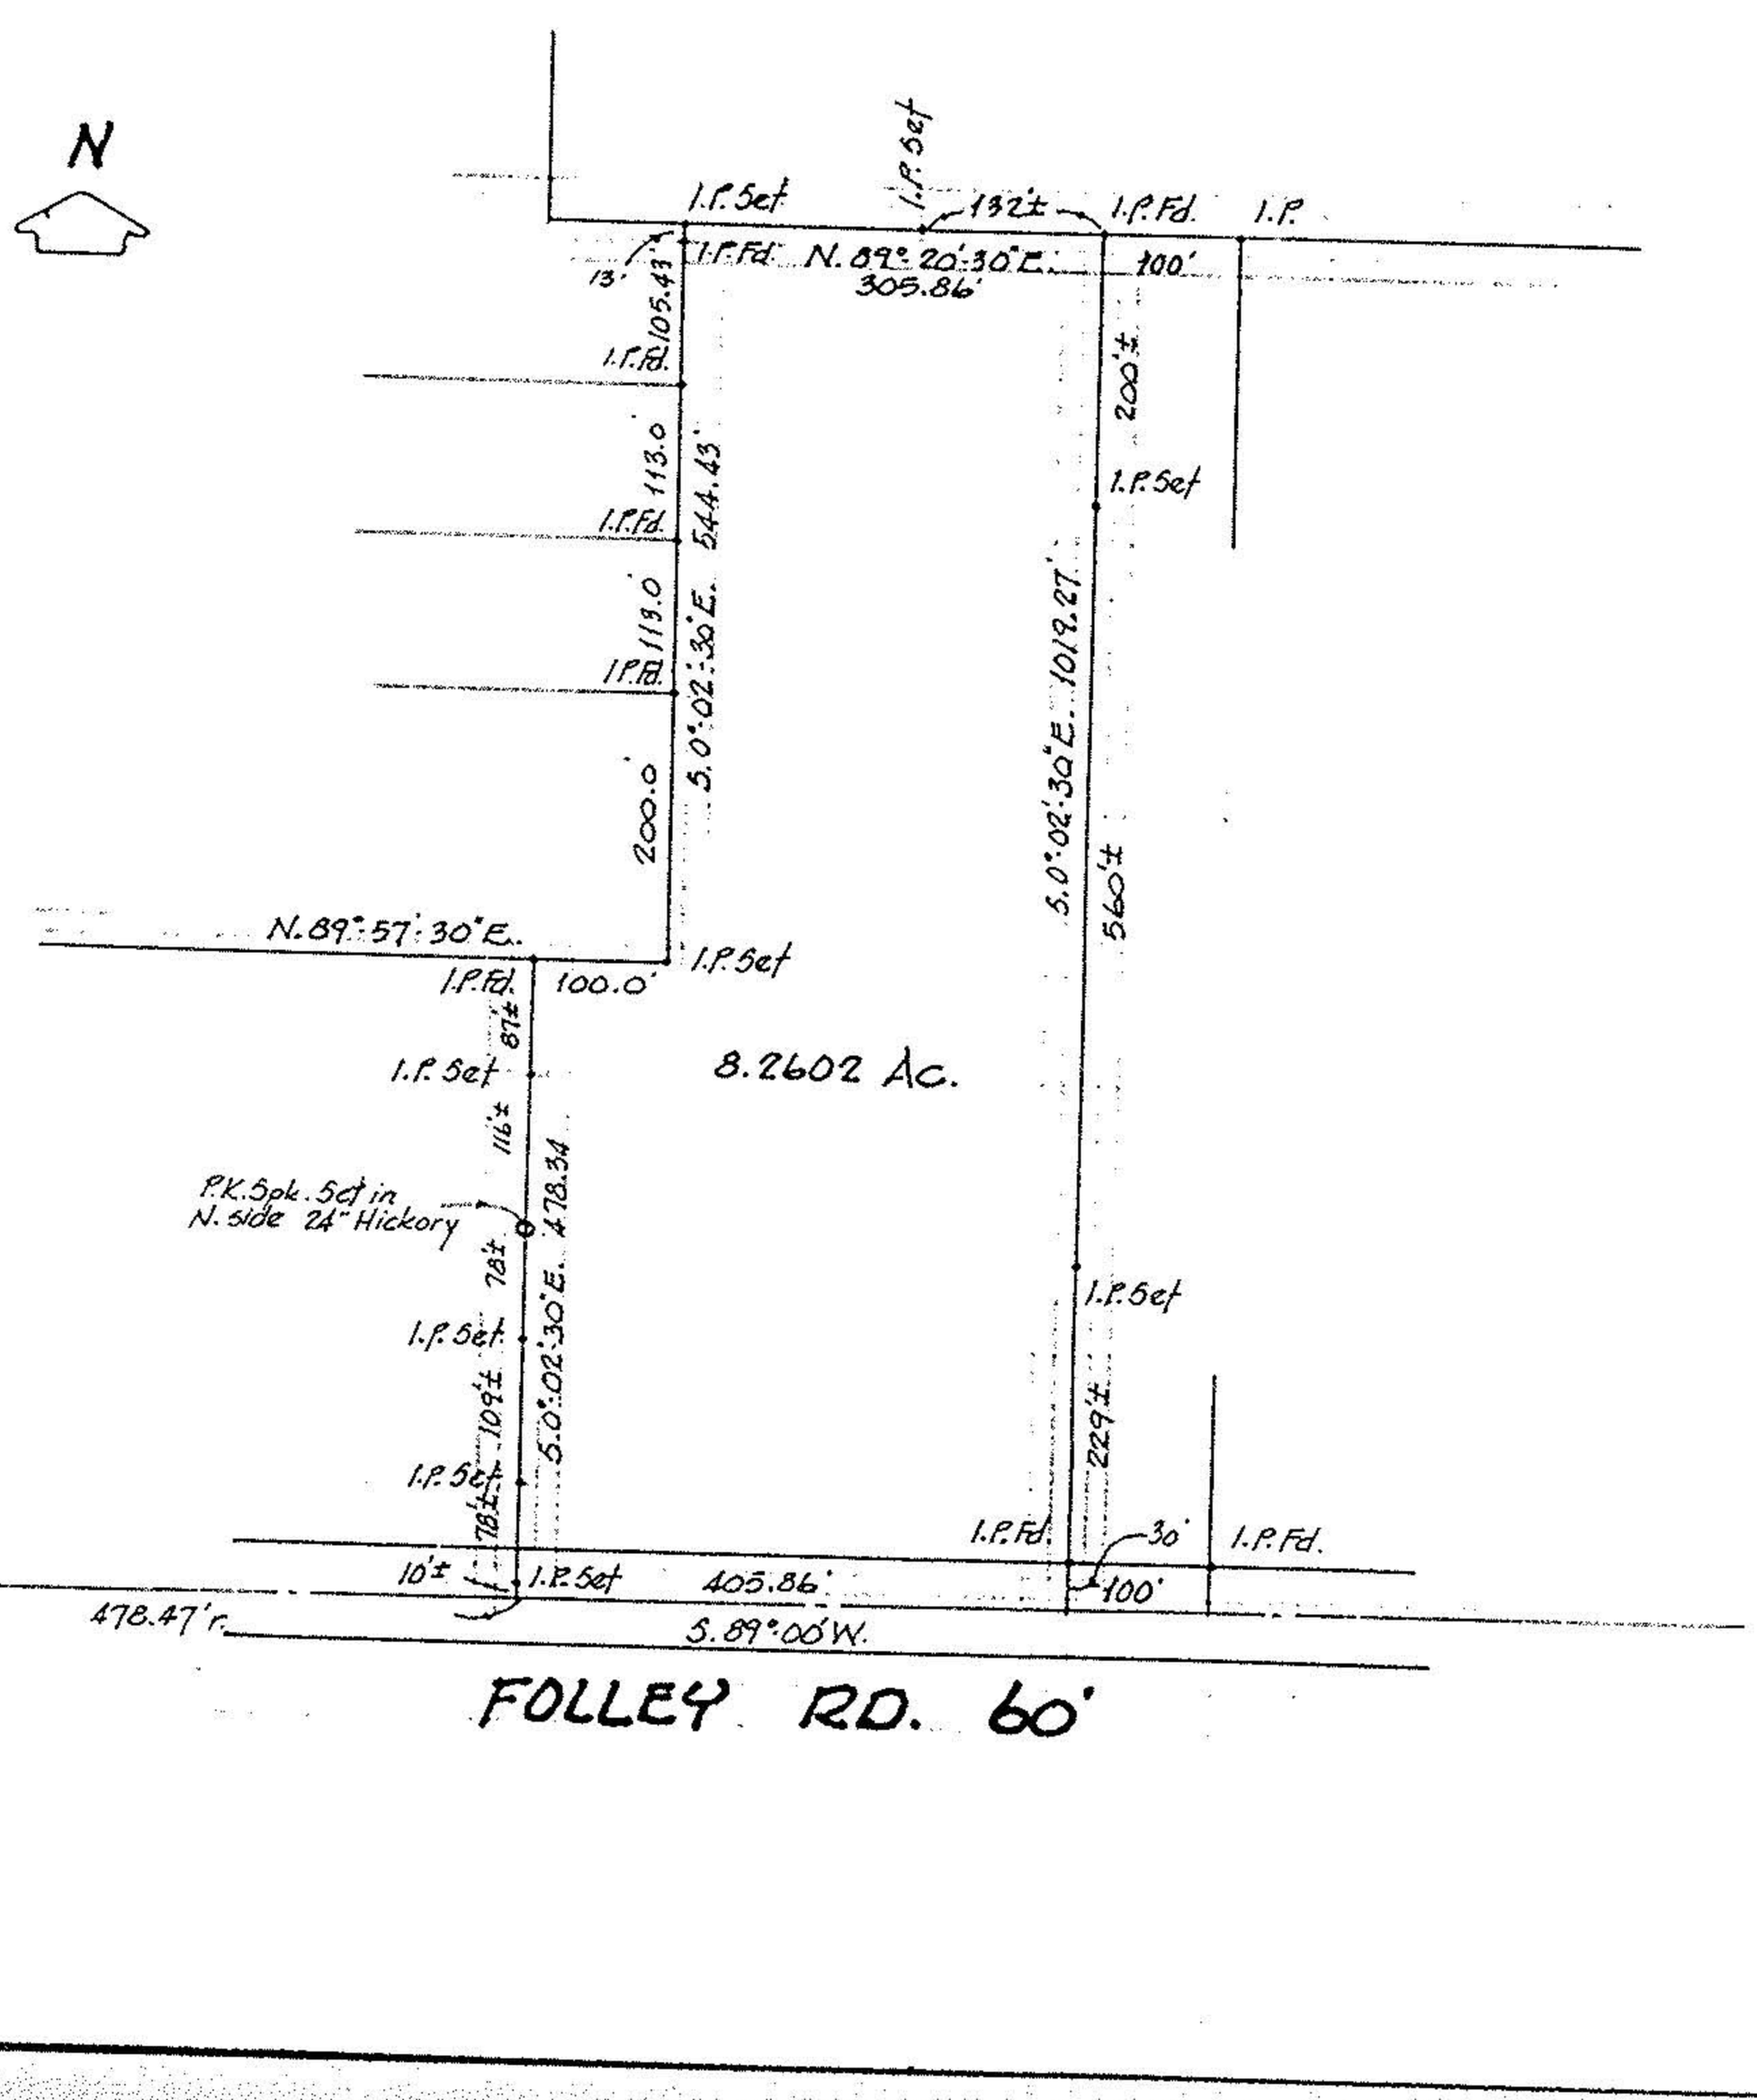
Orig. Lot 64	City of	Date MAY '86 Scale 1" = 200'
Orig. Sec	Village of	Dwn. by R.G.S. Chkd. by
Tract	County of LORAIN	Job No. 86-1469 F.B.
Township of COLUMBIA	State of OHIO	Printed