LAUNDON . SIMON . CAHL & ASSOC. INC.
CONSULTING ENGINEERS & SURVEYORS
219 COURT ST. ELYRIA, OHIO 44035

SURVEY FOR
GREGORY A. & MAURA KRYSA

Orig. Lot 62	City of	Date SEPT 15, 88 Scale 1" = 200
Orig. Sec	Village of	Dwn. by R.G.S. Chkd. by C.J.
Tract	County of LORAIN	Job No. 88-1741 F.B.
Township of COLUMBIA	State of OHIO	Printed SEP 28 1988

12-00-064 A

#18374

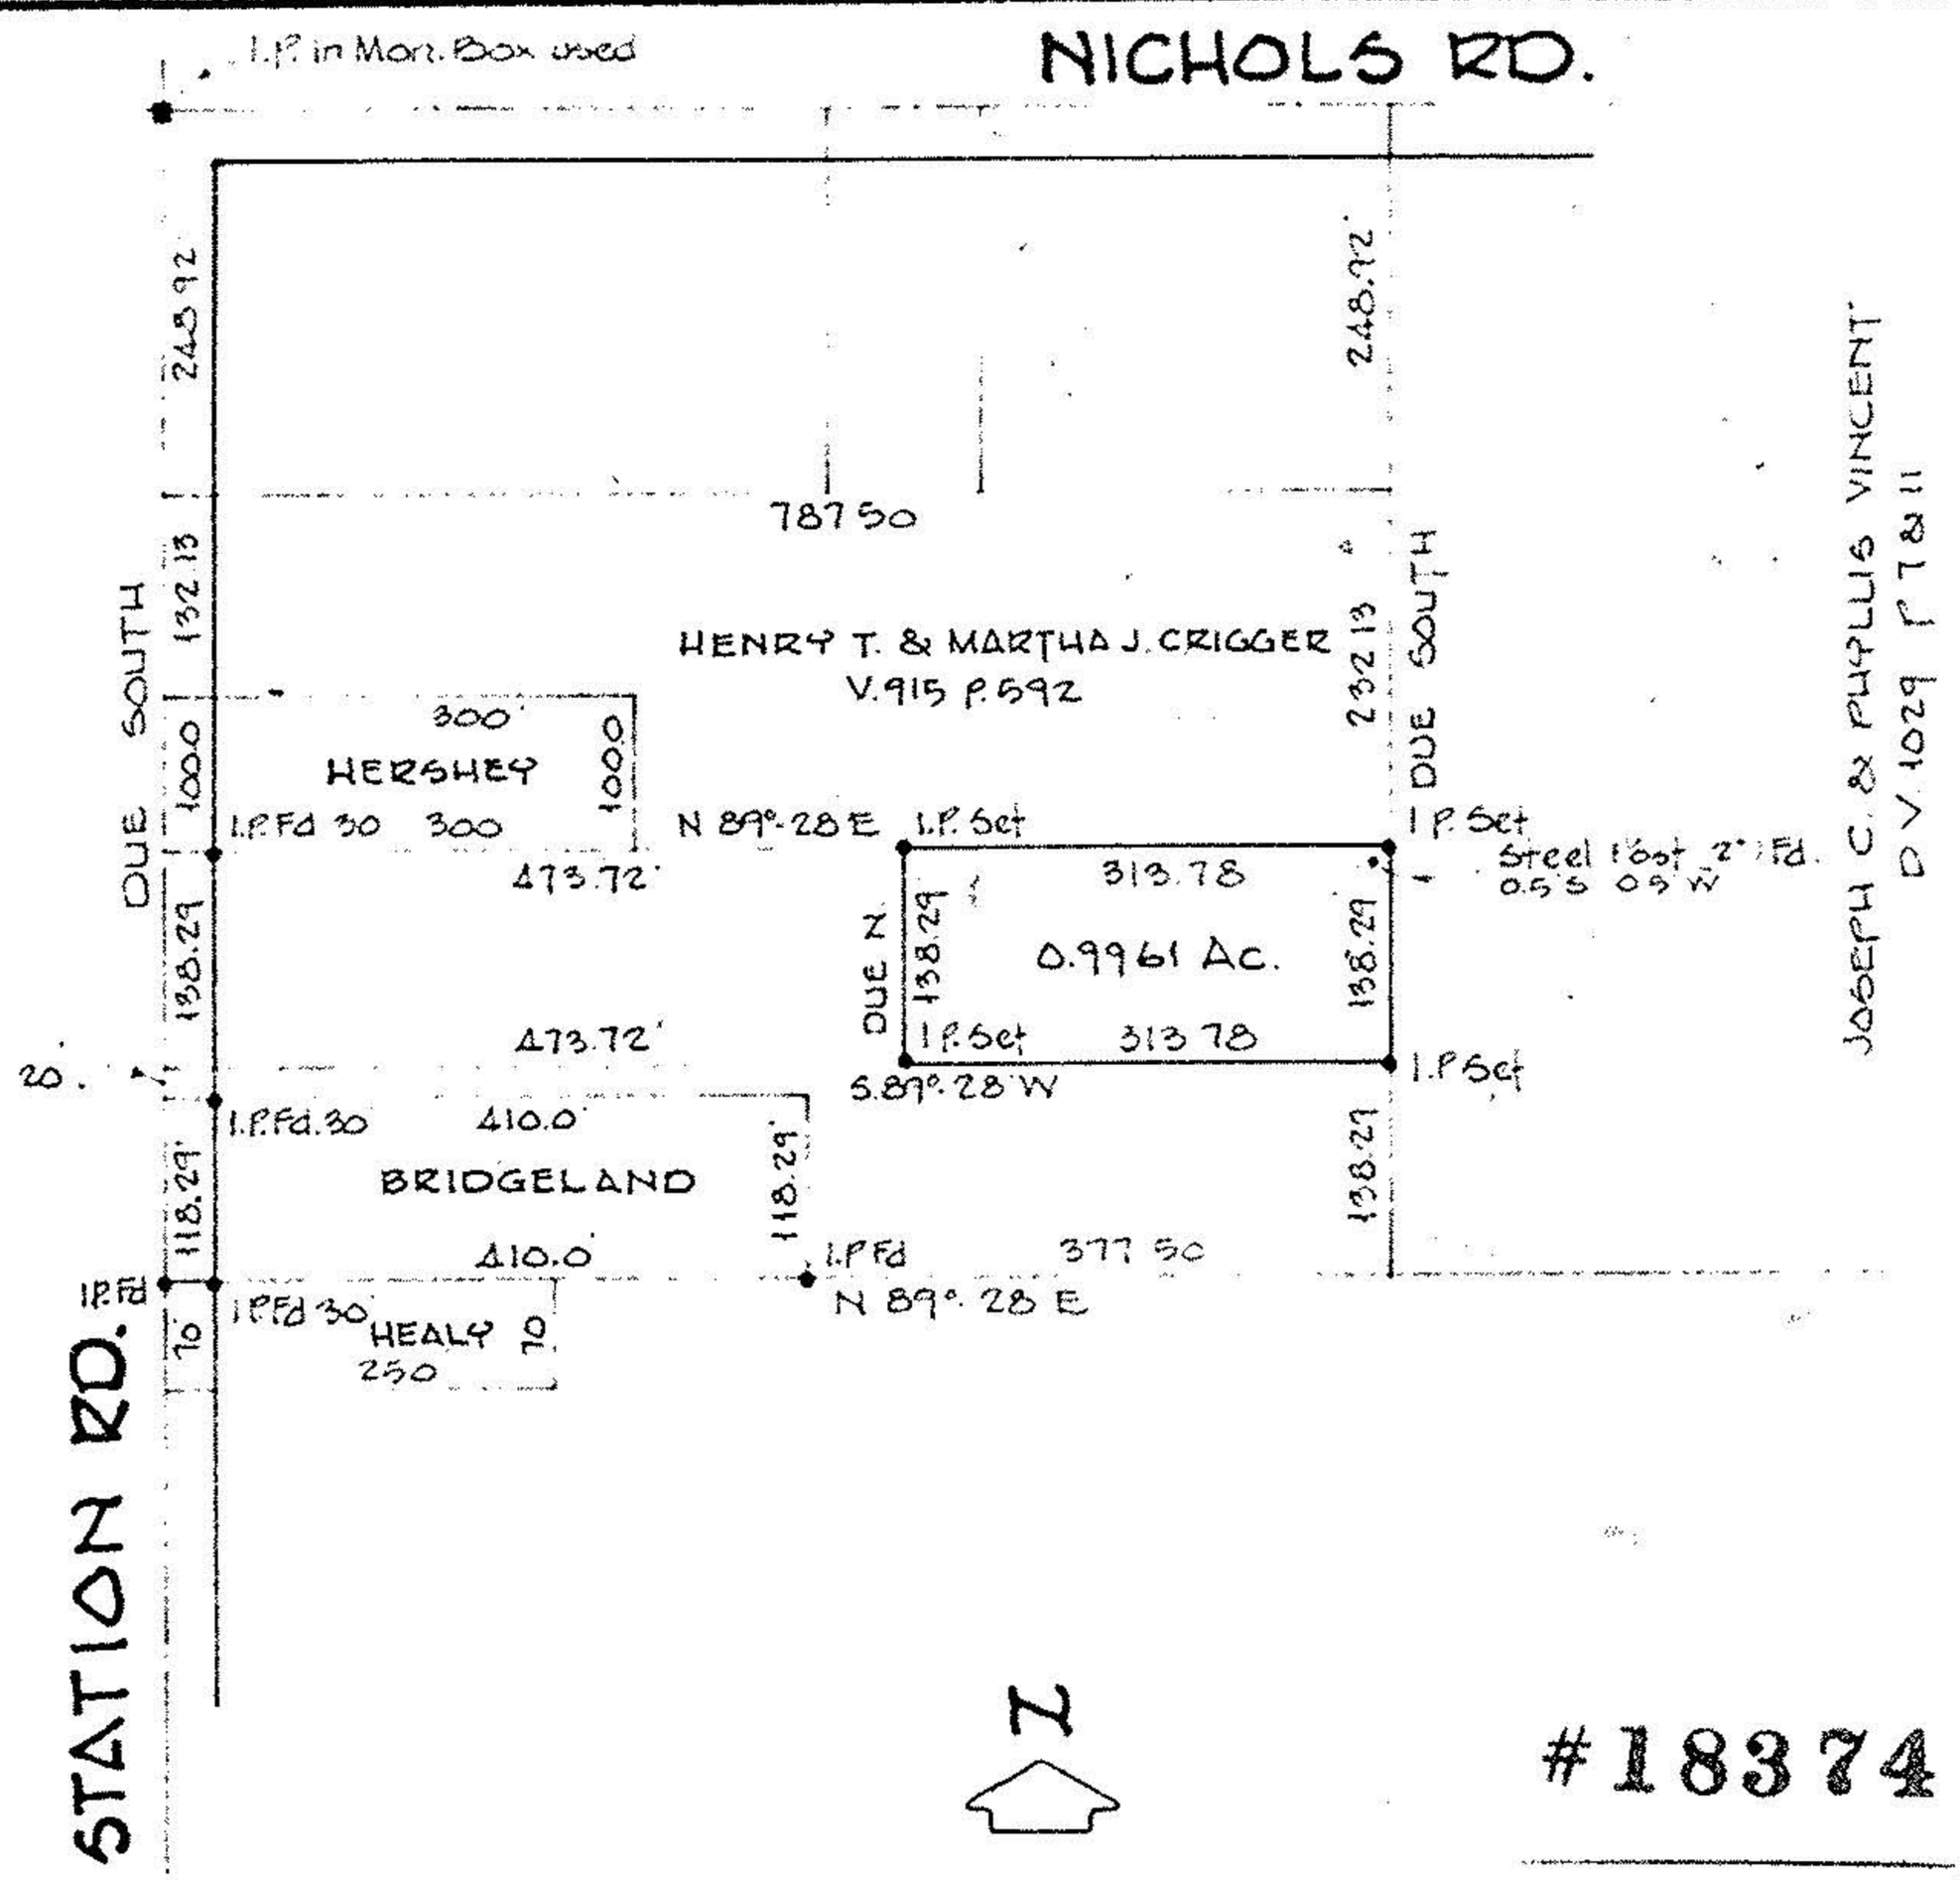

#18374

12-00-064-A

STATE OF OHIO
RODGER G. SIMON
5101
REGISTERED SURVEYOR

APPROVED
LORAIN CO.
MAP DEPT.
DATE 4-4-89
PAGE 12-00-064 A
BY CAROL FRANCIS
VOID AFTER ~~XX~~ 18374