KLEINOEDER · SCHMIDT
and ASSOCIATES

ENGINEERS — SURVEYORS — CONSULTANTS in LAND PLANNING

ELYRIA - NORWALK - MEDINA OHIO

SURVEY

Sublot(s) _____

Subd'n _____

Township COLUMBIA Tract _____

Orig. Lot(s) 89 Sec. _____

County of LORAIN State of Ohio

Corporation _____

12-00-022

12-00-0001

12-00-0089

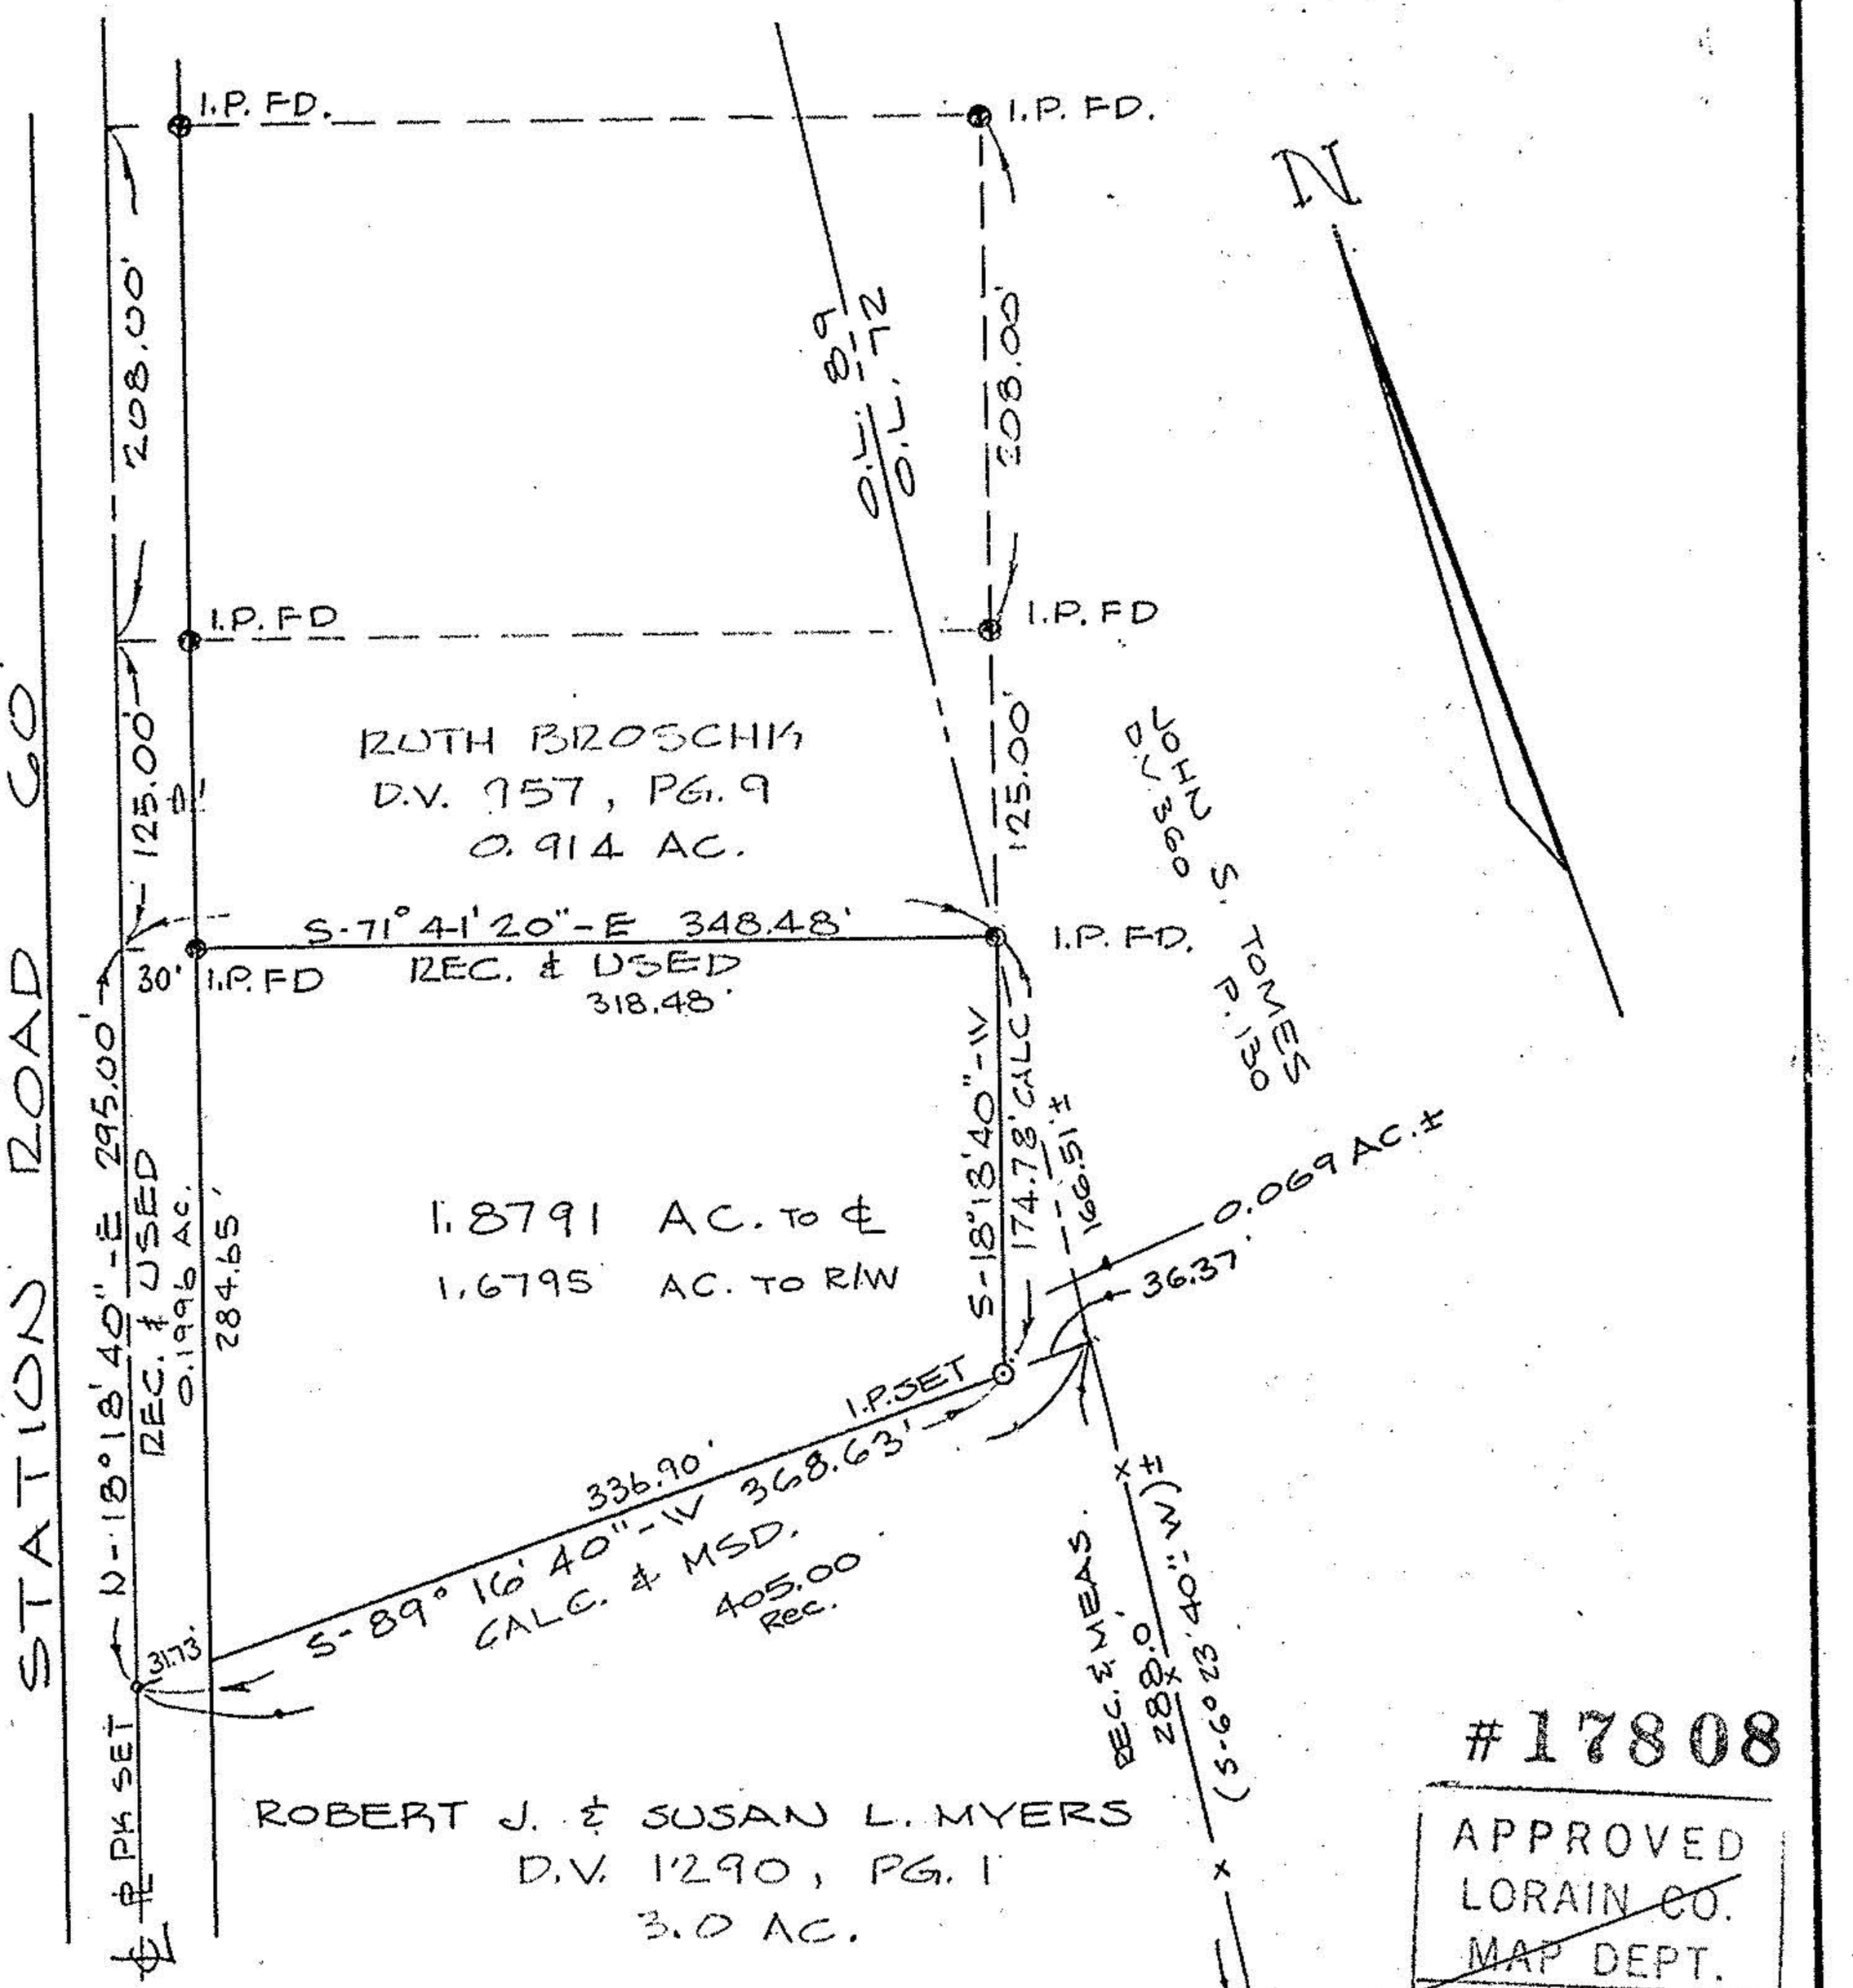

ROBERT J. & SUSAN L. MYERS
D.V. 1290, PG. 1
3.0 AC.

#17808

APPROVED
LORAIN CO.
MAP DEPT.

DATE

PAGE 12-30-87

BY CJ

VOID AFTER 17808

REV. 12-28-87

Prepared for: FRANK FETCHET
26312 AKINS ROAD
COLUMBIA STATION, OHIO 44028

Scale: 1" = 100'	Date: 6-30-86	Dr. by: A.B.	Job № 86-15

12-E 0.L. 72 89