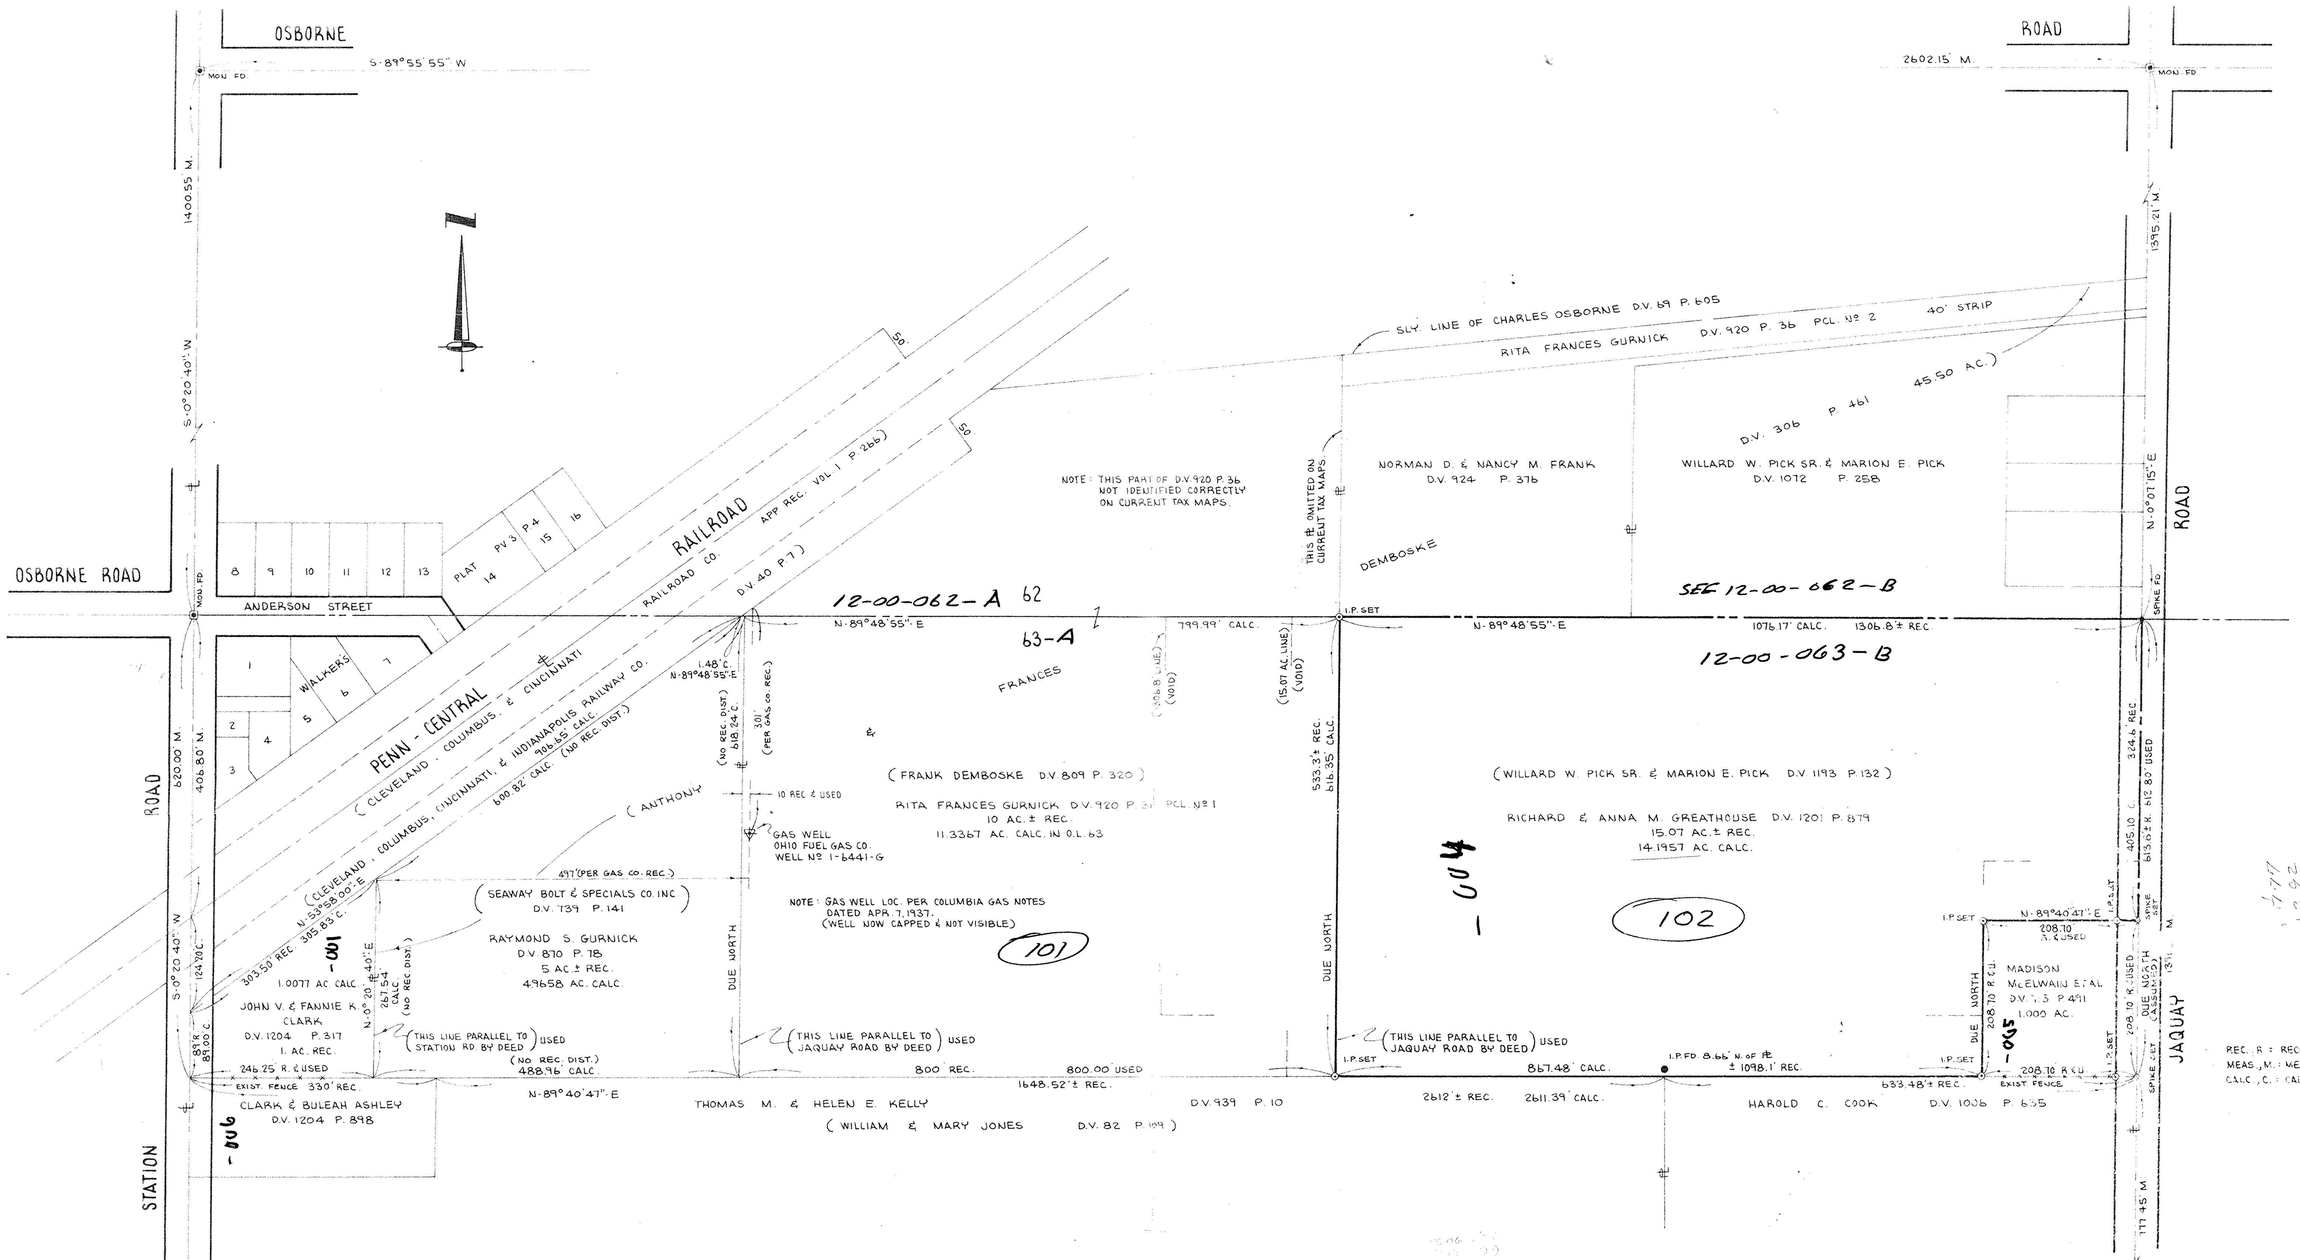

BOUNDARY SURVEY

OF PART OF

COLUMBIA TOWNSHIP ORIGINAL LOT Nº 63

TOWNSHIP OF COLUMBIA — COUNTY OF LORAIN — STATE OF OHIO

SCALE: 1" = 100' — AUG. 1980

PREPARED BY

KLEINOEDER - SCHMIDT & ASSOC.

CONSULTING ENGINEERS & SURVEYORS

#14063
APPROVED LORAIN CO. MAP DEPT.
DATE 2-27-81
PAGE 12-00-063-B
BY T. McHan
VOID AFTER
ACREAGE CORRECTION

#14250
APPROVED LORAIN CO. MAP DEPT.
DATE 6-12-81
PAGE 12-00-062-A & B
BY T. McHan
VOID AFTER

#14251
APPROVED LORAIN CO. MAP DEPT.
DATE 6-12-81
PAGE 12-00-063 A & B
BY T. McHan
VOID AFTER

#17856-A
APPROVED LORAIN CO. MAP DEPT.
DATE 3-1-88
PAGE 12-00-062-B -063-B
BY T. McHan
VOID AFTER

JOB NO. 80-101