

LOT SPLIT AND MAP OF SURVEY FOR PHILIP BREYCHAK

BEING PART OF ORIGINAL COLUMBIA TOWNSHIP
LOT No. 68, IN THE TOWNSHIP OF COLUMBIA, COUNTY
OF LORAIN AND STATE OF OHIO.

PREPARED BY



WHEELER & MELENA, INC.
ENGINEERS • SURVEYORS
6907 BROOKPARK ROAD PARMA, OHIO 44129
TELEPHONE (216) 741-3218
SCALE: 1" = 100' DATE: APRIL 30, 1987




I HEREBY CERTIFY THAT I HAVE SURVEYED THE LAND SHOWN ON THIS PLAN, THAT IT IS A CORRECT REPRESENTATION OF THE LAND SURVEYED AND THAT IRON PINS OR MONUMENTS WERE FOUND OR SET AS SHOWN HEREON.

John E. Dailey
JOHN E. DAILEY REG. SURVEYOR NO. 5151




NOTE! BEARINGS ARE TO AN ASSUMED MERIDIAN AND ARE USED TO DENOTE ANGLES ONLY.

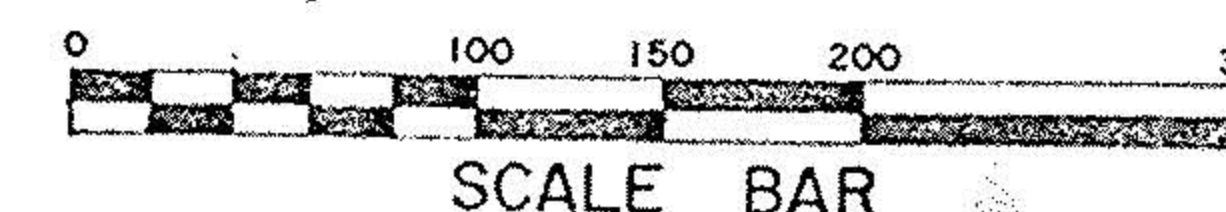

12-00-068-000

#17424

APPROVED	
LORAIN CO.	
MAP DEPT.	
DATE 5-14-87	
PAGE 12-F	
BY C. FRANCIS	
VOID	17424
AFTER	

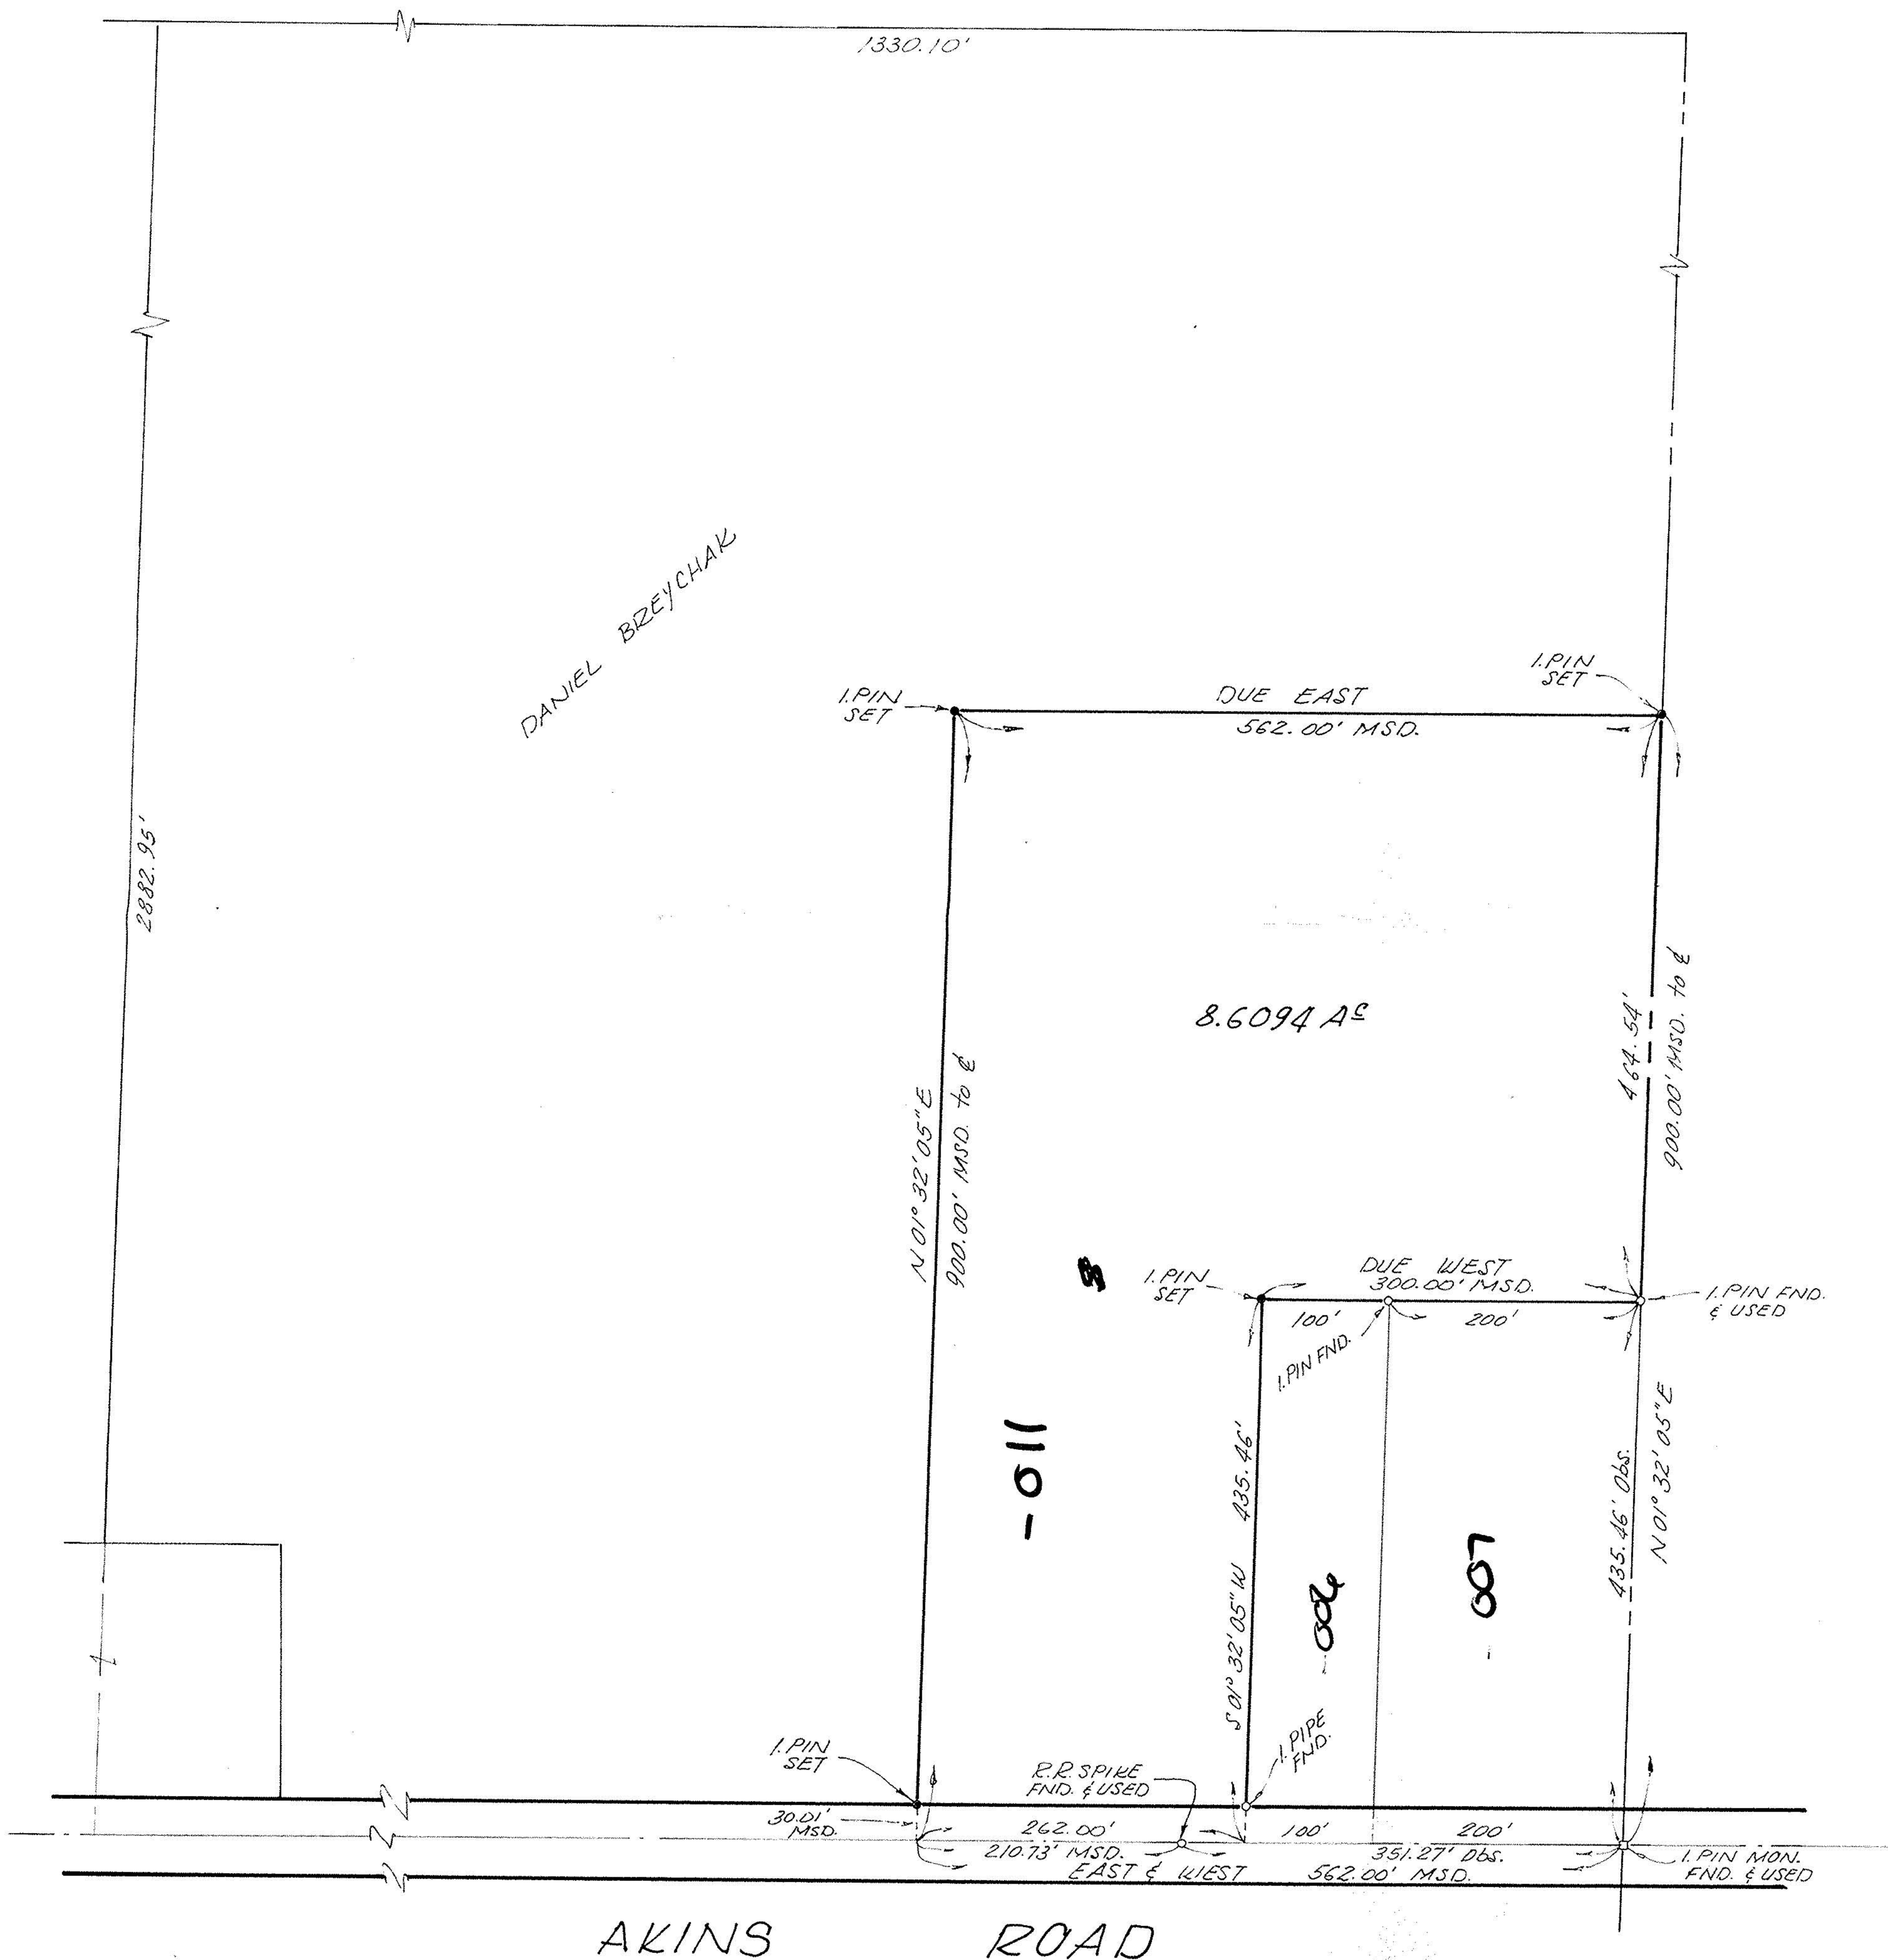

DANIEL BREYCHAK

AKINS ROAD