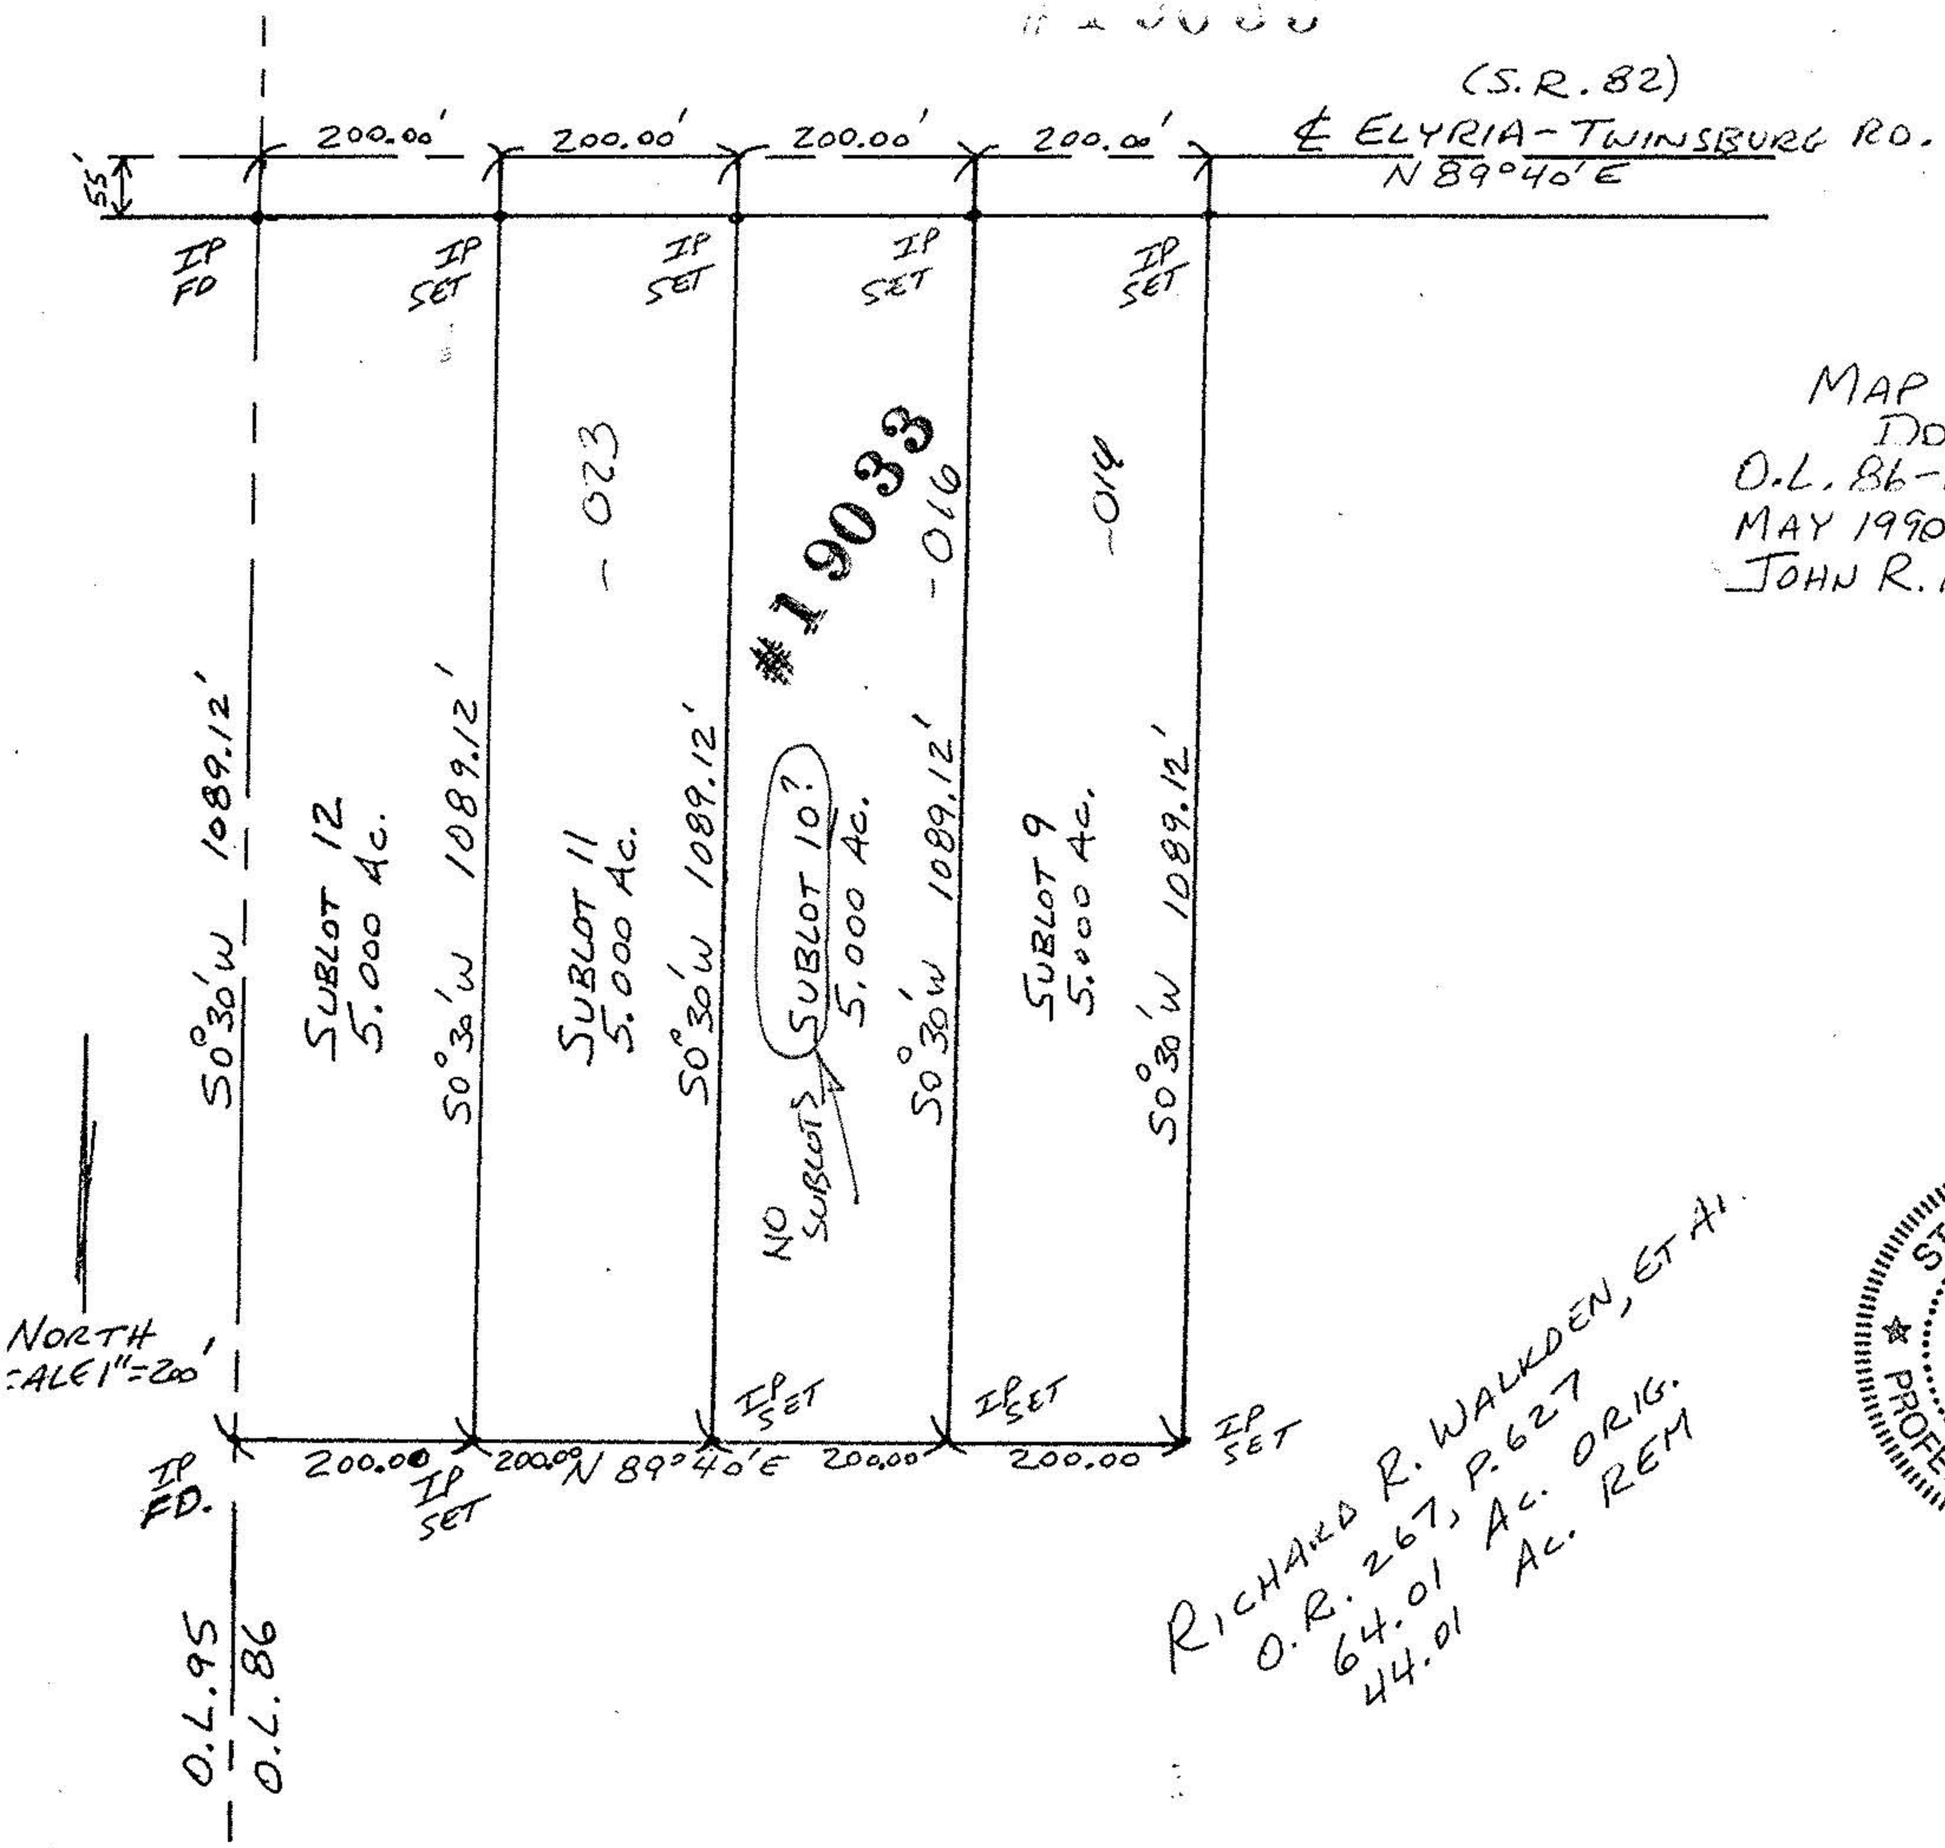

MAP OF SURVEY FOR
DOUG KEYSE
O.L. 86-COLUMBIA TWP.-LORAIN CO.
MAY 1990 SCALE 1"=200'
JOHN R. HAMILTON-REG. SURV. #6861

#19033

APPROVED
LORAIN CO.
MAP DEPT.
DATE 7-9-90
PAGE 12-E
BY CAROLYN FRANCIS
VOID AFTER # 19033

STATE OF OHIO
JOHN R. HAMILTON
6861
REGISTERED
PROFESSIONAL SURVEYOR