


SPRAGUE RD 60'

SHARP
K.D.

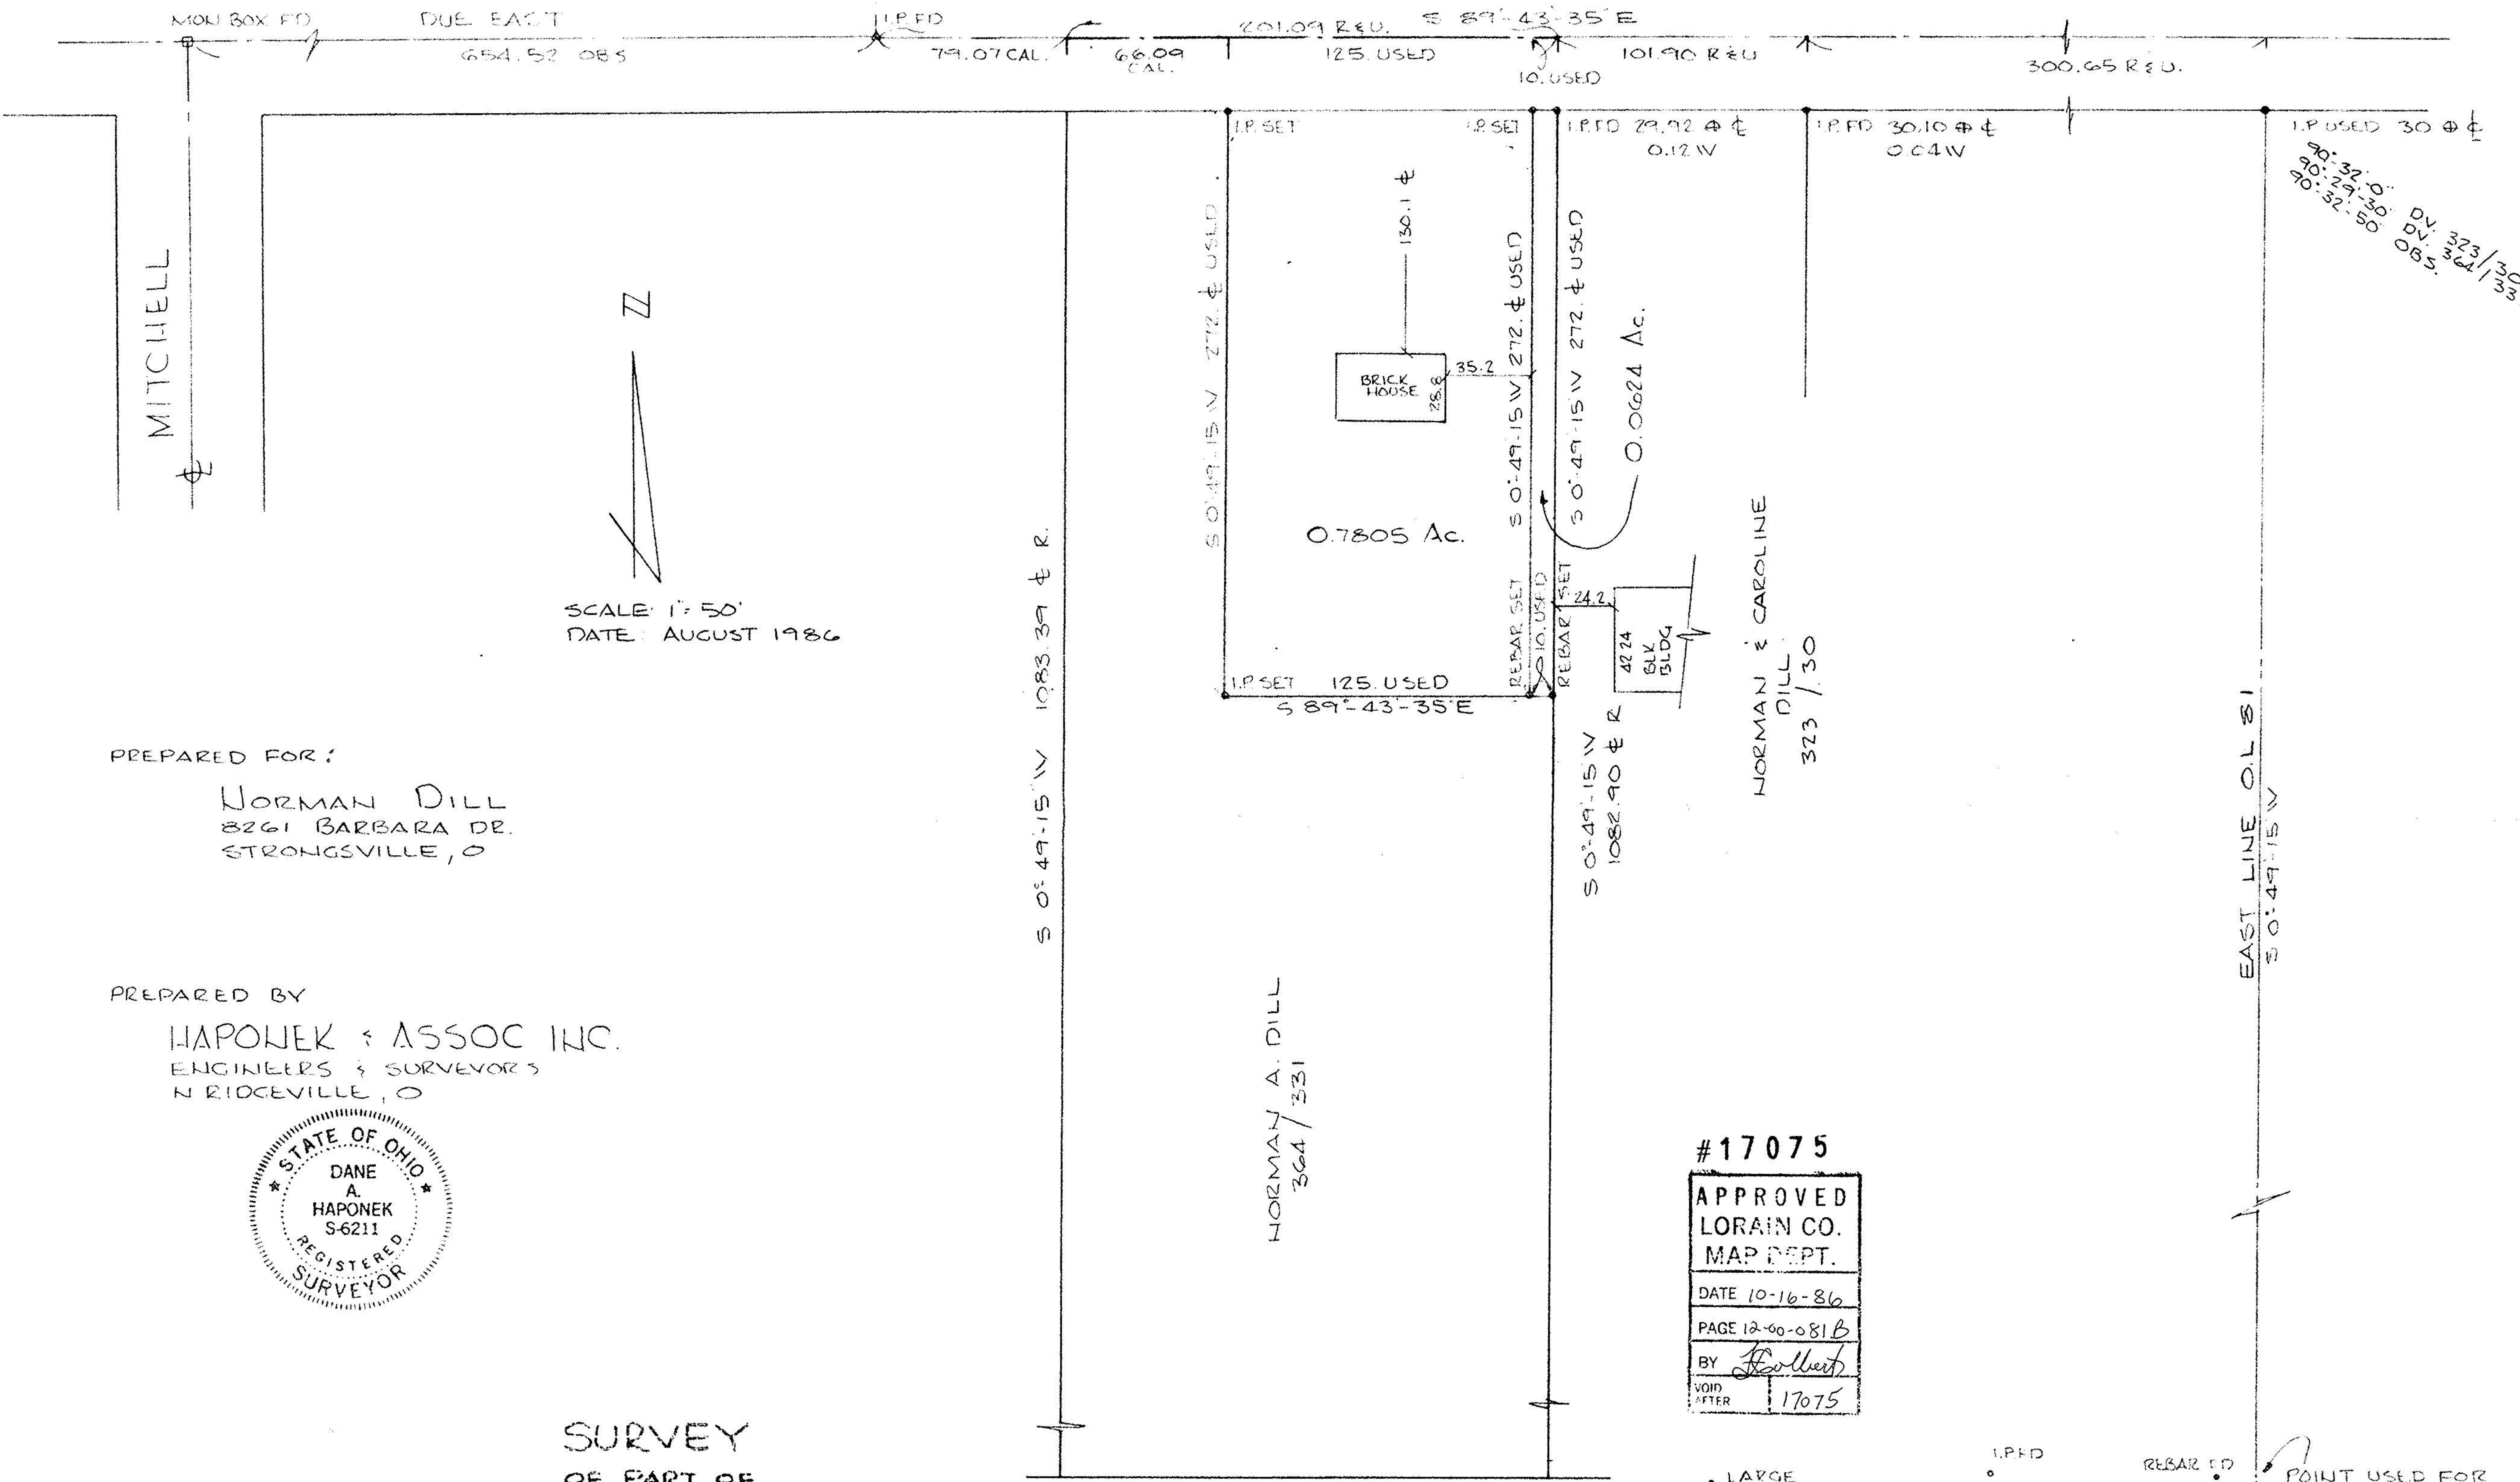

I.P. USED 30 Ø
 90°-32'-0"
 90°-29'-30"
 90°-32'-50"
 DV 323/330
 DV 364/331
 OBS.

SCALE: 1" = 50'
 DATE: AUGUST 1986

PREPARED FOR:

NORMAN DILL
 8261 BARBARA DR.
 STRONGSVILLE, O

PREPARED BY

HAPONEK & ASSOC INC.
 ENGINEERS & SURVEYORS
 N RIDGEVILLE, O



#17075

APPROVED
 LORAIN CO.
 MAP DEPT.
 DATE 10-16-86
 PAGE 12-60-081B
 BY *Hollerbach*
 VOID AFTER 17075

SURVEY
 OF PART OF
 ORIGINAL COLUMBIA TWP.
 LOT NO 81
 COUNTY OF LORAIN STATE OF OHIO

