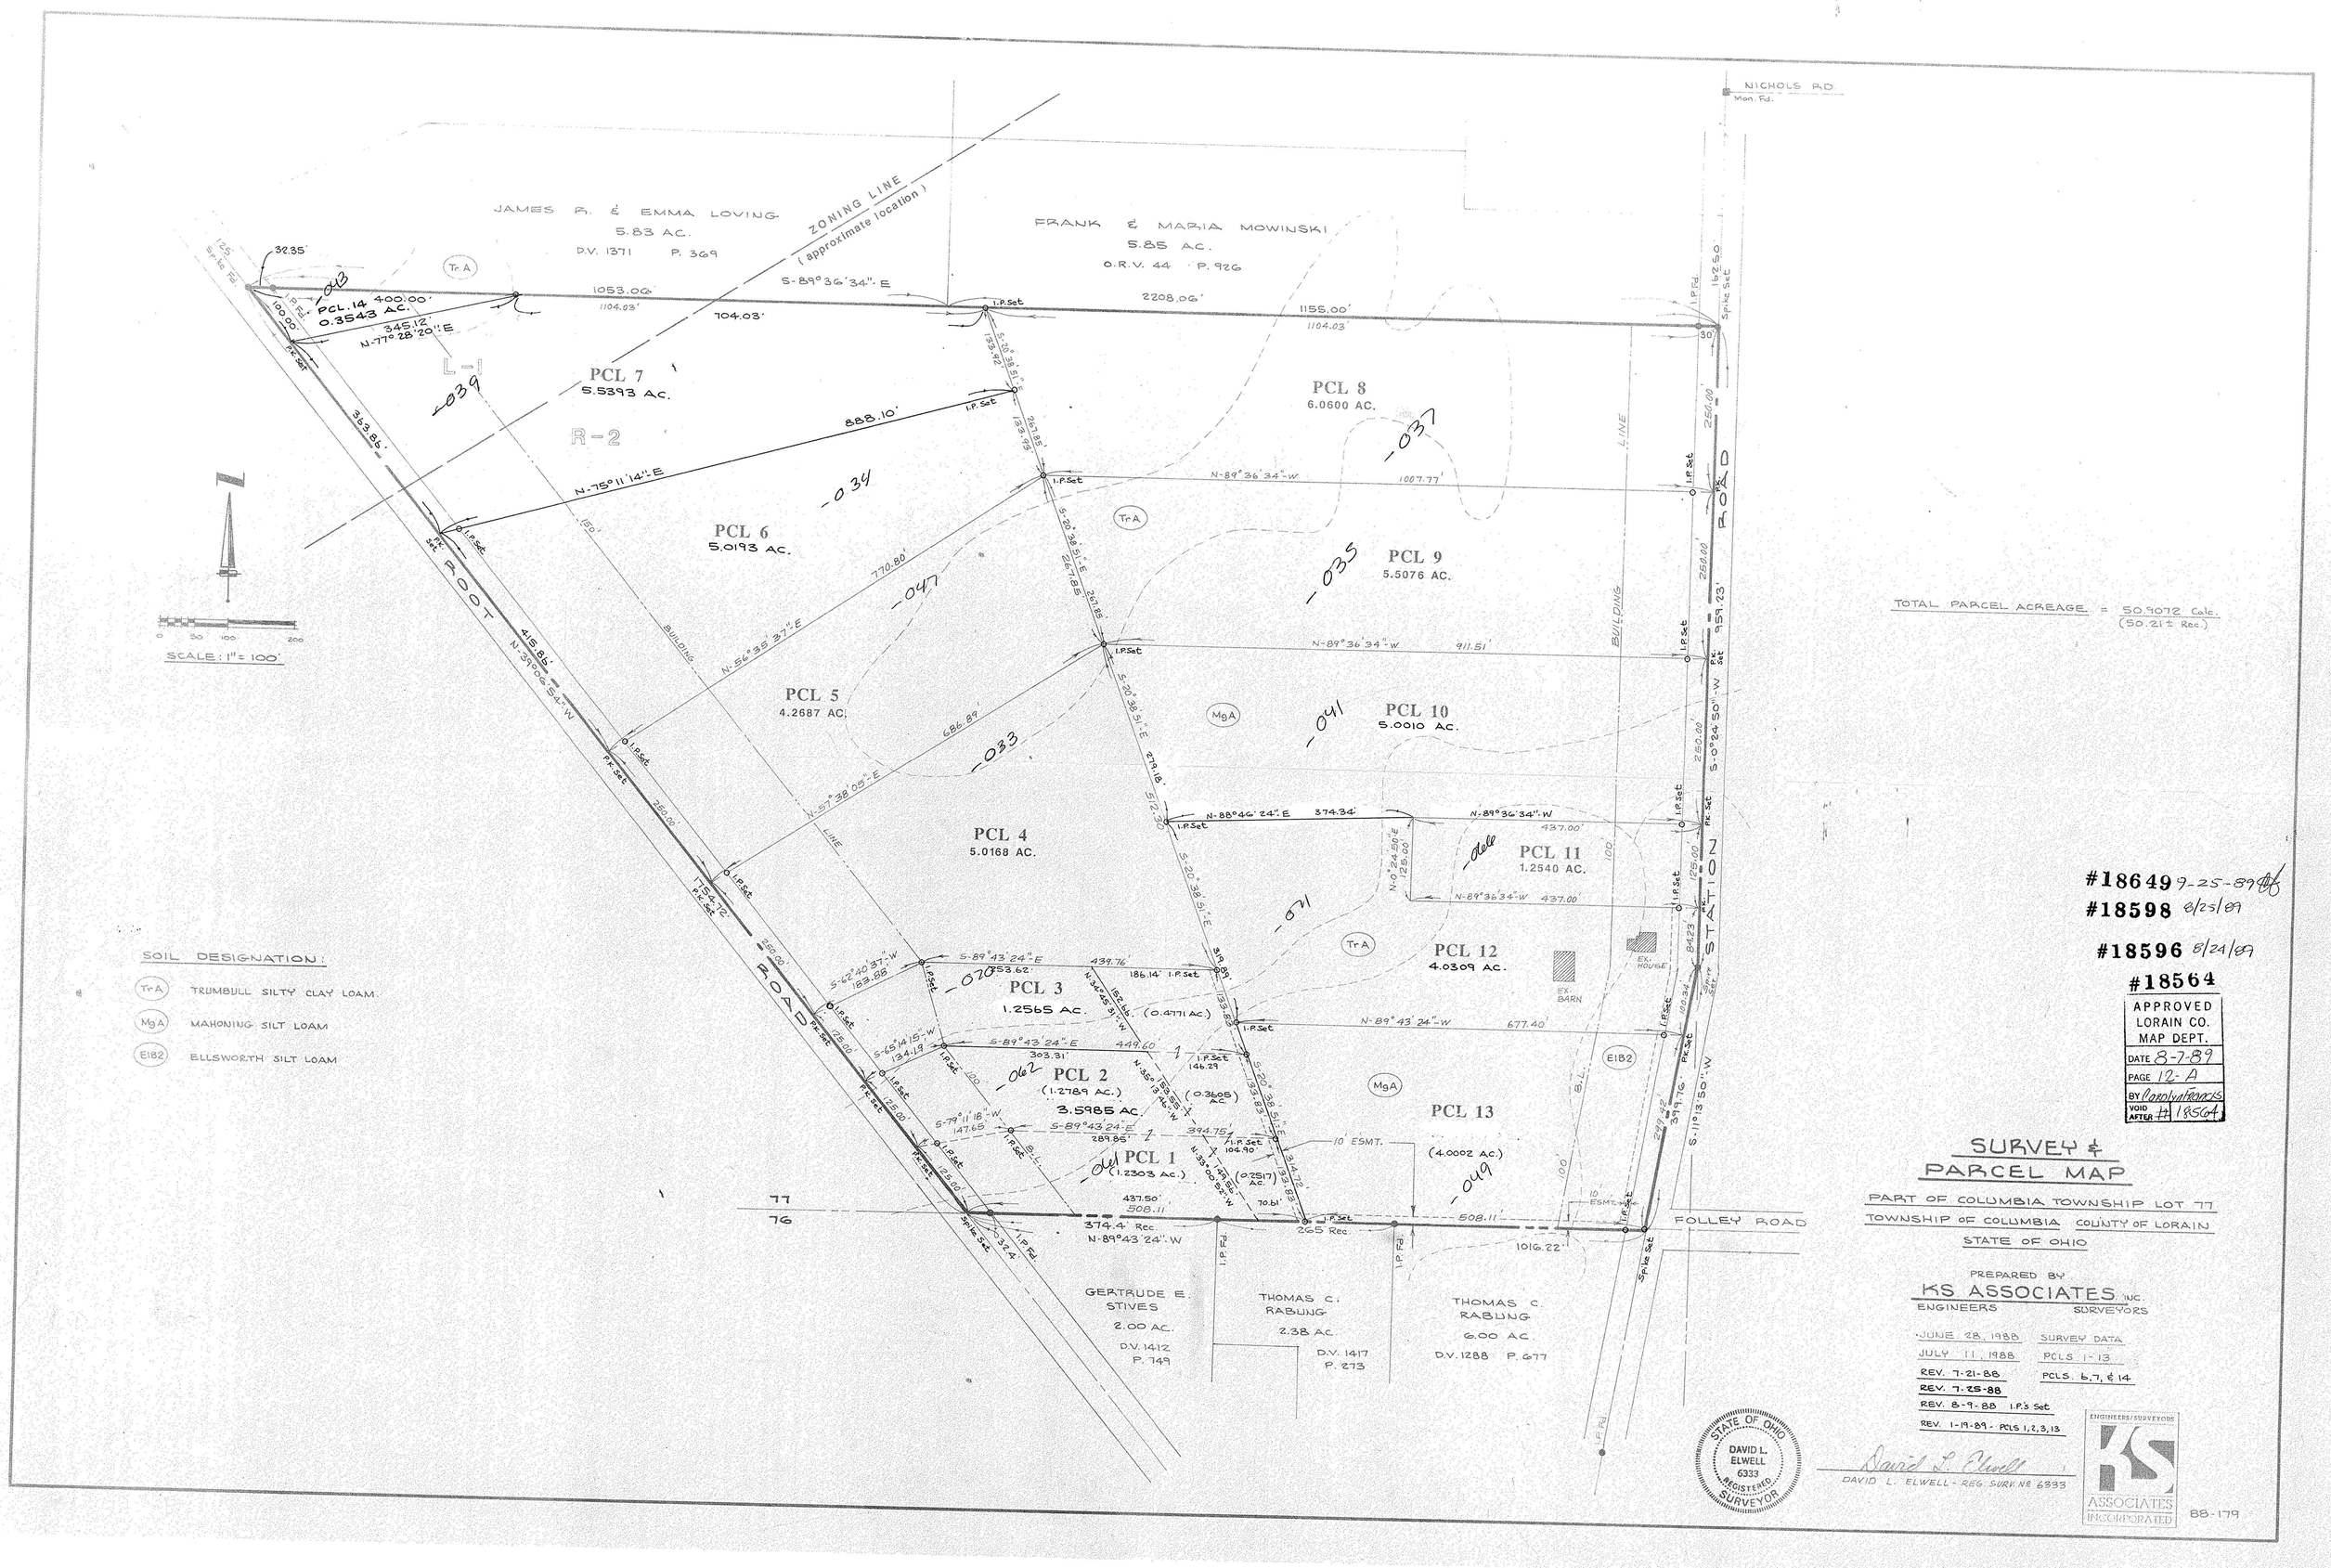
JAMES R. & EMMA LOVING
5.83 AC.
D.V. 1371 P. 369
ZONING LINE
(approximate location)
FRANK & MARIA MOWINSKI
5.85 AC.
O.R.V. 44 P. 926
NICHOLS RD.
Mon. Rd.
PCL. 14 400.00'
0.3543 AC.
PCL 7
5.5393 AC.
R-2
L-1
PCL 8
6.0600 AC.
PCL 6
5.0193 AC.
PCL 9
5.5076 AC.
PCL 5
4.2687 AC.
PCL 10
5.0010 AC.
PCL 4
5.0168 AC.
PCL 11
1.2540 AC.
PCL 12
4.0309 AC.
PCL 3
1.2565 AC.
PCL 2
(1.2789 AC.)
3.5985 AC.
PCL 1
(1.2303 AC.)
PCL 13
(4.0002 AC.)
ROOT ROAD
STATION ROAD
FOLLEY ROAD
BUILDING LINE
TOTAL PARCEL ACREAGE = 50.9072 Calc.
(50.21± Rec.)
SCALE: 1" = 100'
SOIL DESIGNATION:
TrA TRUMBULL SILTY CLAY LOAM.
MgA MAHONING SILT LOAM
EIB2 ELLSWORTH SILT LOAM
GERTRUDE E. STIVES
2.00 AC.
D.V. 1412 P. 749
THOMAS C. RABUNG
2.38 AC.
D.V. 1417 P. 273
THOMAS C. RABUNG
6.00 AC.
D.V. 1288 P. 677
#18649 9-25-89
#18598 8/23/89
#18596 8/24/89
#18564
APPROVED
LORAIN CO.
MAP DEPT.
DATE 8-7-89
PAGE 12-A
BY Carol Francis
VOID AFTER #18564
SURVEY & PARCEL MAP
PART OF COLUMBIA TOWNSHIP LOT 77
TOWNSHIP OF COLUMBIA COUNTY OF LORAIN
STATE OF OHIO
PREPARED BY
KS ASSOCIATES INC.
ENGINEERS SURVEYORS
JUNE 28, 1988 SURVEY DATA
JULY 11, 1988 PCLS 1-13
REV. 7-21-88
REV. 7-25-88 PCLS. 6,7, & 14
REV. 8-9-88 I.P.'s Set
REV. 1-19-89 - PCLS 1,2,3,13
STATE OF OHIO
DAVID L. ELWELL
6333
REGISTERED SURVEYOR
David L. Elwell
DAVID L. ELWELL - REG. SURV. No 6333
ENGINEERS/SURVEYORS
KS ASSOCIATES INCORPORATED
88-179

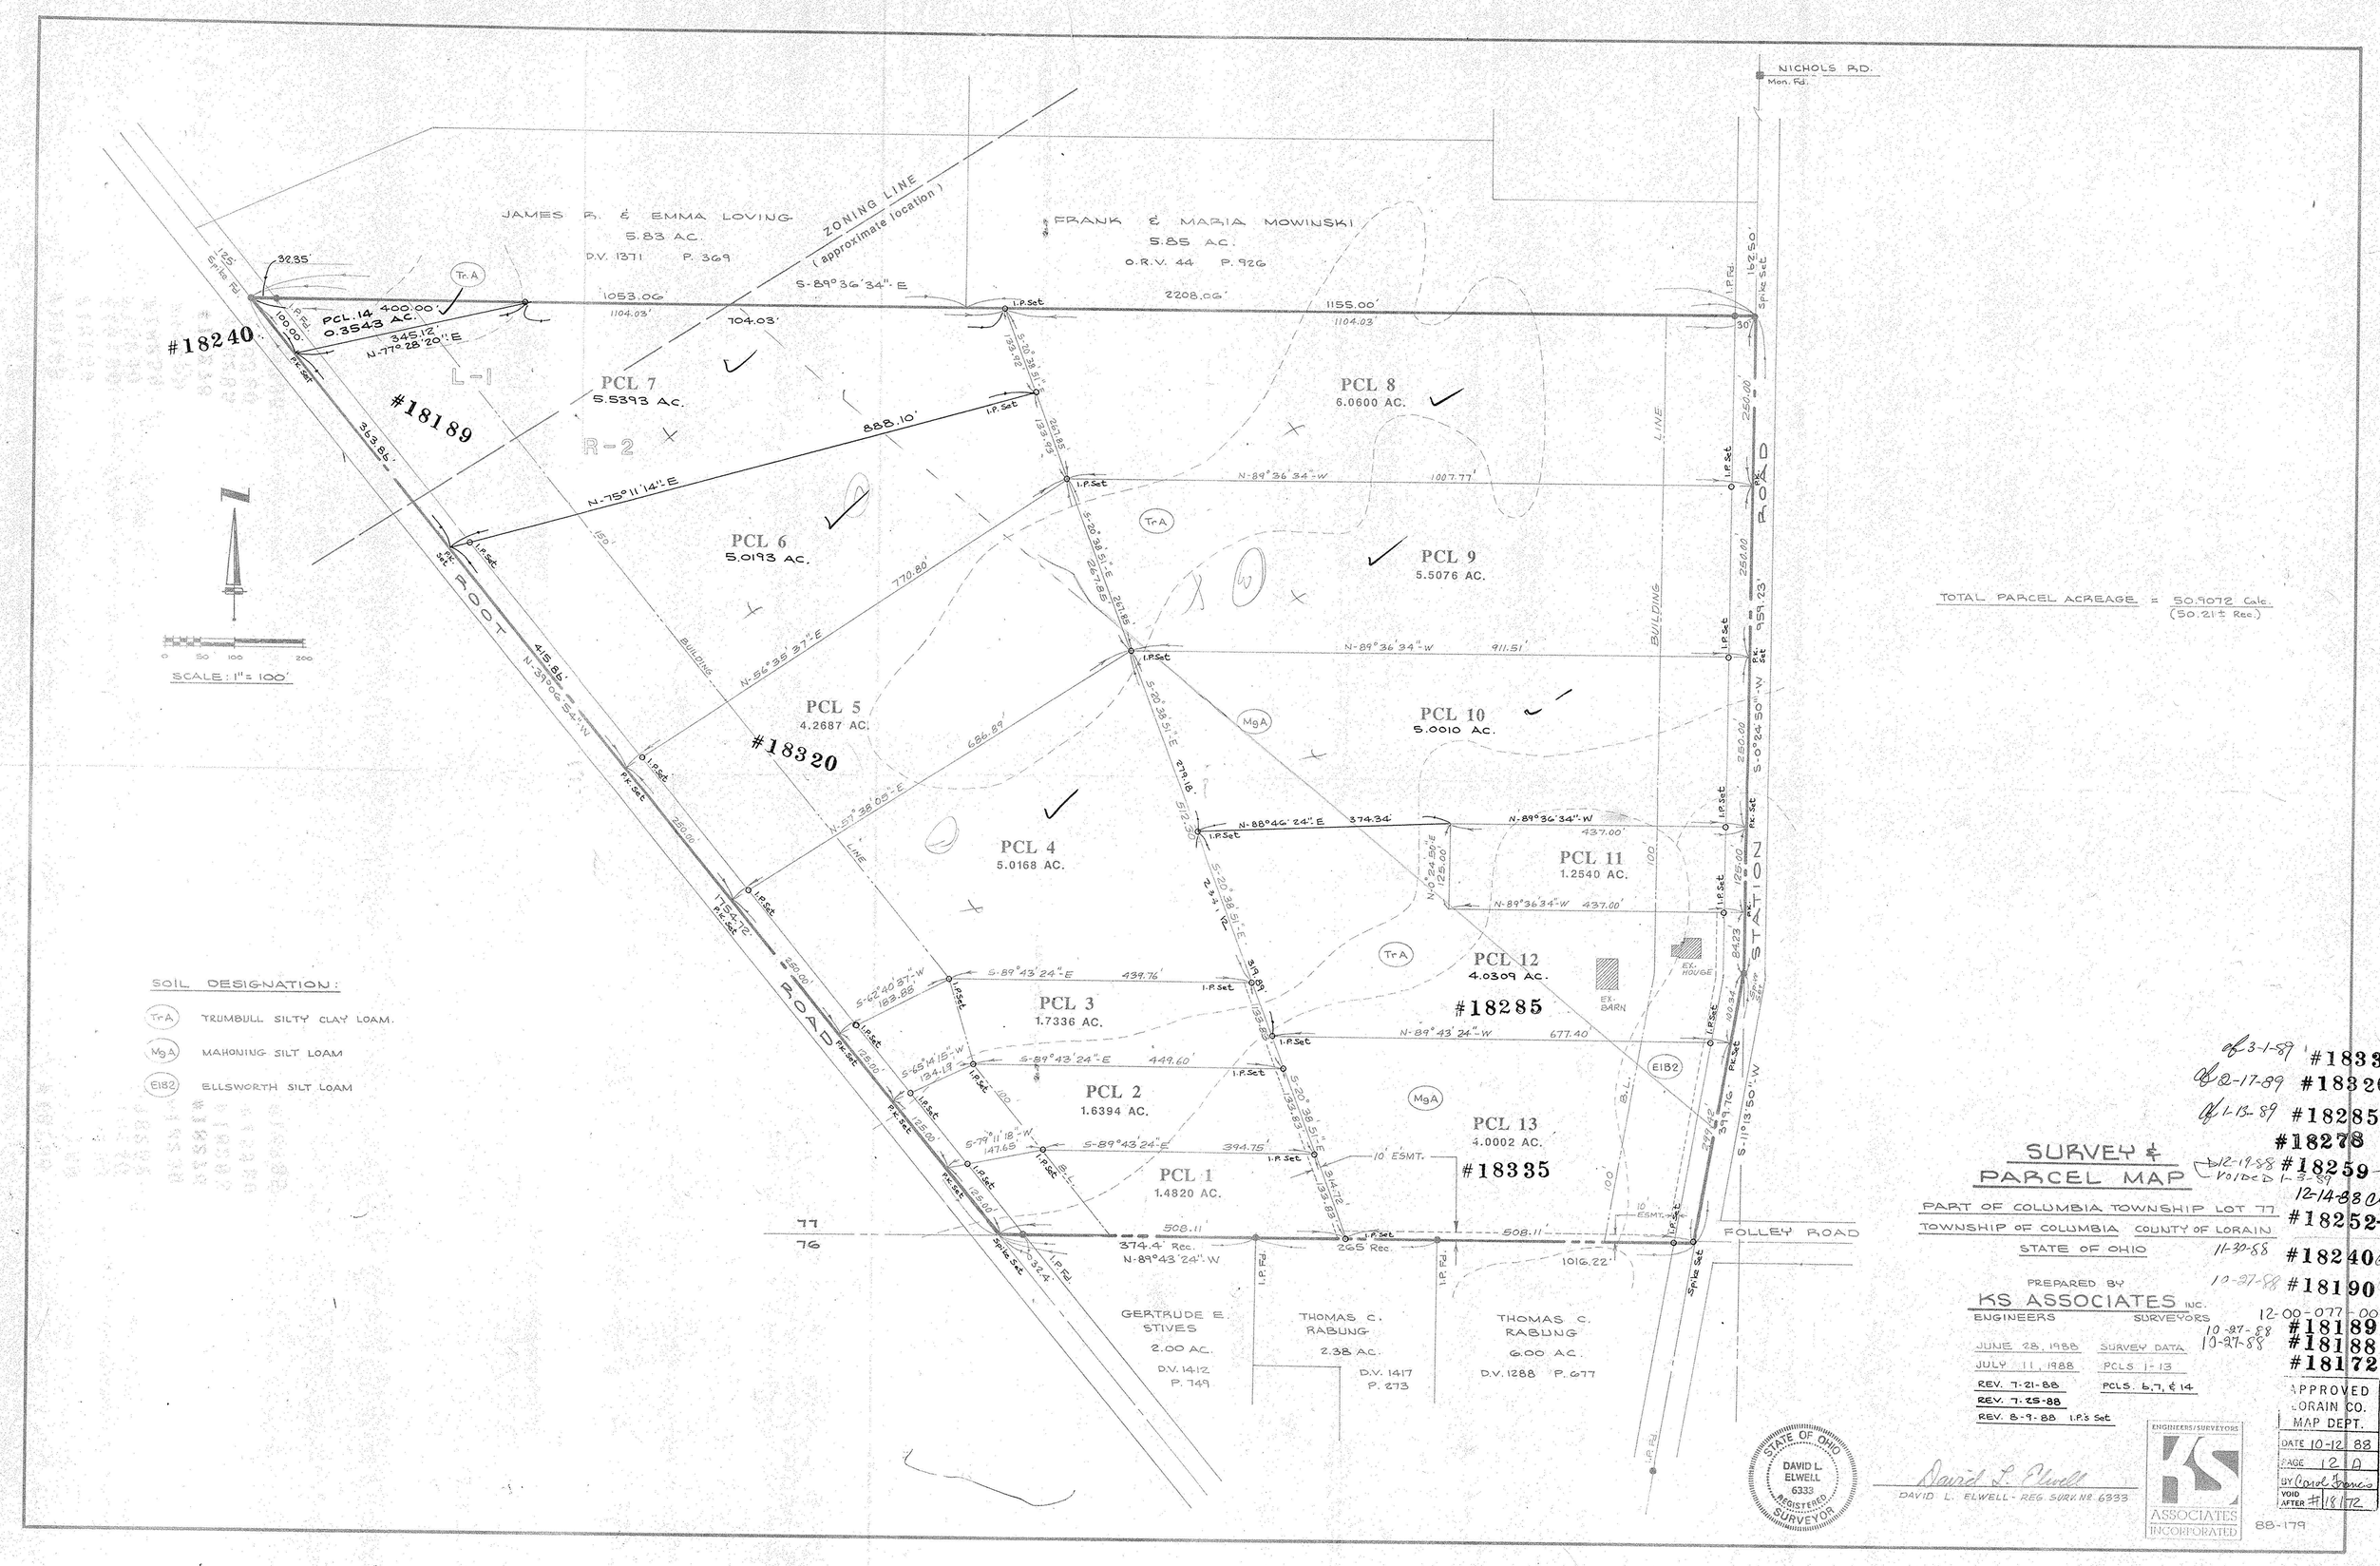
JAMES R. & EMMA LOVING
5.83 AC.
D.V. 1371 P. 369
ZONING LINE
(approximate location)
FRANK & MARIA MOWINSKI
5.85 AC.
O.R.V. 44 P. 926
NICHOLS RD.
Mon. Rd.
PCL. 14 400.00'
0.3543 AC.
#18240
#18189
PCL 7
5.5393 AC.
R-2
L-1
PCL 8
6.0600 AC.
PCL 6
5.0193 AC.
PCL 9
5.5076 AC.
PCL 5
4.2687 AC.
#18320
PCL 10
5.0010 AC.
PCL 4
5.0168 AC.
PCL 11
1.2540 AC.
PCL 12
4.0309 AC.
#18285
PCL 3
1.7336 AC.
PCL 2
1.6394 AC.
PCL 1
1.4820 AC.
PCL 13
4.0002 AC.
#18335
ROOT ROAD
STATION ROAD
FOLLEY ROAD
BUILDING LINE
TOTAL PARCEL ACREAGE = 50.9072 Calc.
(50.21± Rec.)
SCALE: 1" = 100'
SOIL DESIGNATION:
TrA TRUMBULL SILTY CLAY LOAM.
MgA MAHONING SILT LOAM
EIB2 ELLSWORTH SILT LOAM
GERTRUDE E. STIVES
2.00 AC.
D.V. 1412 P. 749
THOMAS C. RABUNG
2.38 AC.
D.V. 1417 P. 273
THOMAS C. RABUNG
6.00 AC.
D.V. 1288 P. 677
3-1-89 #18335
2-17-89 #18320
1-13-89 #18285
#18278
12-19-88 #18259
Void 1-3-89
12-14-88
#18252-A
11-30-88 #18240
10-27-88 #18190
12-00-077-002
10-27-88 #18189
10-27-88 #18188
#18172
APPROVED
LORAIN CO.
MAP DEPT.
DATE 10-12-88
PAGE 12 D
BY Carol Francis
VOID AFTER #18172
SURVEY & PARCEL MAP
PART OF COLUMBIA TOWNSHIP LOT 77
TOWNSHIP OF COLUMBIA COUNTY OF LORAIN
STATE OF OHIO
PREPARED BY
KS ASSOCIATES INC.
ENGINEERS SURVEYORS
JUNE 28, 1988 SURVEY DATA
JULY 11, 1988 PCLS 1-13
REV. 7-21-88
REV. 7-25-88 PCLS. 6,7, & 14
REV. 8-9-88 I.P.'s Set
STATE OF OHIO
DAVID L. ELWELL
6333
REGISTERED SURVEYOR
David L. Elwell
DAVID L. ELWELL - REG. SURV. No 6333
ENGINEERS/SURVEYORS
KS ASSOCIATES INCORPORATED
88-179