


15-00-032-B

15-00-032-104

15-00-032-104

15-00-032-B

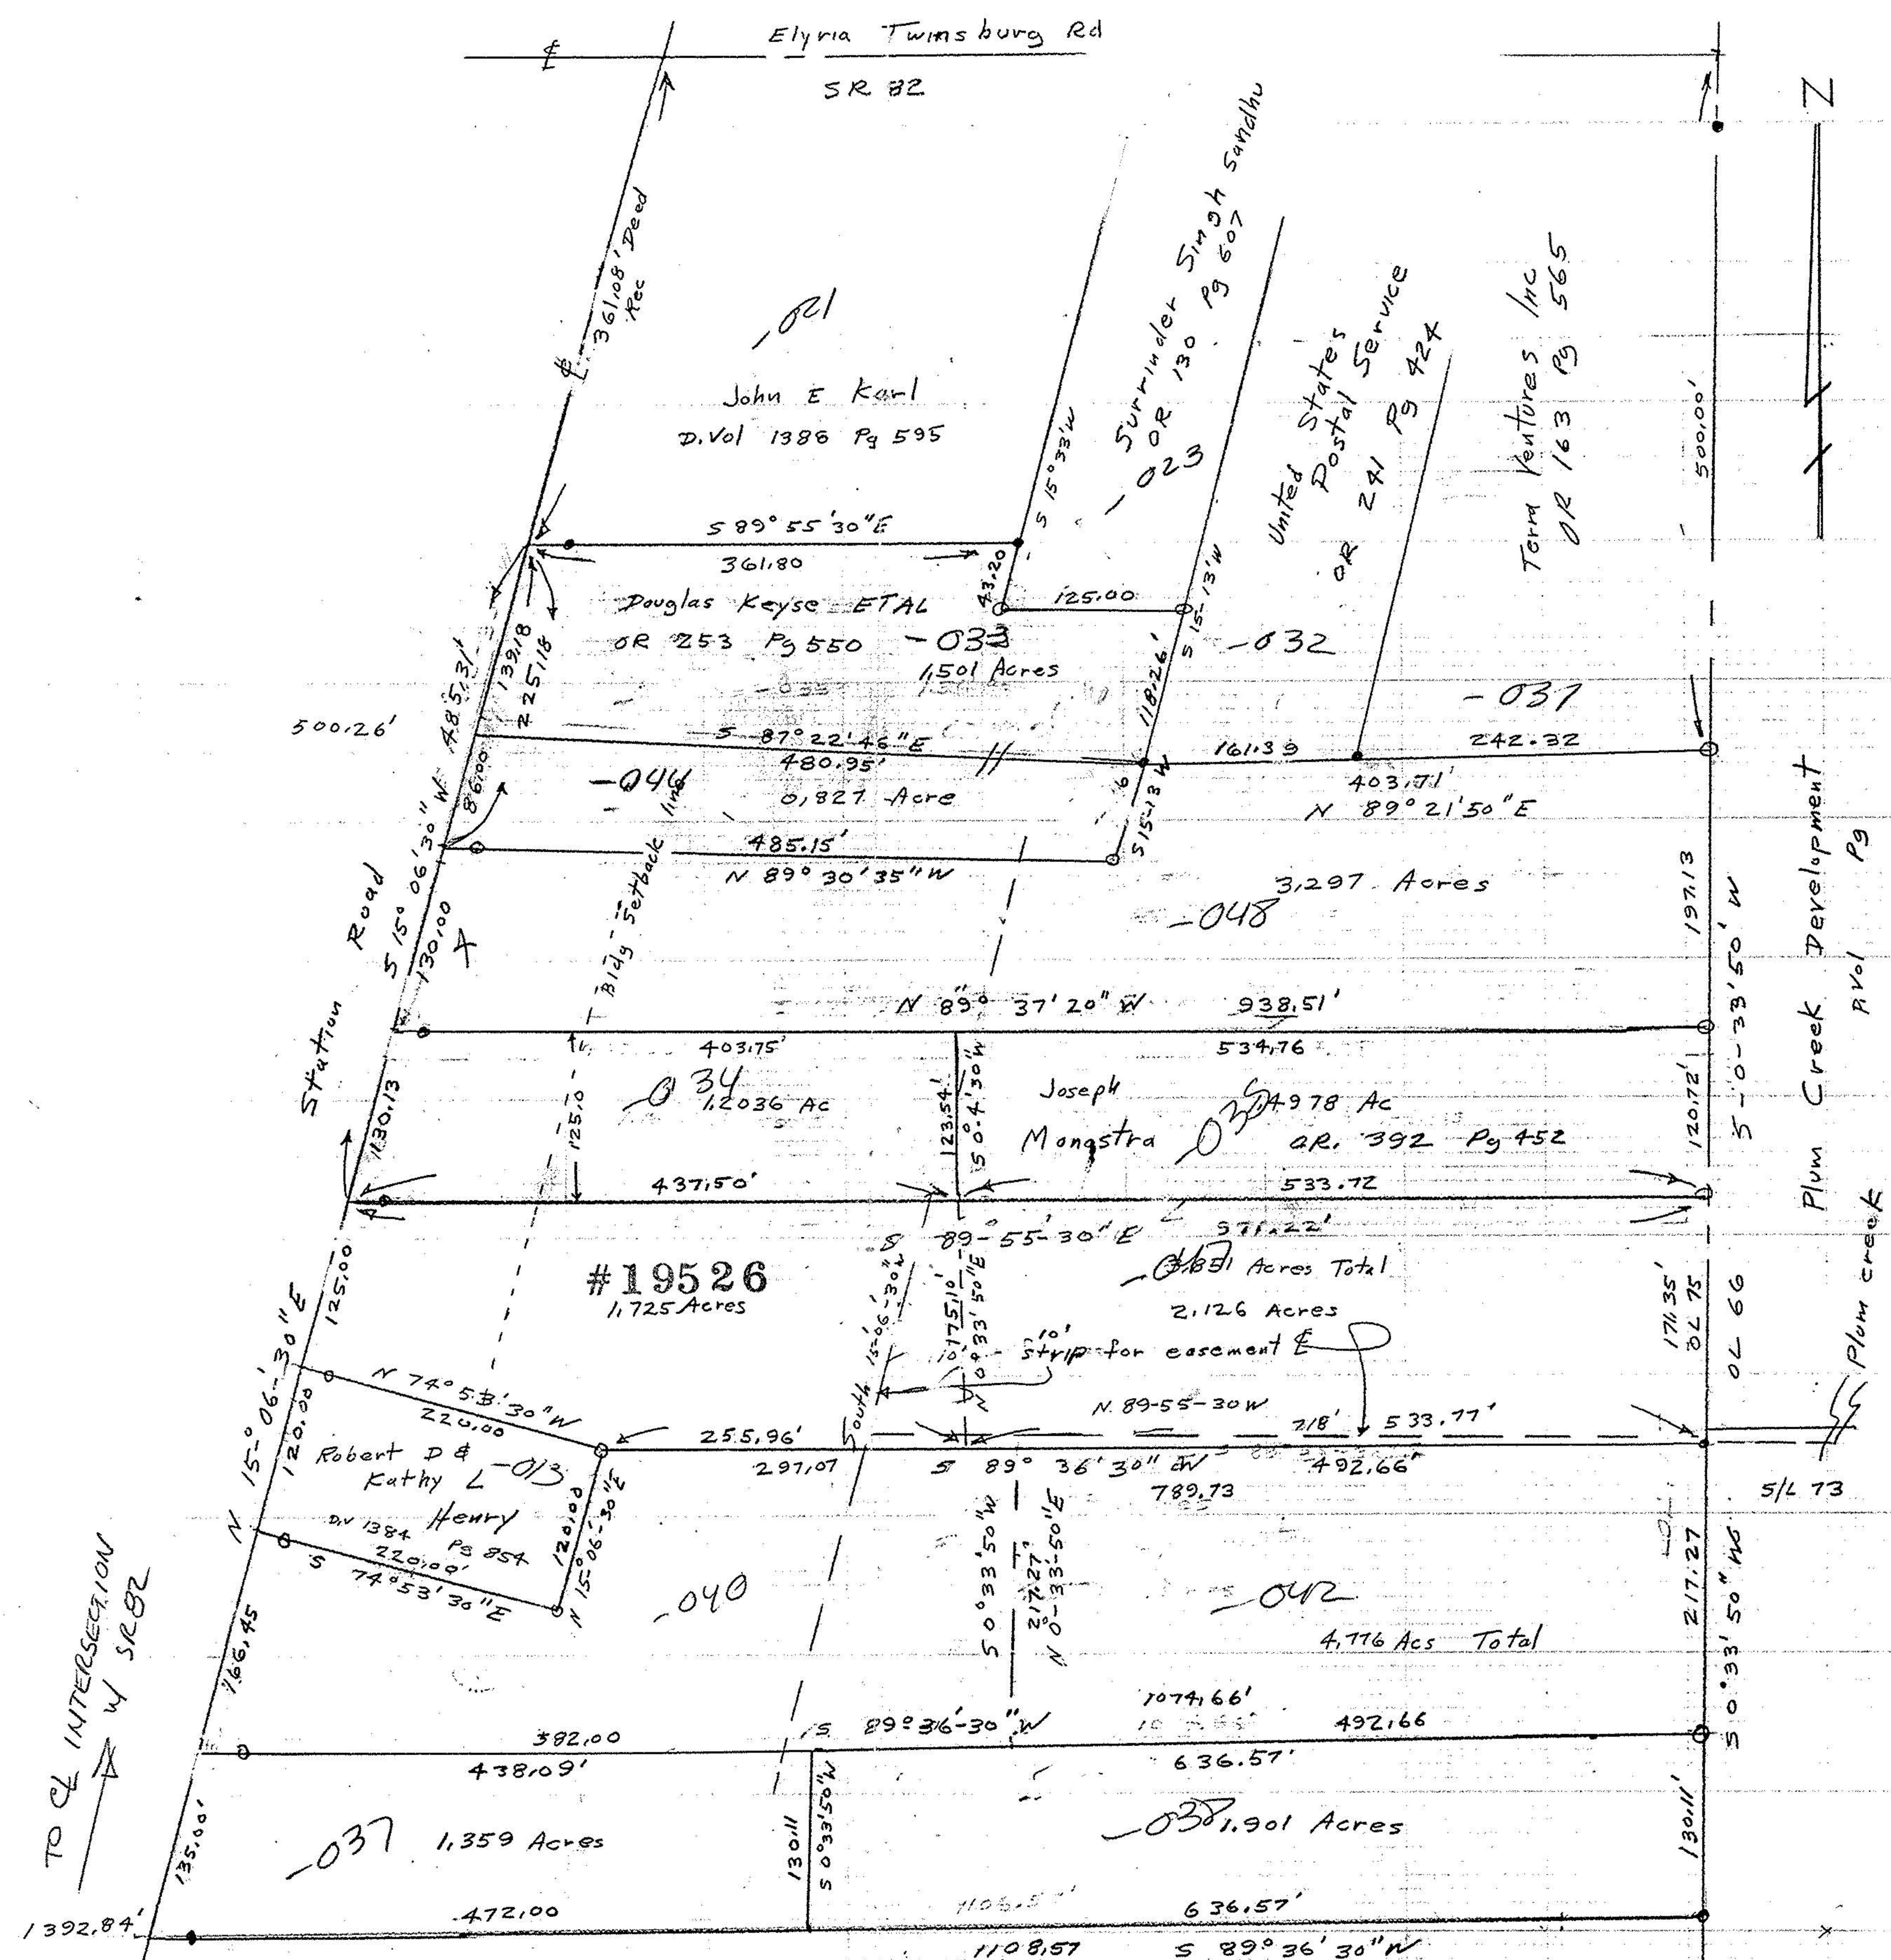

- Iron pipes fd
- Iron pipes set 30' ±

John Pozzural
Reg Surveyor 5292

Survey for Doug Keyse
Part of Original Lot 75
Columbia Township
Loram County Ohio

Scale 1" = 100' Mar 25, 1991 Apr 23, 1991 May 20, 1991
May 3, 1991 May 27, 1991



#19656-A
#19526
#19424
APPROVED
LORAIN CO.
MAP DEPT.
DATE 1/4/91
PAGE 2-00-075-B
BY CAROLYN
VOID
AFTER #19424

8-22-91 C.7