


THE GORDON MILLER SUBDIVISION
 COLUMBIA TOWNSHIP - LORAIN COUNTY - OHIO
 PART OF ORIGINAL COLUMBIA TOWNSHIP LOT NO. 75

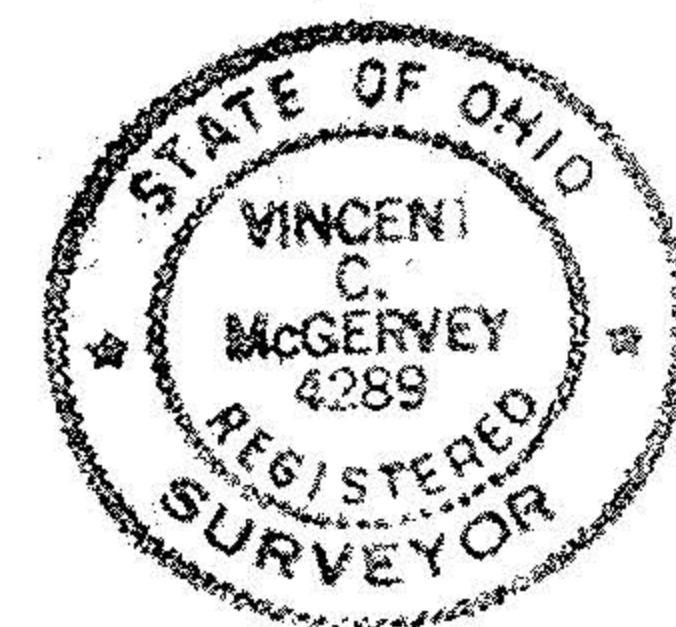


IRON PIN MONUMENTS WERE FOUND OR SET AS SHOWN. DISTANCES ARE IN FEET AND DECIMALS. BEARINGS ARE FOR ANGLE CALC. ONLY. ALL OF WHICH WE CERTIFY TO BE CORRECT.

SCALE: 1" = 60'
 SEPT. 1985
 REVISED OCT. 1985
 SPLIT #1 TO #1A & 1B PROFESSIONAL ENGINEER & SURVEYOR #4289
 Vincent C. McGervey

A.J. & HELEN L. STONKIEWICZ
 VOL. 430-551 12-27-47

1023
 3.00

344.34'
 N 3°-42'-00" E

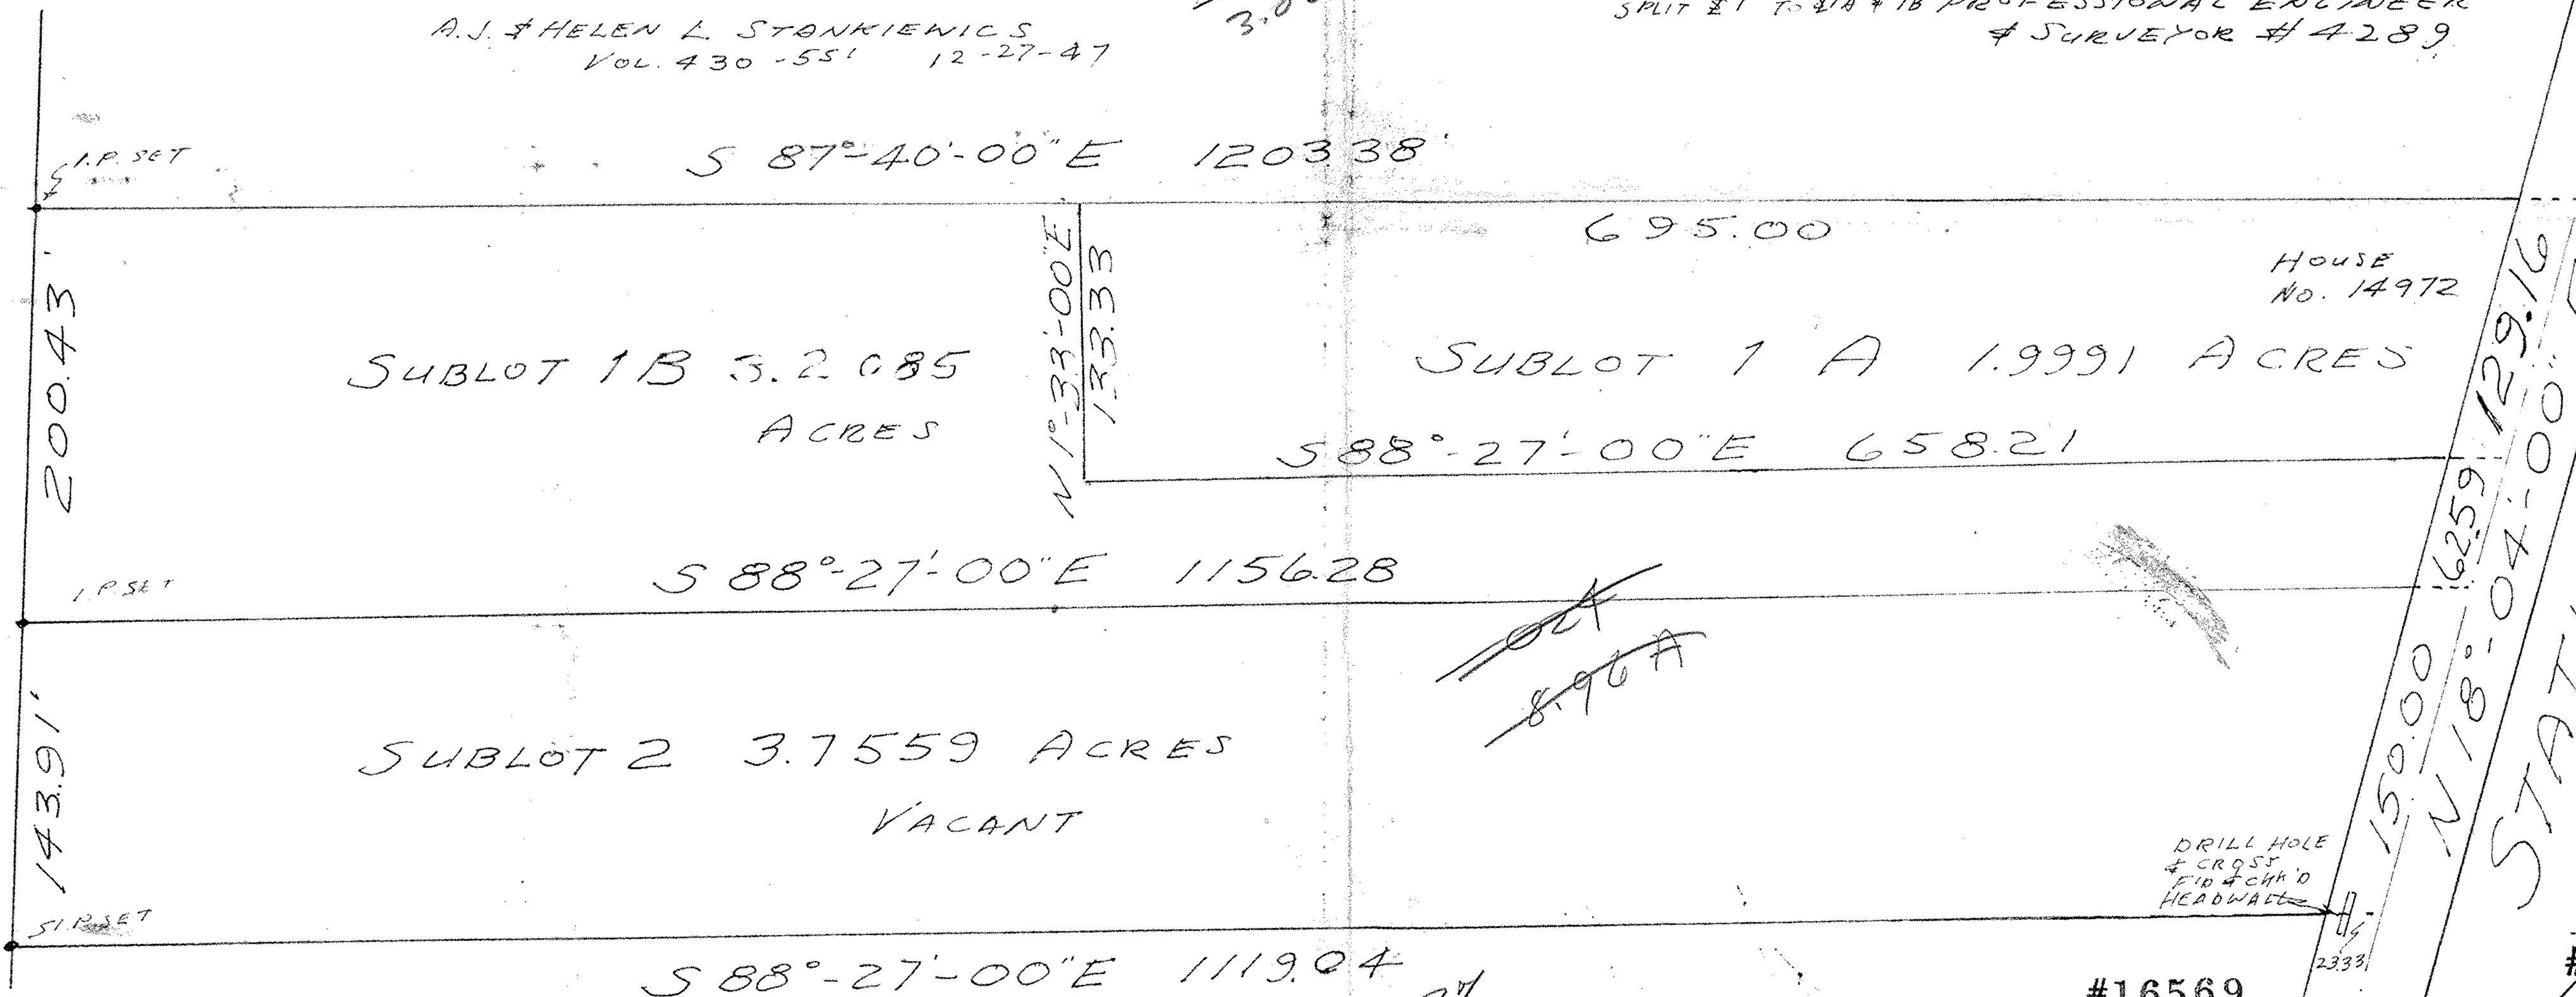

HOUSE
 No. 14972

SUBLOT 1B 3.2085
 ACRES

SUBLOT 1A 1.9991 ACRES

SUBLOT 2 3.7559 ACRES
 VACANT

FRANK & JULIANNE GYARKEY
 VOL. 324-512 5-21-43

1027
 7.044

#16569
 APPROVED
 LORAIN CO.
 MAP DEPT.
 DATE 2-6-86
 PAGE 12.00.075-A
 BY T. McMain

#16464

APPROVED
 LORAIN CO.
 MAP DEPT.
 DATE 11-14-85
 PAGE 12.00.075-A
 BY T. McMain