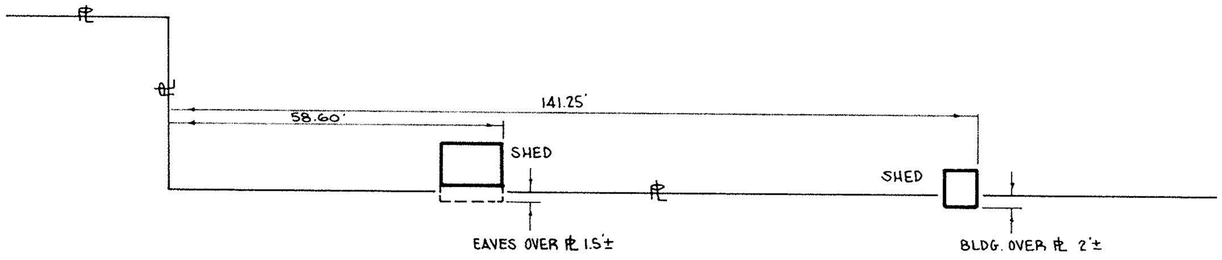

ENCROACHMENT DETAIL AT NORTH PROPERTY LINE SCALE: 1" = 20'

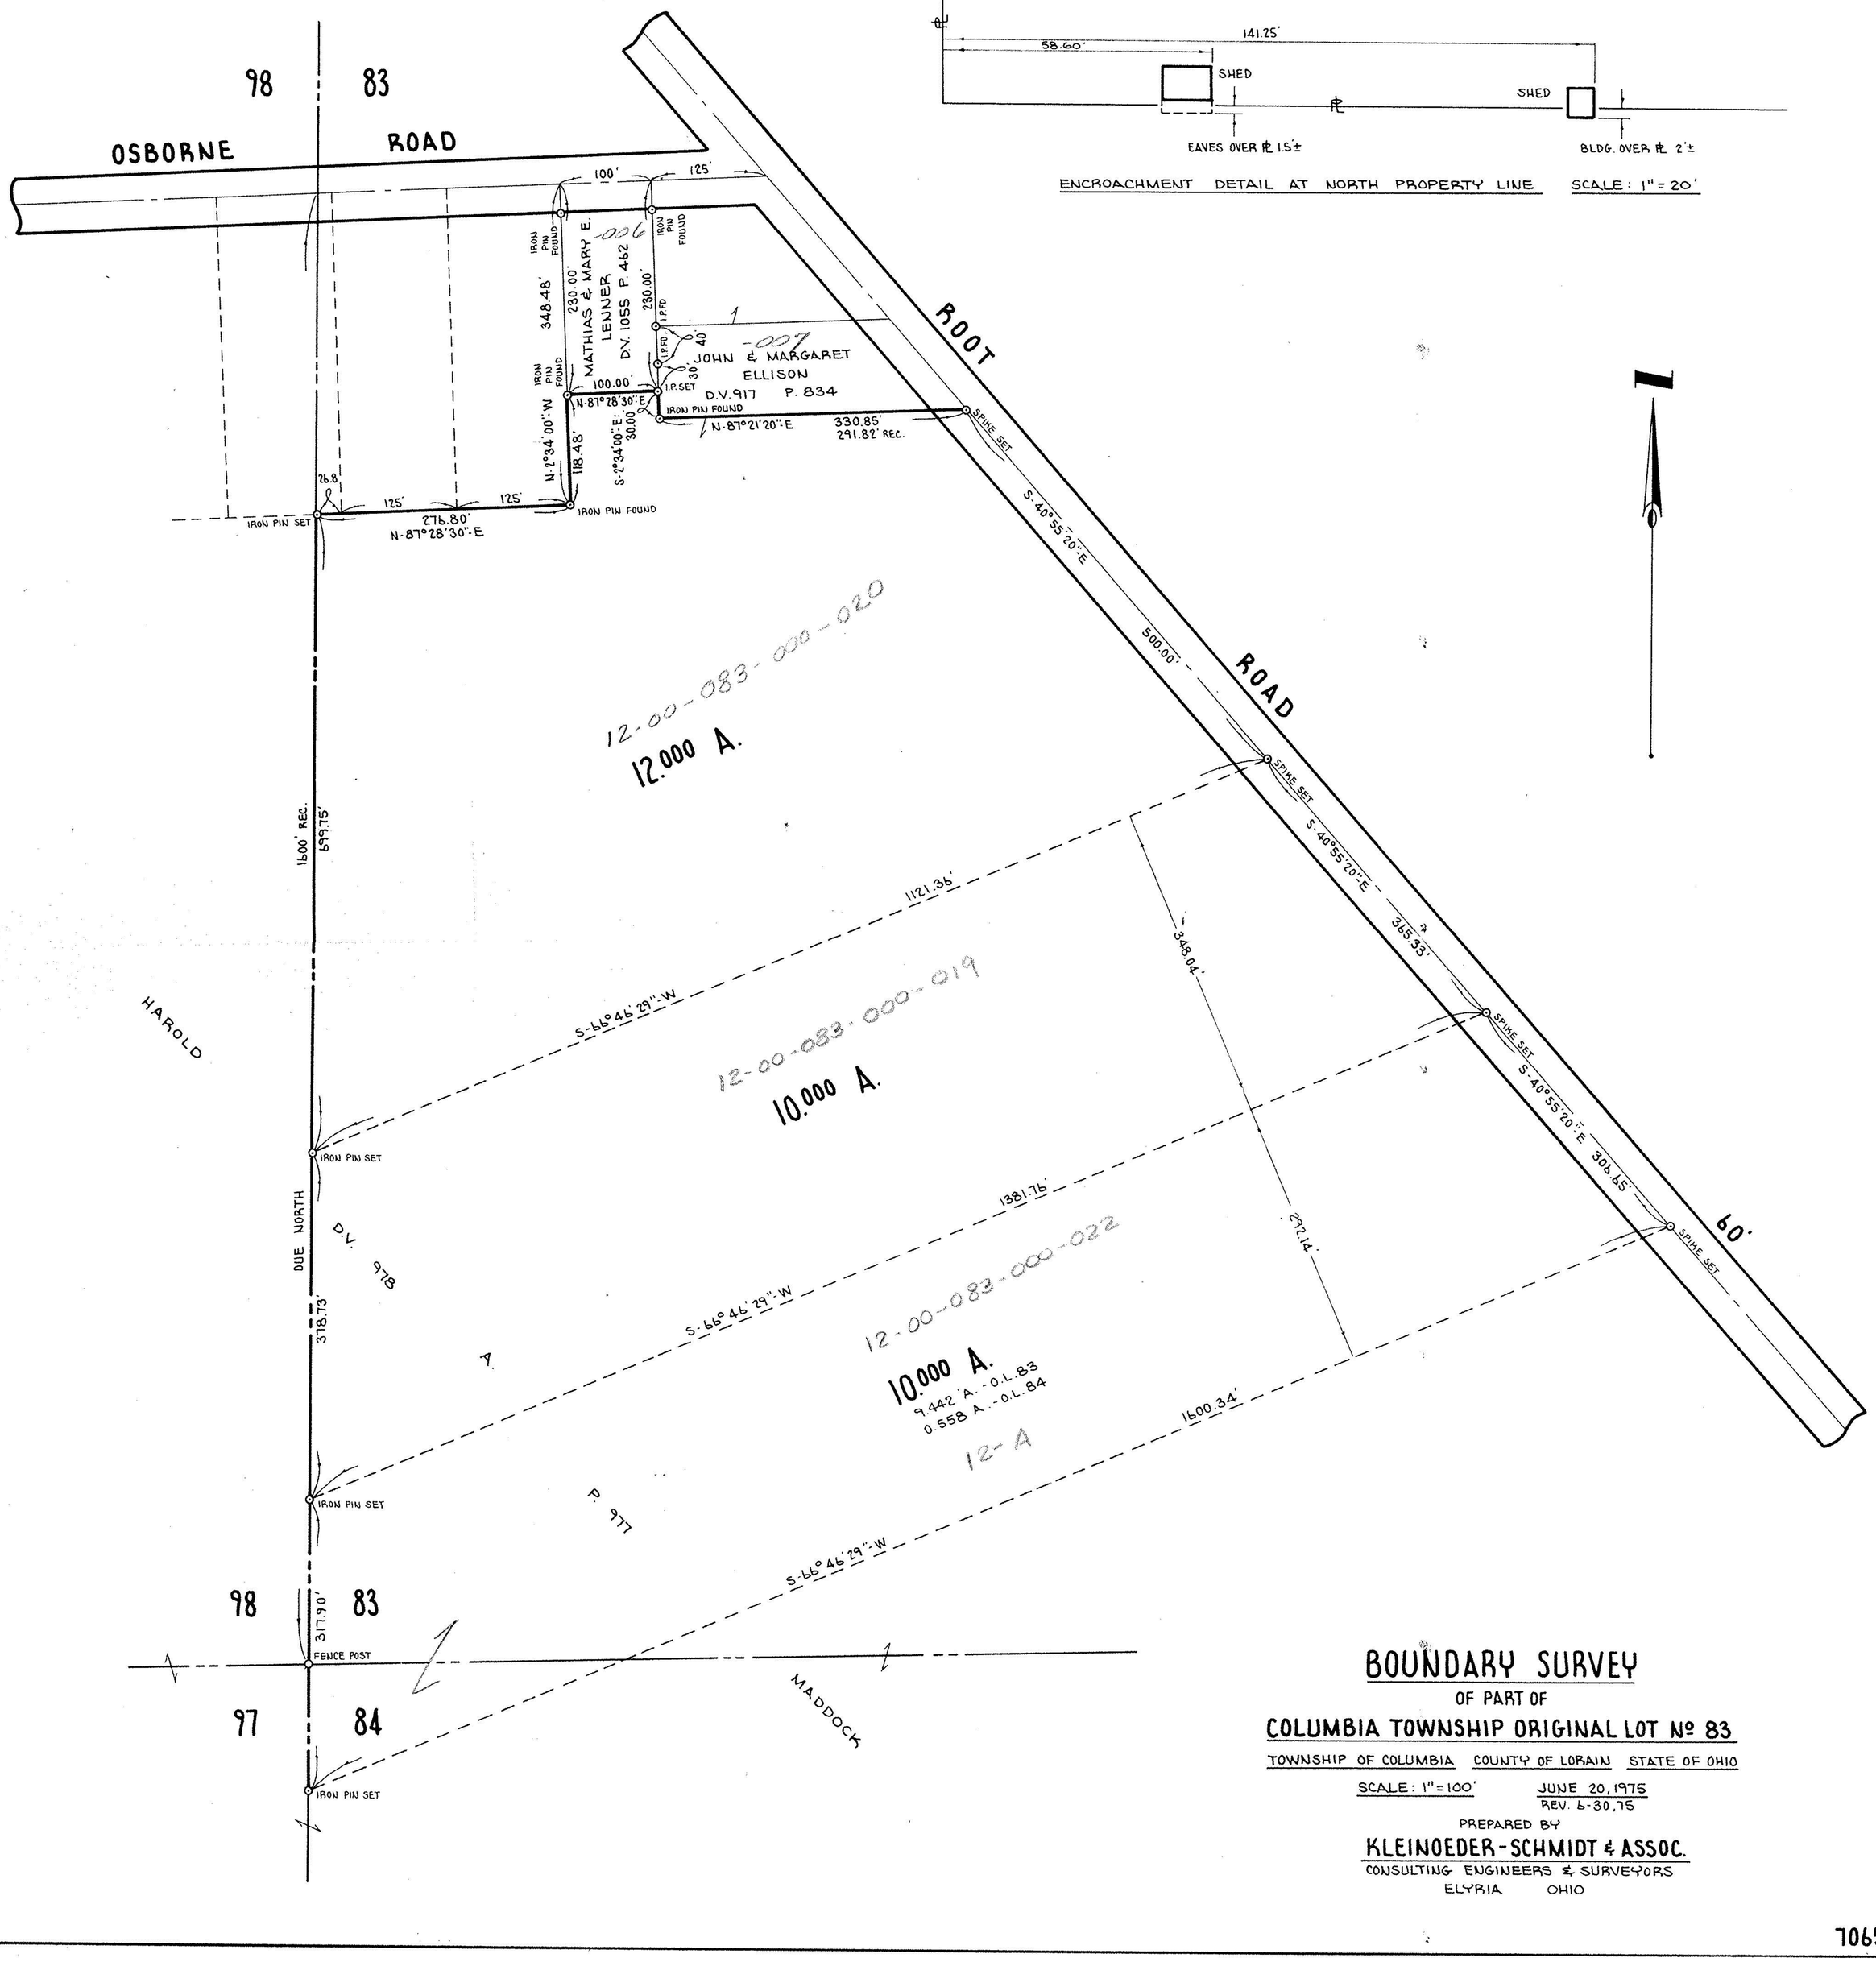

BOUNDARY SURVEY

OF PART OF

COLUMBIA TOWNSHIP ORIGINAL LOT Nº 83

TOWNSHIP OF COLUMBIA COUNTY OF LORAIN STATE OF OHIO

SCALE: 1" = 100' JUNE 20, 1975
REV. 6-30, 75

PREPARED BY

KLEINOEDER-SCHMIDT & ASSOC.

CONSULTING ENGINEERS & SURVEYORS
ELYRIA OHIO

7065