


Kimberly Plaza, 106 Middle Avenue
(on "The Square"), Elyria, Ohio 44035
Ph: (216) 322-4455 or (216) 233-7126

SURVEY FOR:

JAMES R. & JANET M. HART

Orig. Lot 83	City of	Date JAN. '91 Scale 1"=100'
Orig. Sec	Village of	Dwn. by R.G.S. Chkd. by
Tract	County of LORAIN	Job No. CE 90-040 F.B.
Township of COLUMBIA	State of OHIO	Printed

#19305
12-6-83
12-A

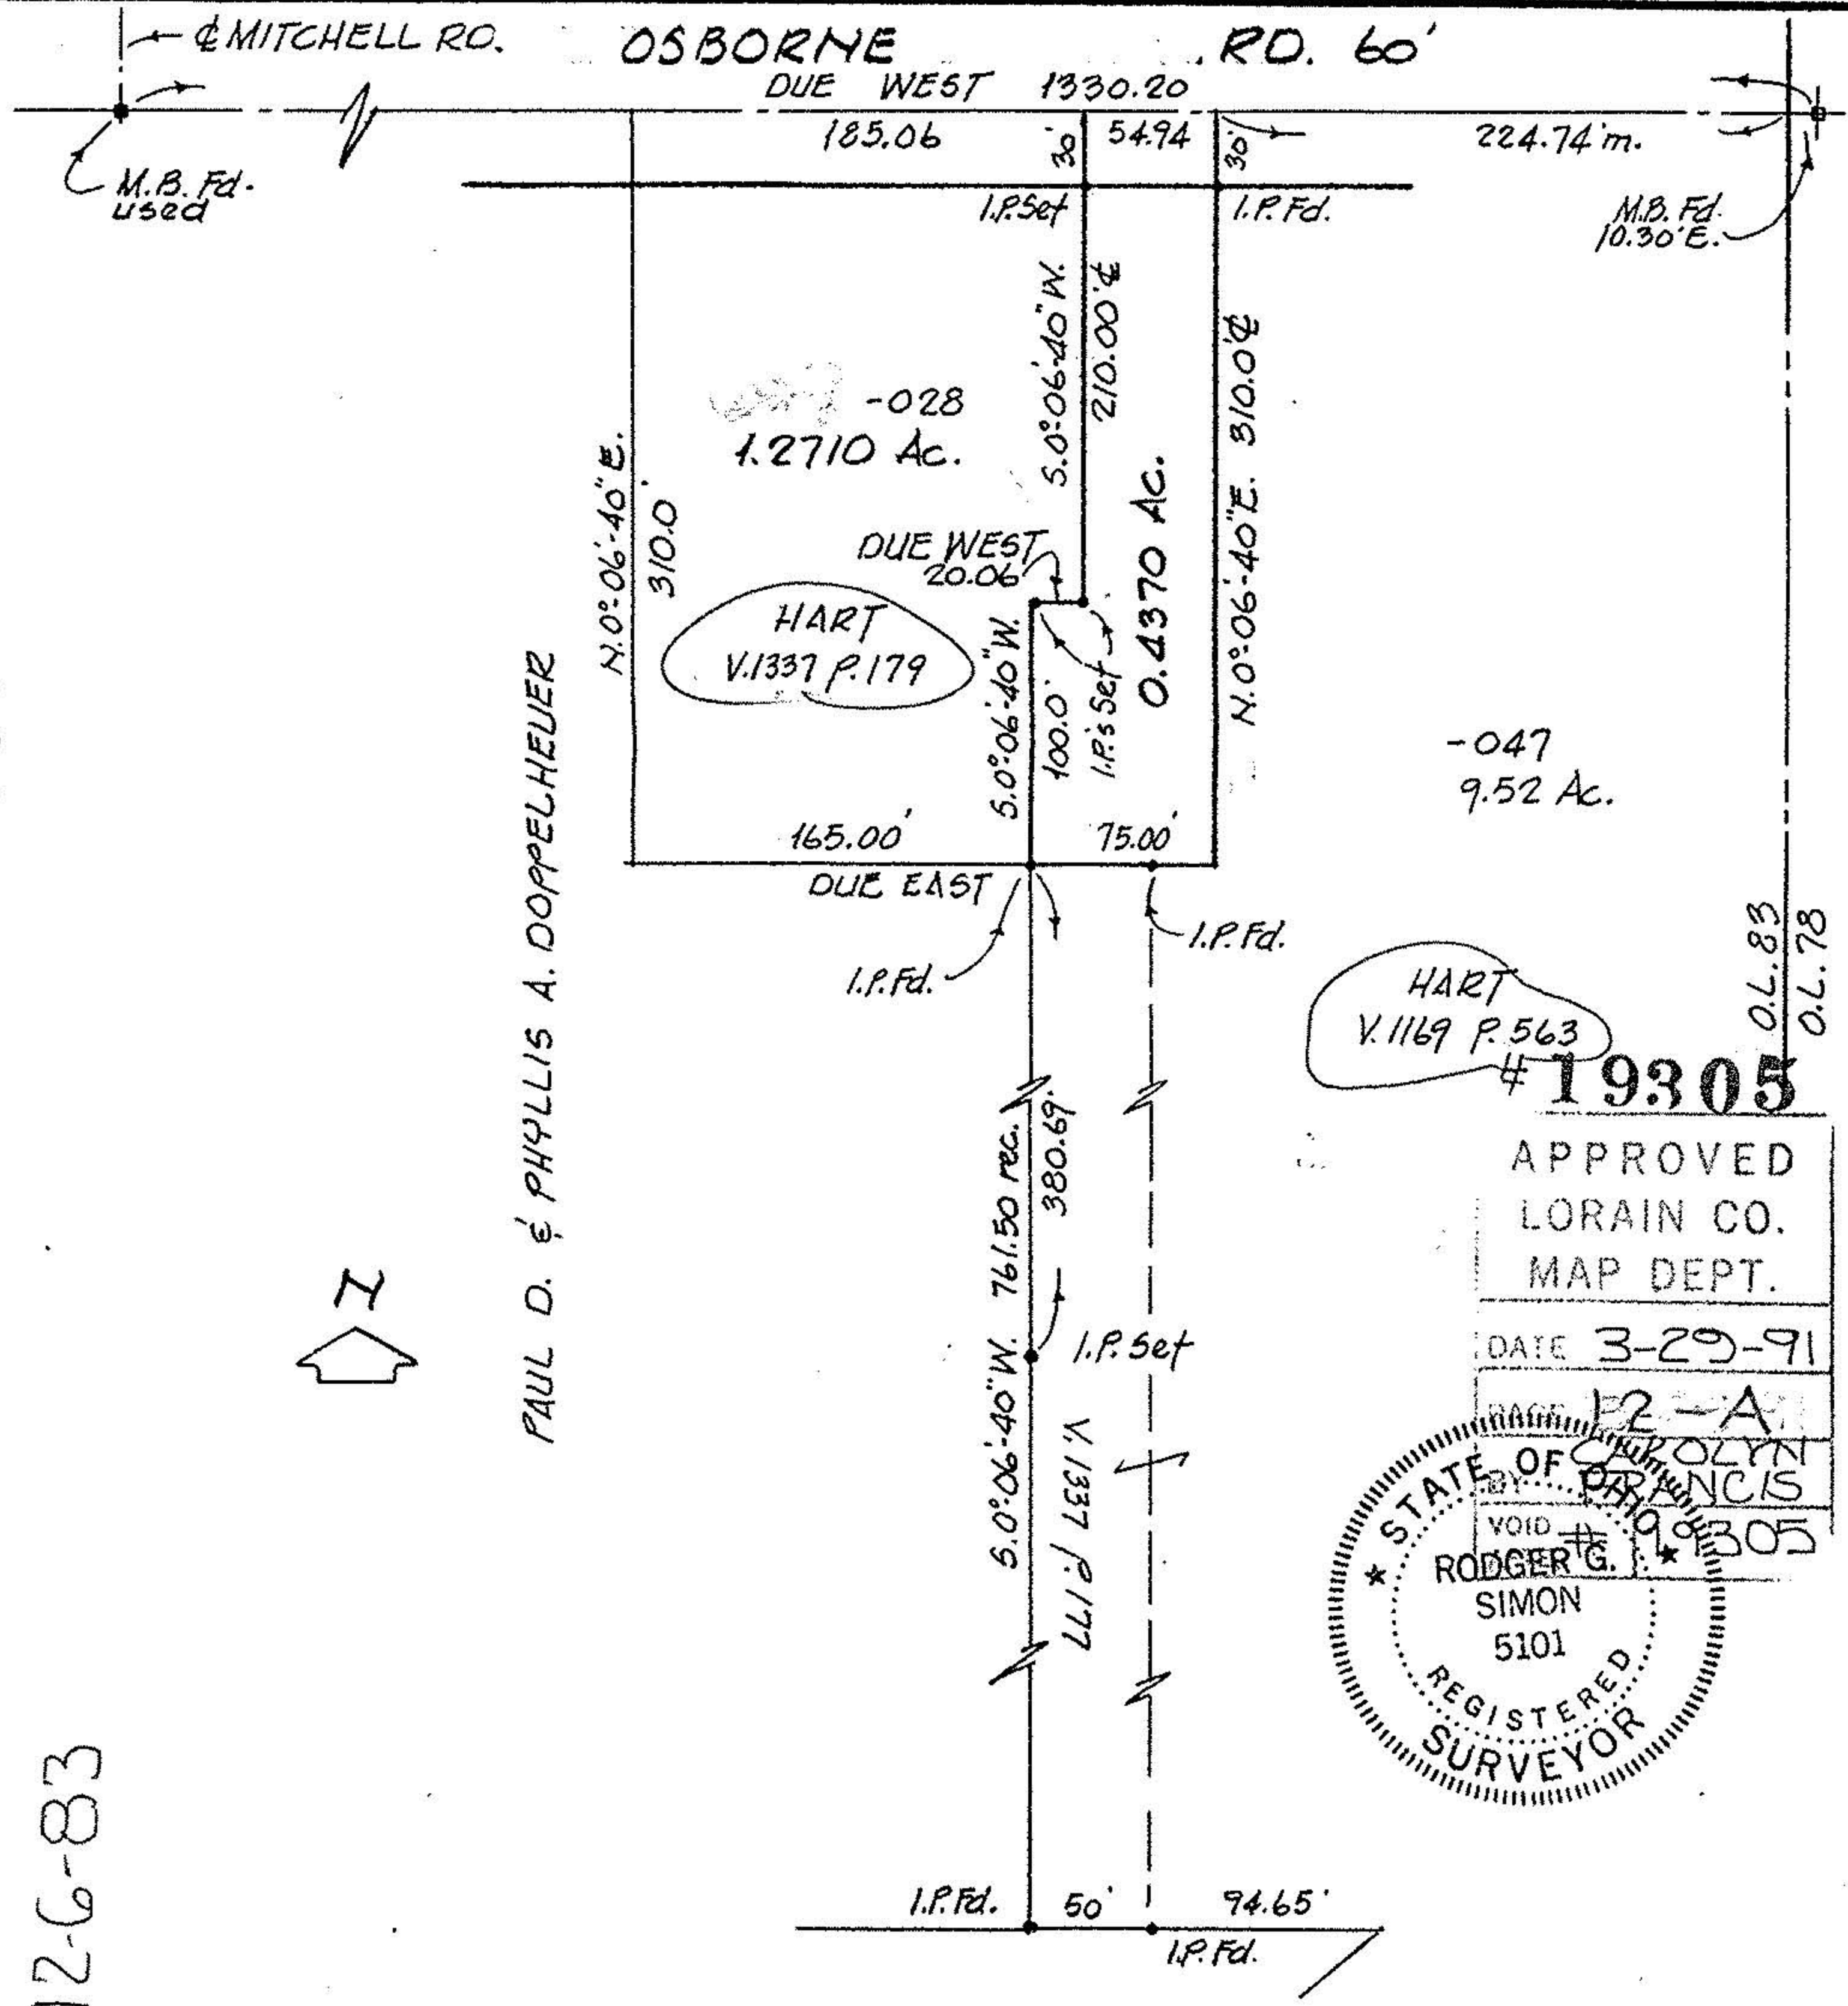

PAUL D. & PHYLLIS A. DOPPELHEUER