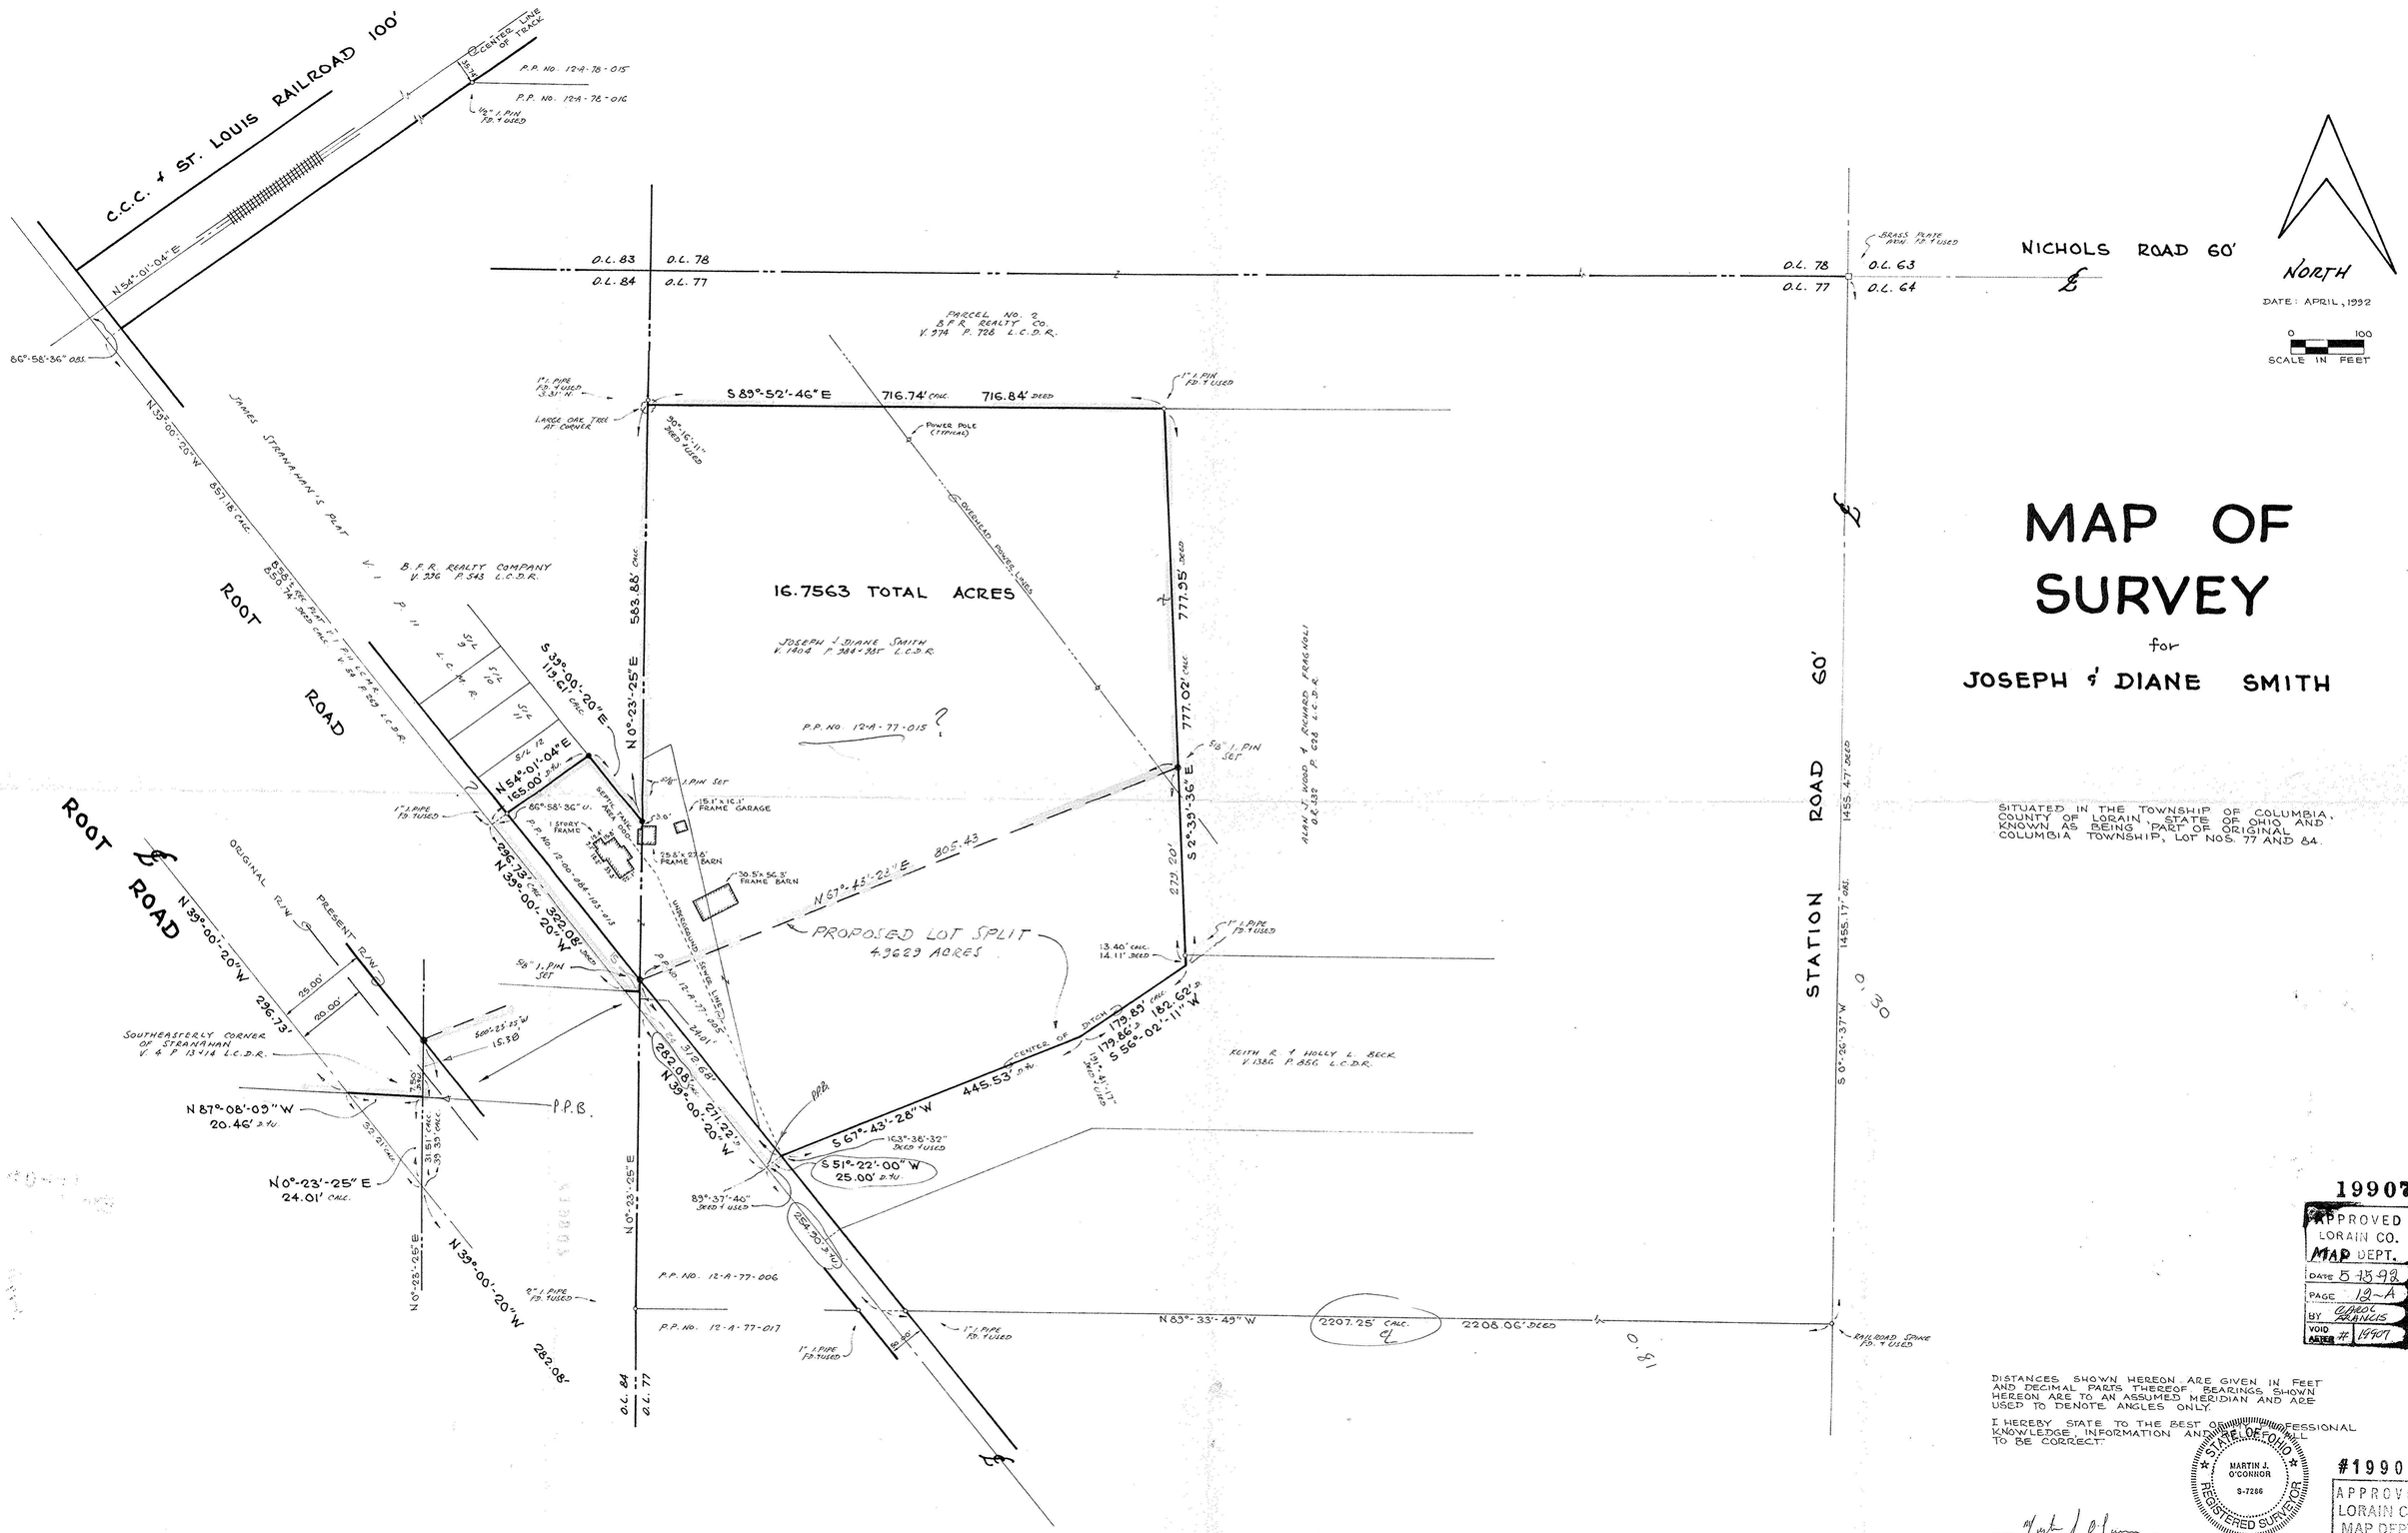

MAP OF SURVEY

for

JOSEPH & DIANE SMITH

SITUATED IN THE TOWNSHIP OF COLUMBIA, COUNTY OF LORAIN, STATE OF OHIO AND KNOWN AS BEING PART OF ORIGINAL COLUMBIA TOWNSHIP, LOT NOS. 77 AND 84.

19907

APPROVED
LORAIN CO.
MAP DEPT.
PAGE 12-A
BY CAROL FRANCIS
VOID AFTER # 19907

DISTANCES SHOWN HEREON ARE GIVEN IN FEET AND DECIMAL PARTS THEREOF. BEARINGS SHOWN HEREON ARE TO AN ASSUMED MERIDIAN AND ARE USED TO DENOTE ANGLES ONLY.

I HEREBY STATE TO THE BEST OF MY PROFESSIONAL KNOWLEDGE, INFORMATION AND BELIEF THIS TO BE CORRECT.

STATE OF OHIO
MARTIN J. O'CONNOR
S-7286
REGISTERED SURVEYOR

MARTIN J. O'CONNOR
REGISTERED SURVEYOR NO. 7286 - OHIO

#19907

APPROVED
LORAIN CO.
MAP DEPT.
DATE 5-21-92
PAGE 12-A & 084-B
BY T. McGlain
VOID AFTER 19907