Spencer Ph
Fischer Ph

Adding 25' Frontage From Fischer Property To Spencer Property

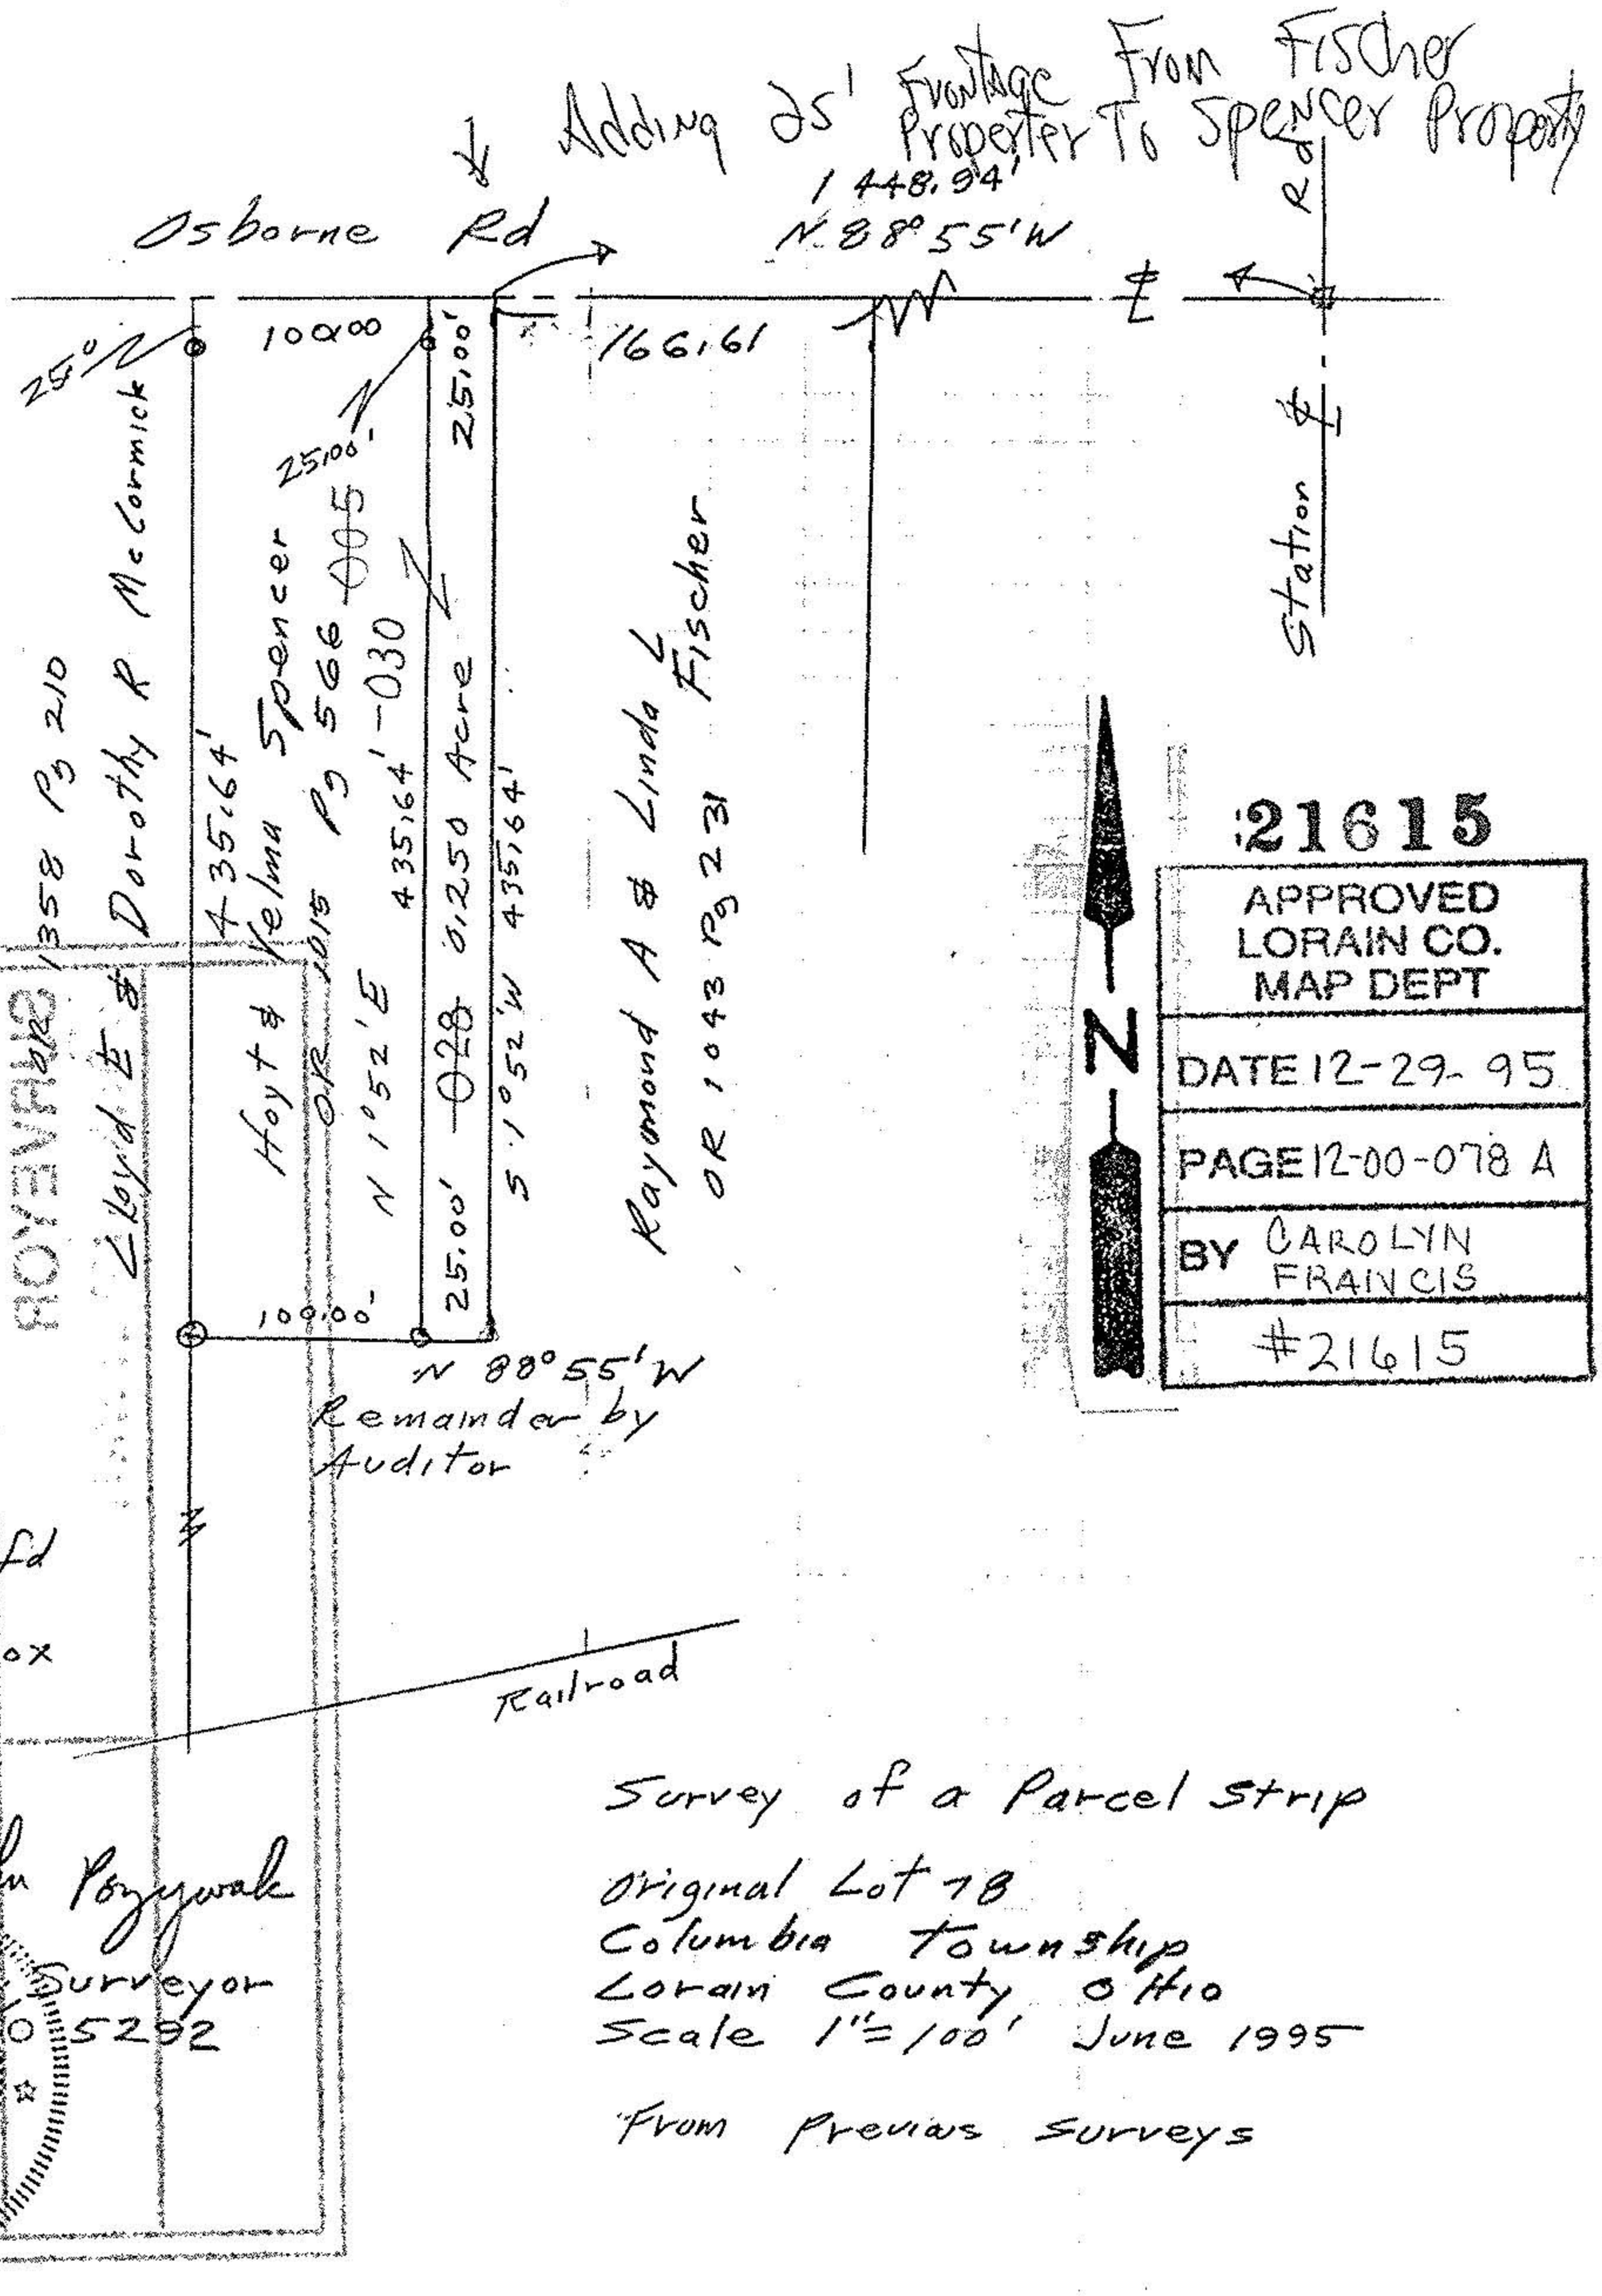

21615

APPROVED
LORAIN CO.
MAP DEPT

DATE 12-29-95

PAGE 12-00-078 A

BY CAROLYN FRANCIS

#21615

Survey of a Parcel Strip

Original Lot 78
Columbia Township
Lorain County Ohio
Scale 1"=100' June 1995

From Previas Surveys