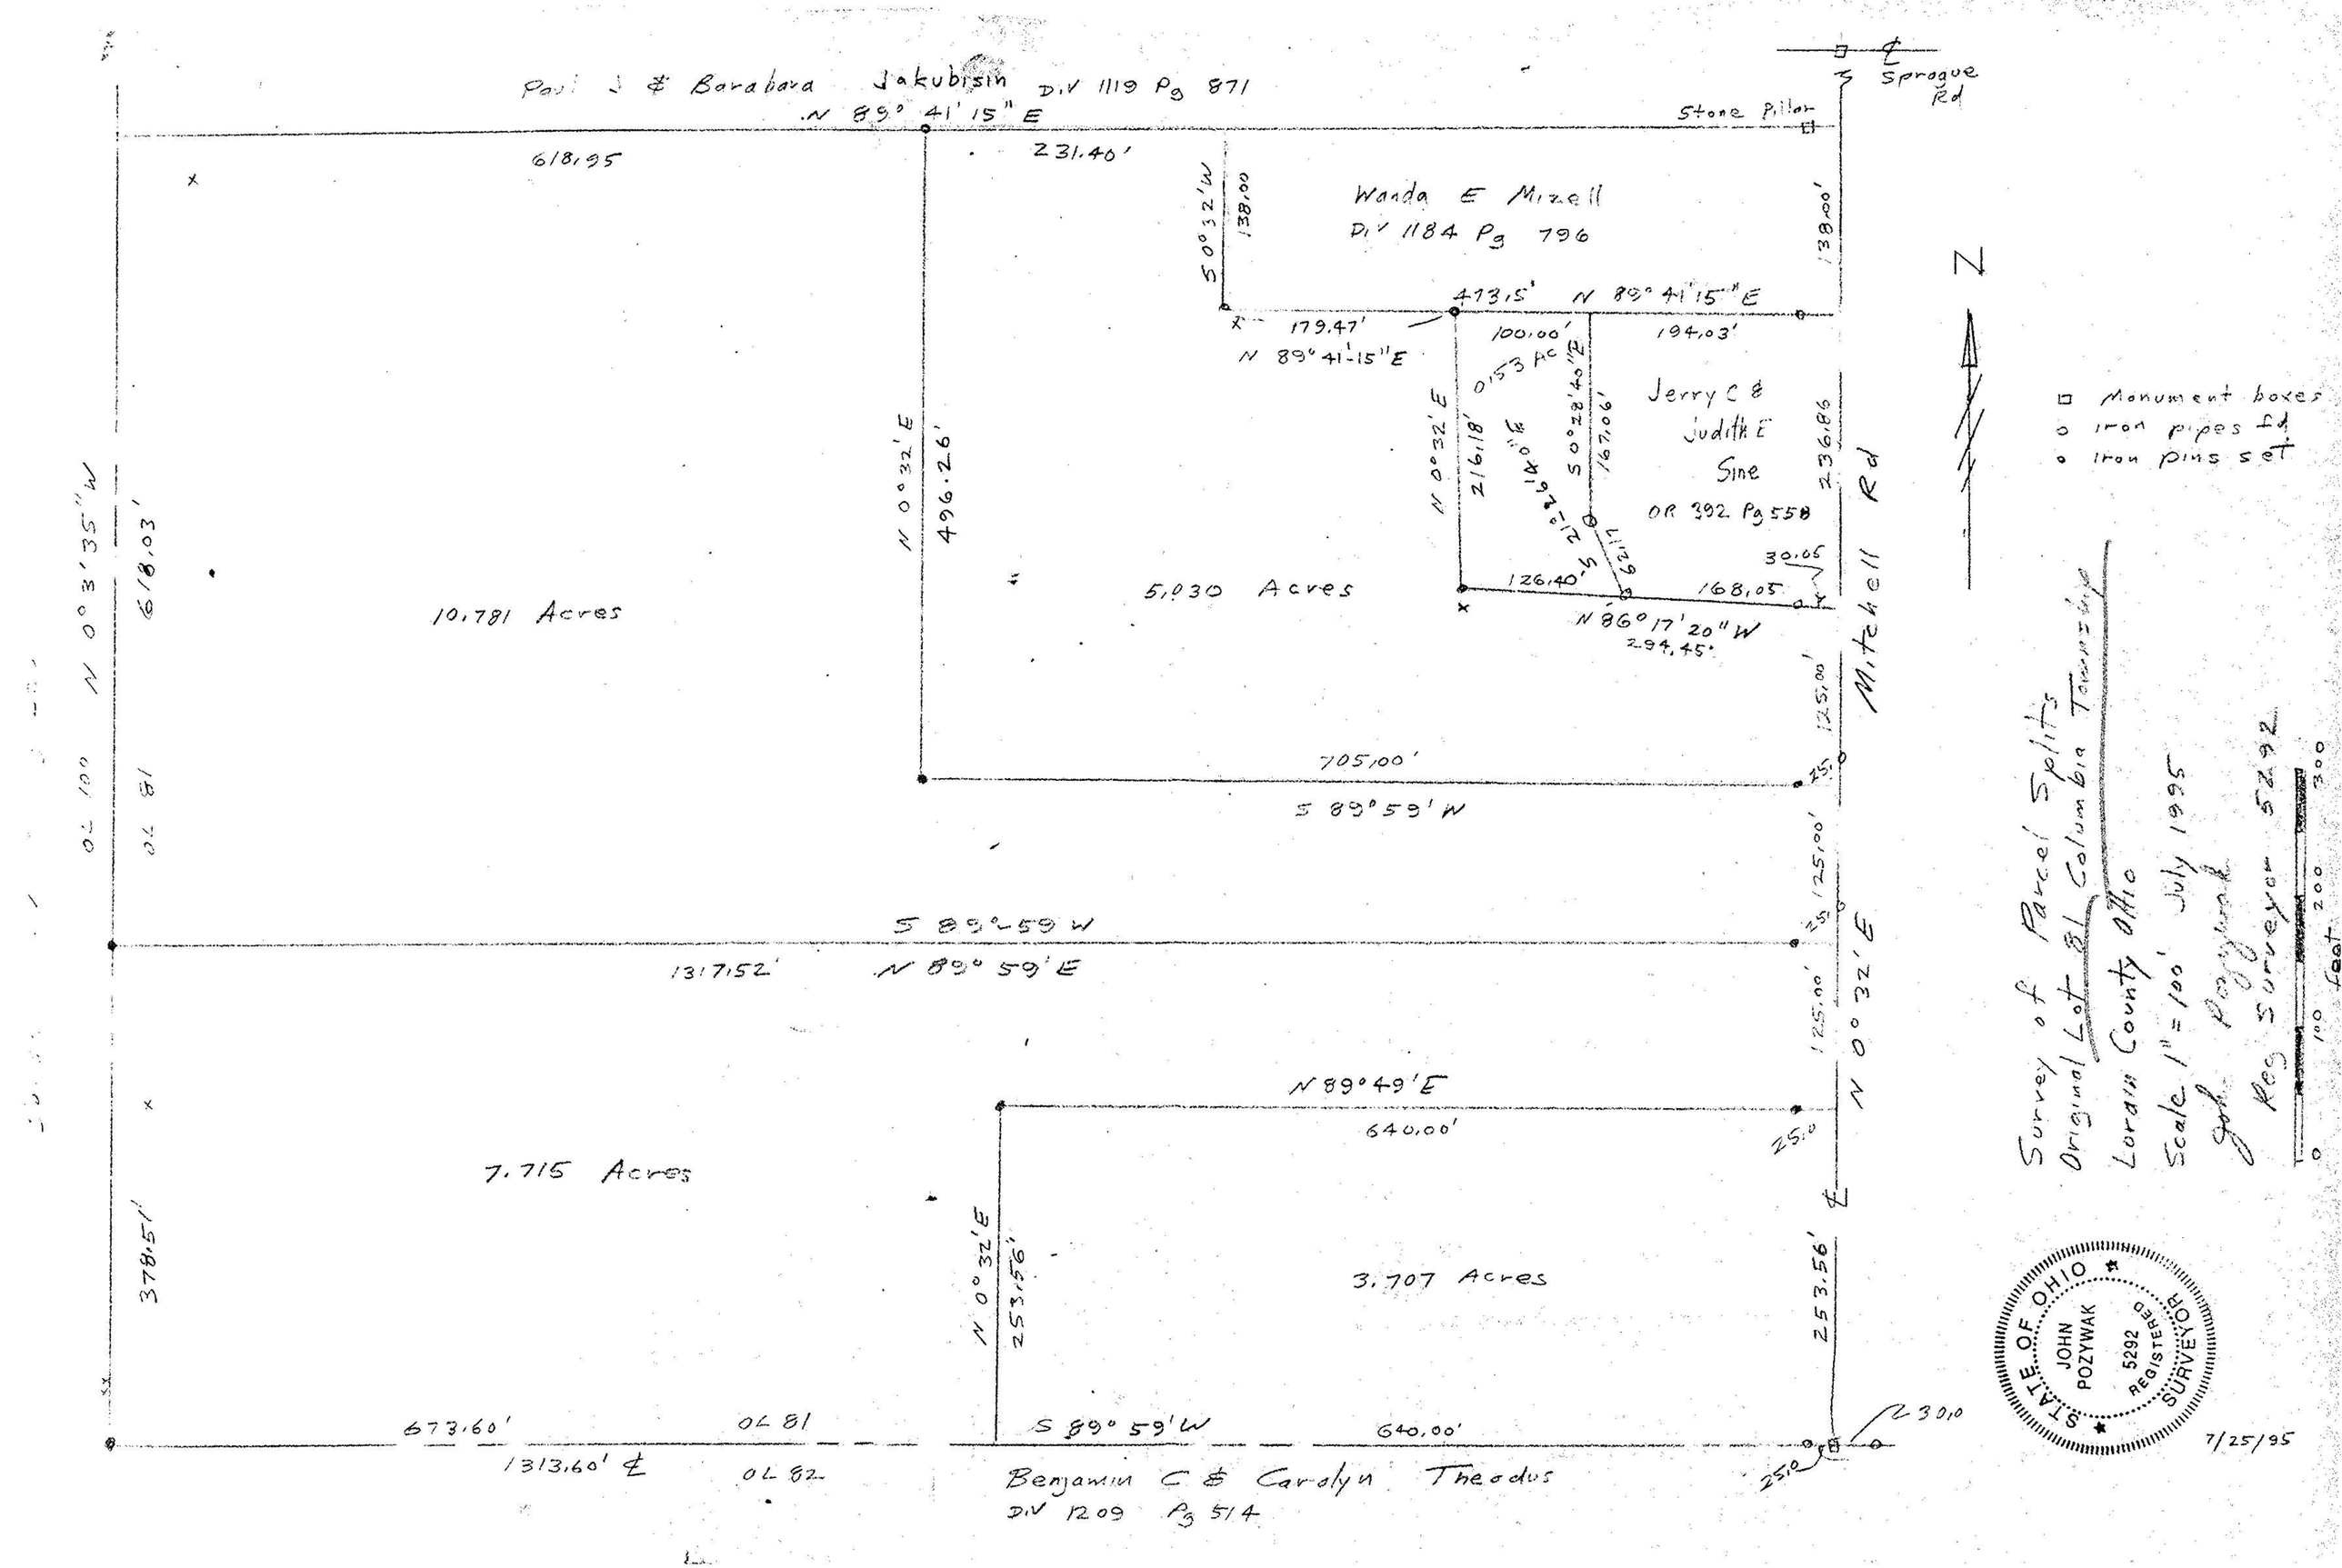

Paul J & Barabara Jakubisin D.V 1119 Pg 871
N 89° 41' 15" E
Stone Pillar
Sprague Rd
618.95
231.40'
Wanda E Mizell
D.V 1184 Pg 796
S 0° 32' W
138.00
138.00'
473.5'
N 89° 41' 15" E
179.47'
N 89° 41' 15" E
100.00'
194.03'
0.53 Ac
Jerry C & Judith E Sine
OR 392 Pg 558
N 0° 32' E
216.18'
S 0° 28' 40" E
167.06'
236.86
N 0° 32' E
496.26'
N 0° 3' 35" W
618.03'
10.781 Acres
5.030 Acres
126.40'
168.05
30.05
N 86° 17' 20" W
294.45'
Mitchell Rd
125.00'
705.00'
S 89° 59' W
OL 100
OL 81
S 89° 59' W
1317.52'
N 89° 59' E
125.00'
N 0° 32' E
N 89° 49' E
640.00'
7.715 Acres
378.51'
N 0° 32' E
253.56'
3.707 Acres
253.56'
673.60'
OL 81
S 89° 59' W
640.00'
1313.60' ℄
OL 82
Benjamin C & Carolyn Theodus
D.V 1209 Pg 514
30.0
25.0
N
Monument boxes
iron pipes fd
iron pins set
Survey of Parcel Splits
Original Lot 81 Columbia Township
Lorain County Ohio
Scale 1" = 100' July 1995
John Pozywak
Reg Surveyor 5292
0 100 200 300
feet
STATE OF OHIO
JOHN POZYWAK
5292
REGISTERED
SURVEYOR
7/25/95