12-A
12-00-098

#10744

12-00-098-000

JUL 22 1977

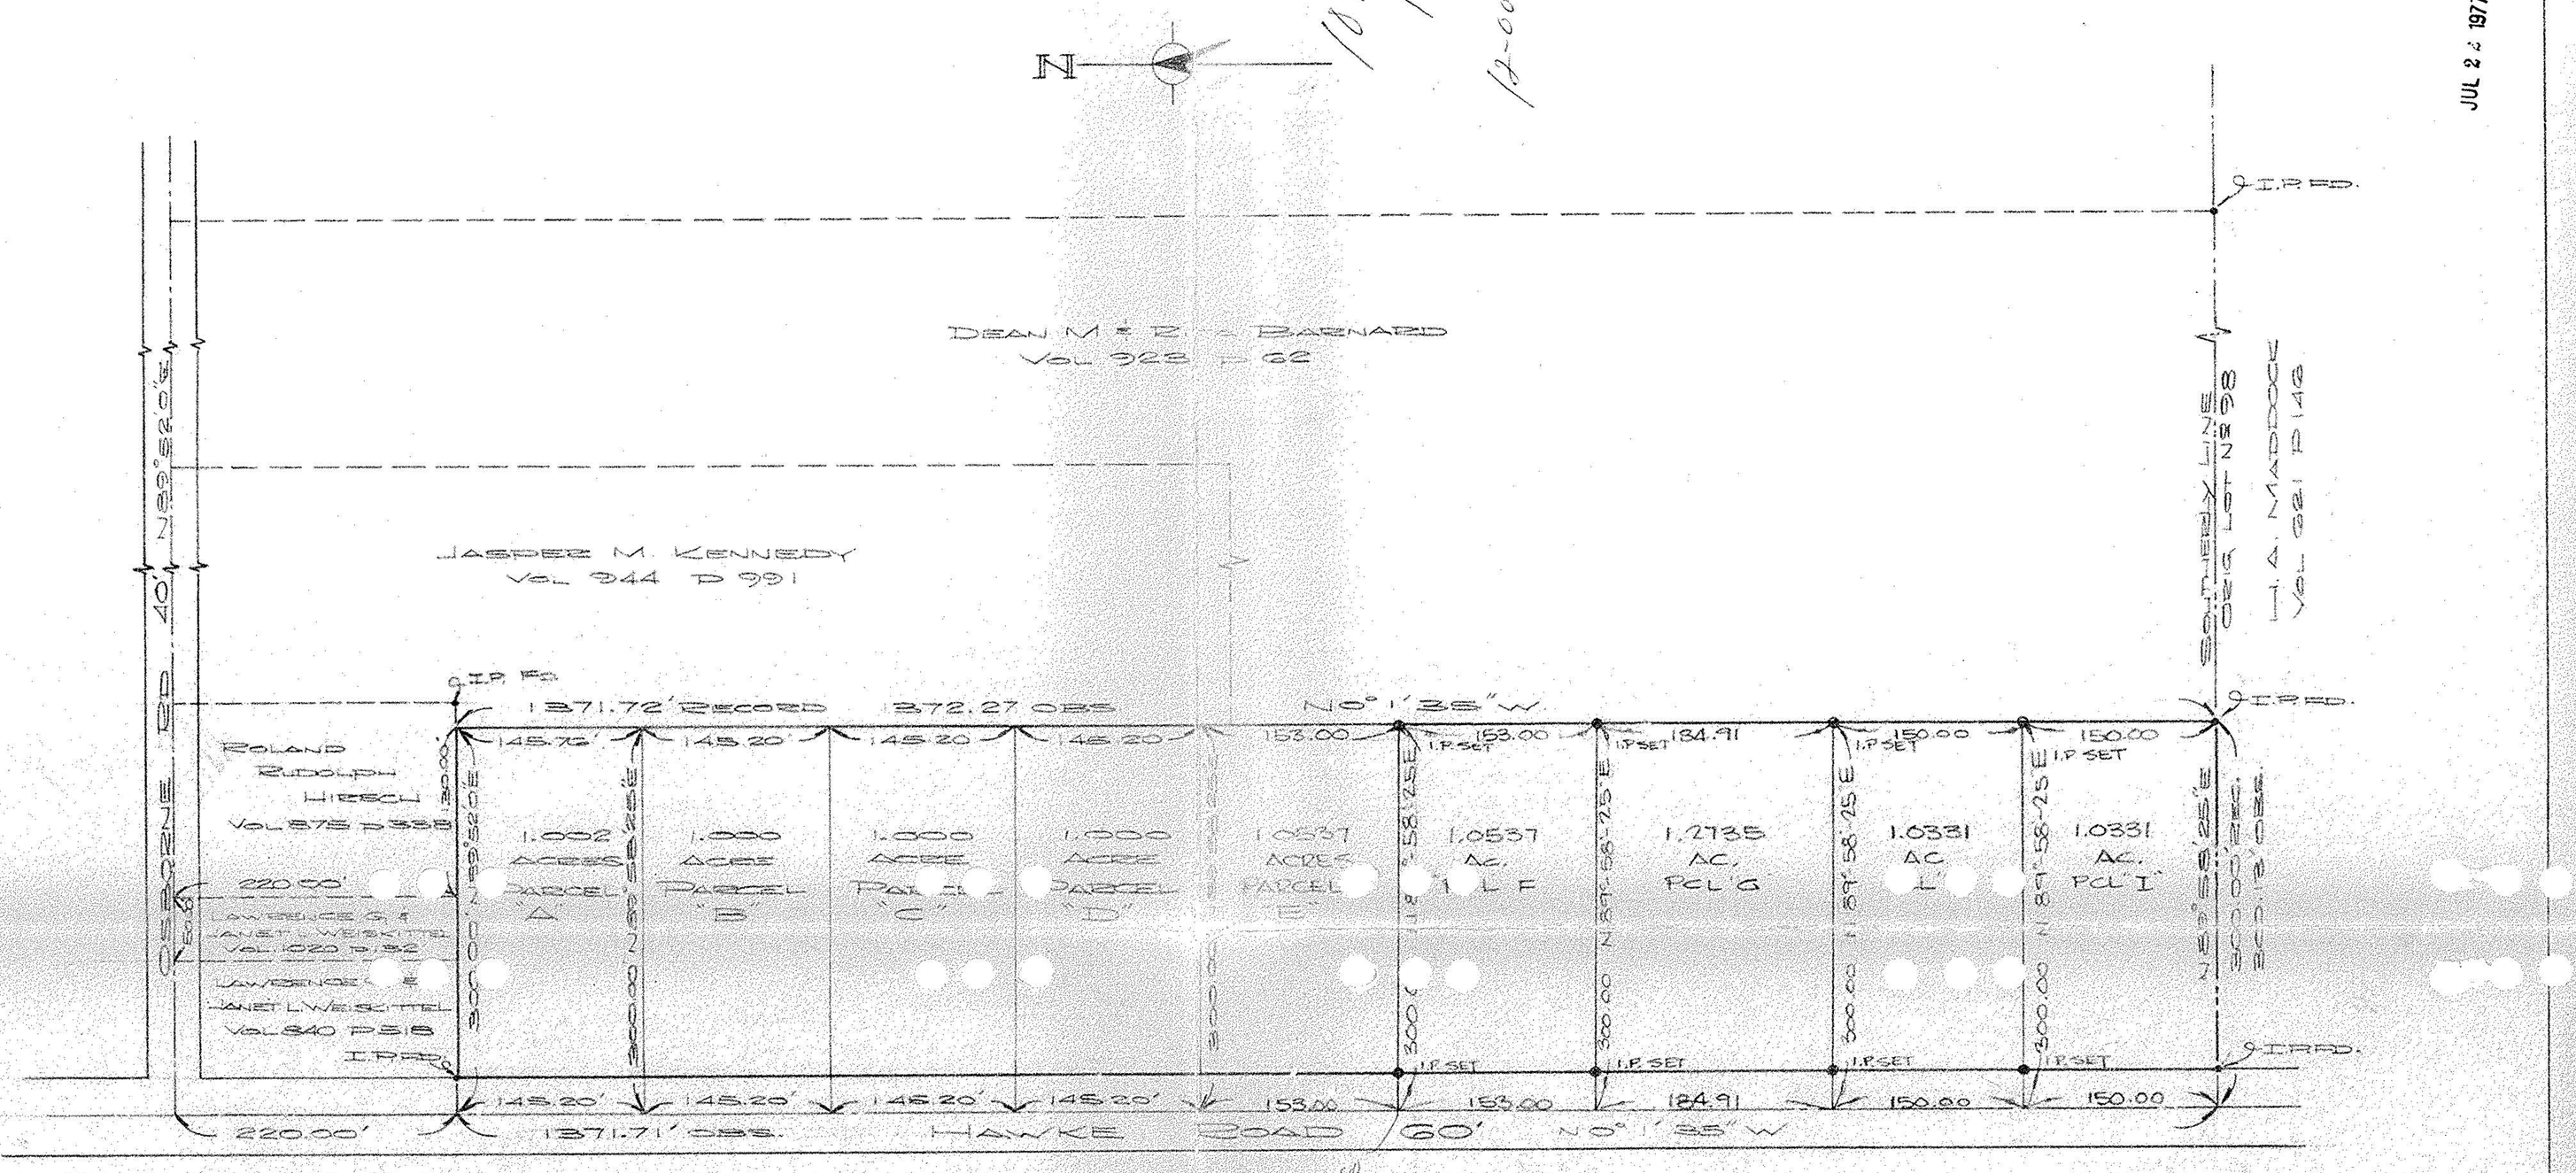

PREPARED FOR:
GEORGE FLURY

SURVEY
PART OF
O. L. 98 (COLUMBIA TWP.
COUNTY OF LOGAN STATE OF OHIO

PREPARED BY:
J. R. FOOR & ASSOCIATES
N. EDGEVILLE, OHIO.

STATE OF OHIO
JAMES R. FOOR
R.S. - 5875
REGISTERED
SURVEYOR

SCALE 1" = 100'
SEPTEMBER 11, 1973

REVISED 5/2/77

73-213

12-00-098-000

#10744

JUN 17 1977

12-A