12-E

0.L.93

MAP OF SURVEY
FOR
THOMAS TEHOKE

Pcl. No. 2

Being part of original Columbia Township Lot No. 93 in the Township of Columbia, County of Lorain and State of Ohio
Scale 1" = 100'

April 1977

Richard Mackay
Registered Ohio Surveyor No. 4195
SLABE & MACKAY
CIVIL ENGINEERS & SURVEYORS

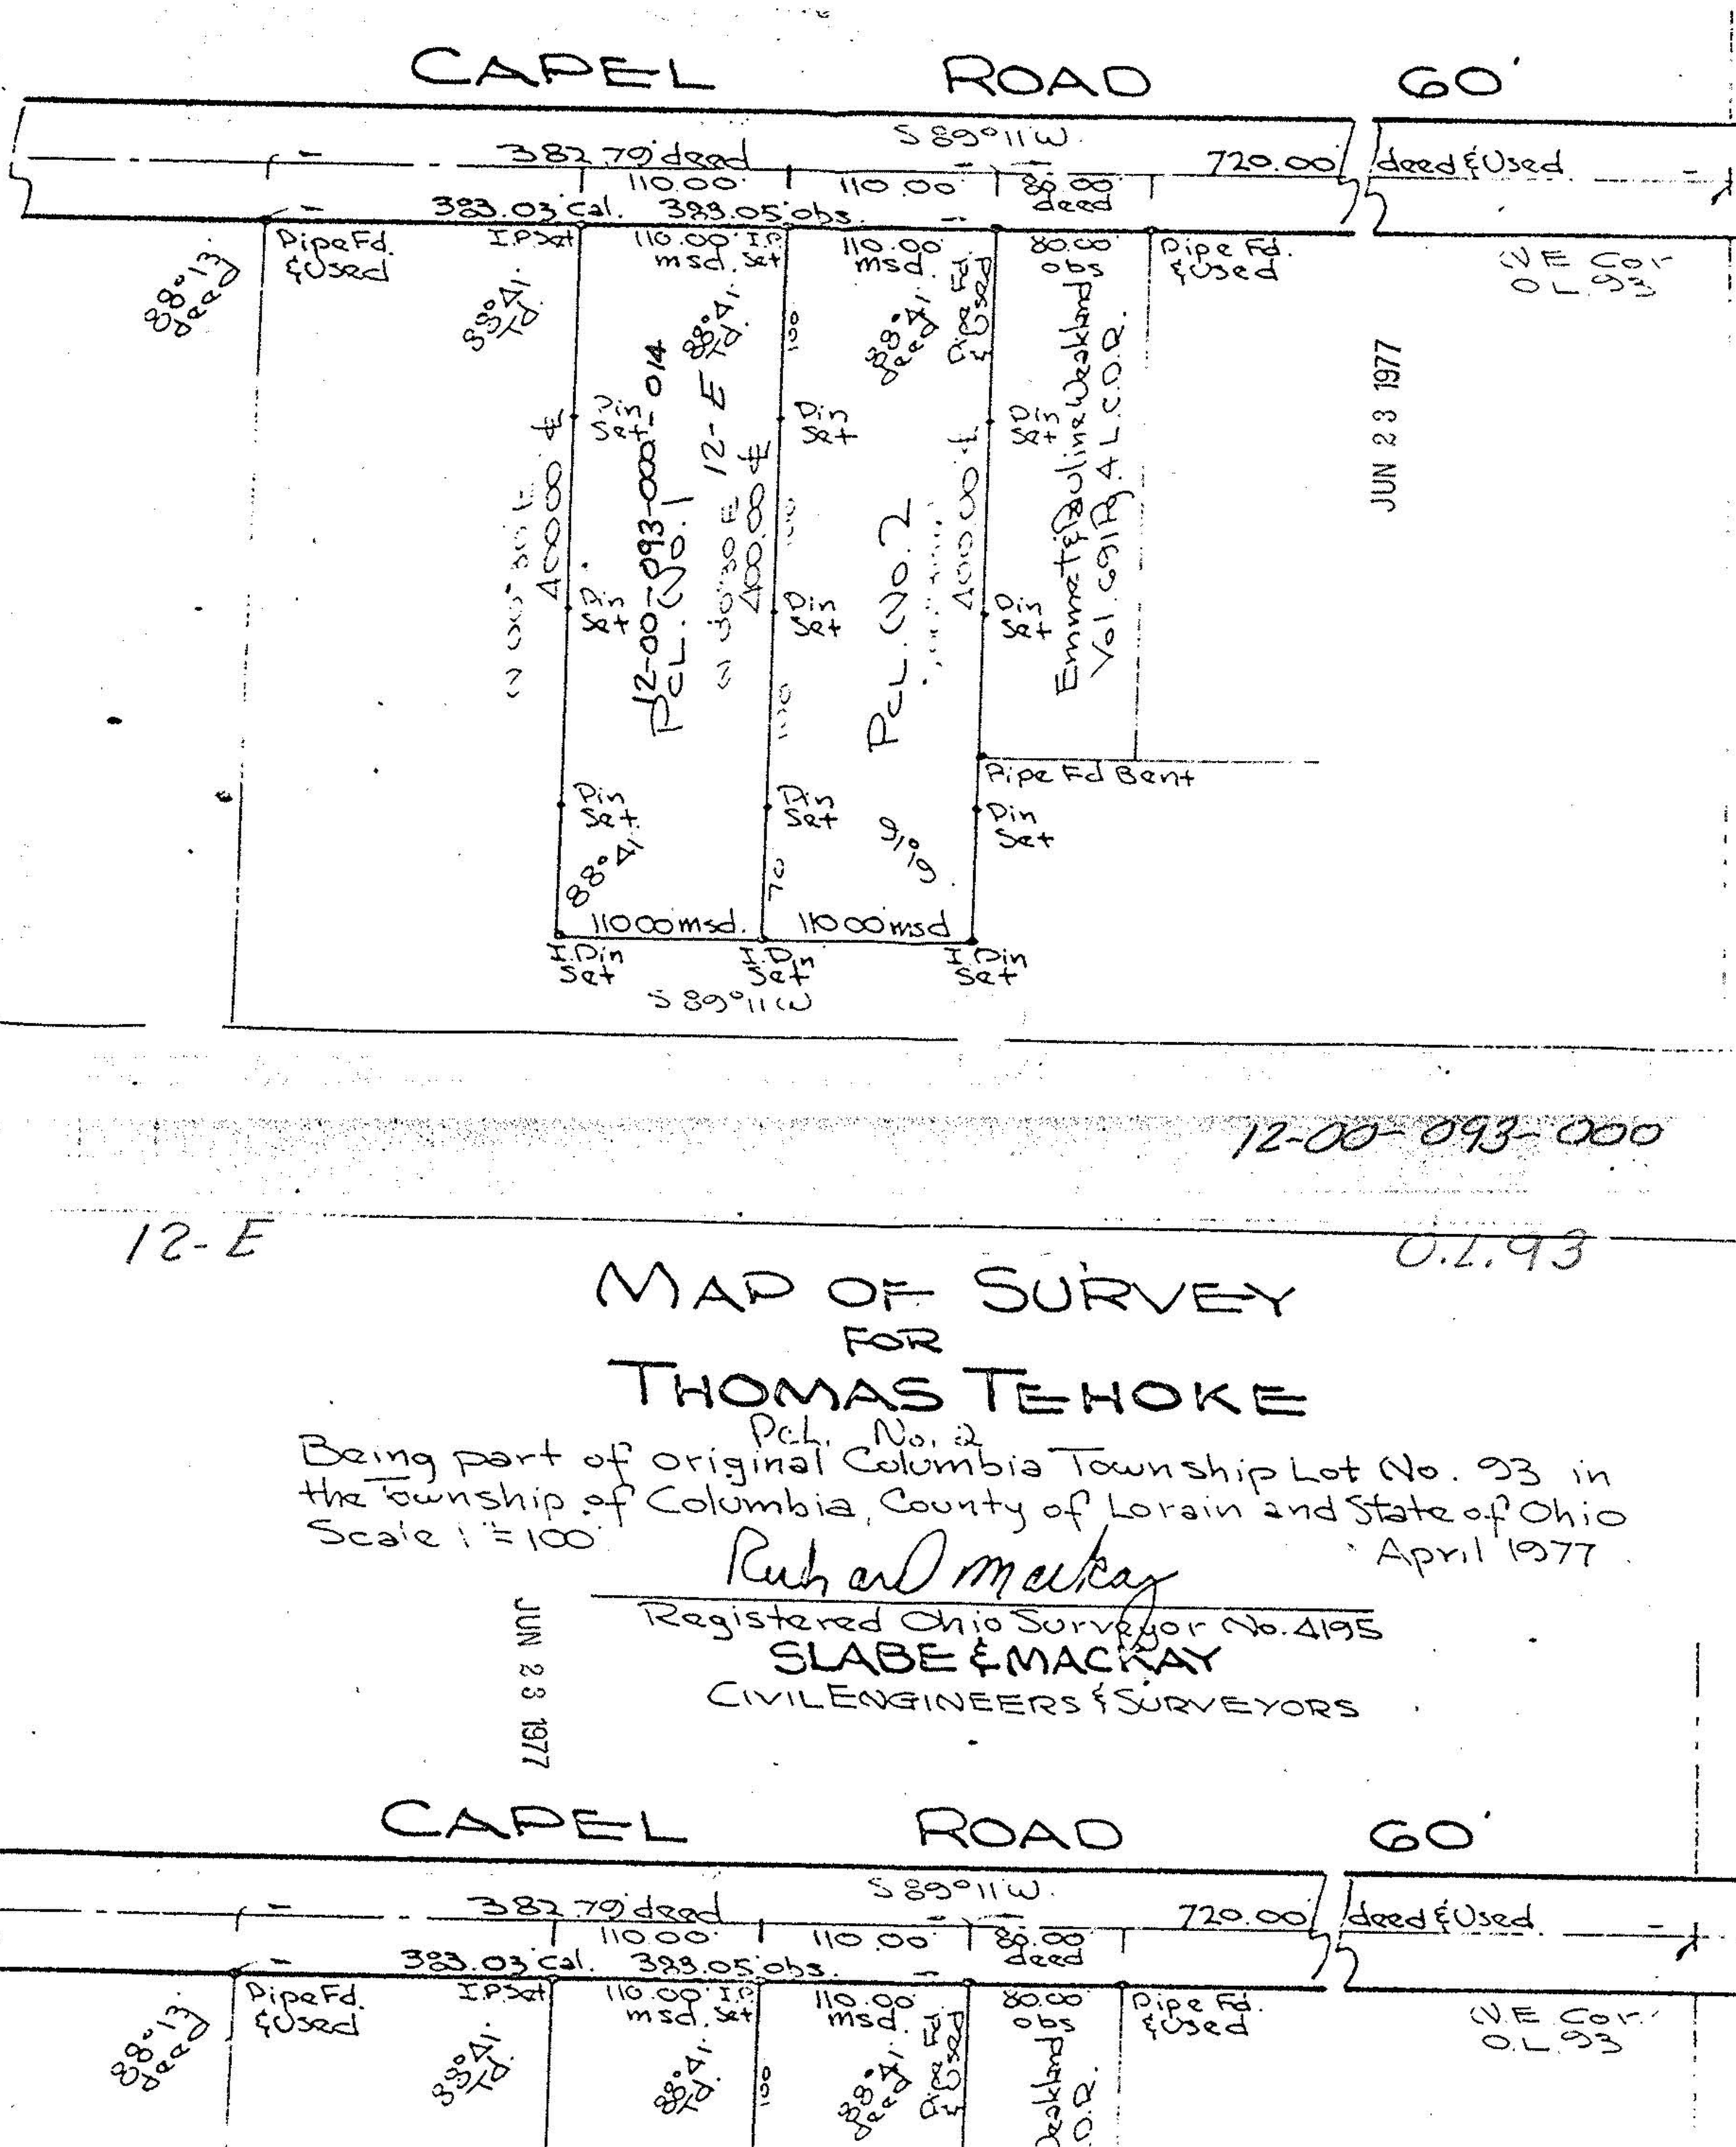

12-00-093-000

12-E

0.L.93

MAP OF SURVEY
FOR
THOMAS TEHOKE

Pcl. No. 2

Being part of original Columbia Township Lot No. 93 in the Township of Columbia, County of Lorain and State of Ohio
Scale 1" = 100'

April 1977

Richard Mackay
Registered Ohio Surveyor No. 4195
SLABE & MACKAY
CIVIL ENGINEERS & SURVEYORS

JUN 23 1977

12-E
0.L.93