

LORAIN COUNTY MONUMENT FOUND & USED

PLAT OF SURVEY

MADE FOR
PETER A. JR. & IRENE M. BORLING
DEED RECORDED IN INSTRUMENT # 20000722405


BEING PART OF ORIGINAL COLUMBIA TOWNSHIP LOT 90
COLUMBIA TOWNSHIP, LORAIN COUNTY, OHIO

REVISED MAY 28, 2002 PER LORAIN
COUNTY PLANNING COMMISSION TO
CONSOLIDATE PPN 12-00-090-000-006
WITH A PART OF PPN 12-00-090-000-020

No 01114
APPROVED LORAIN CO. MAP DEPT
DATE 6-18-02
PAGE 12-E
BY J Hatfield
#02-01114

I DECLARE THIS PLAT TO BE A TRUE REPRESENTATION
OF AN ACTUAL FIELD SURVEY MADE BY ME IN
MAY, 2002. DISTANCES ARE GIVEN IN FEET AND
DECIMAL PARTS THEREOF. NORTH DATUM USED
IS THE BEARING OF RECORD FOR THE CENTER-
LINE OF STATION ROAD.

- INDICATES 5/8" IRON PIN, 30" LONG, WITH "ZWICK" CAP, SET
- ▲ INDICATES "MAG" NAIL SET

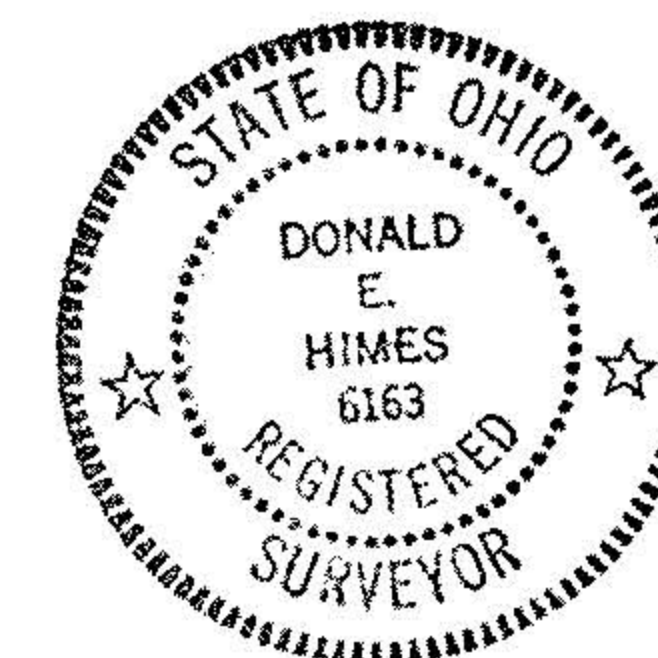

Donald E. Himes 5/28/02
DONALD E. HIMES, P.S. # 6163
ZWICK ASSOCIATES, INC.
ENGINEERS - SURVEYORS - PLANNERS
8750 STEARNS ROAD, DIMSTED TOWNSHIP, OHIO 44138
TEL: 440-235-2729 FAX: 440-235-0604

