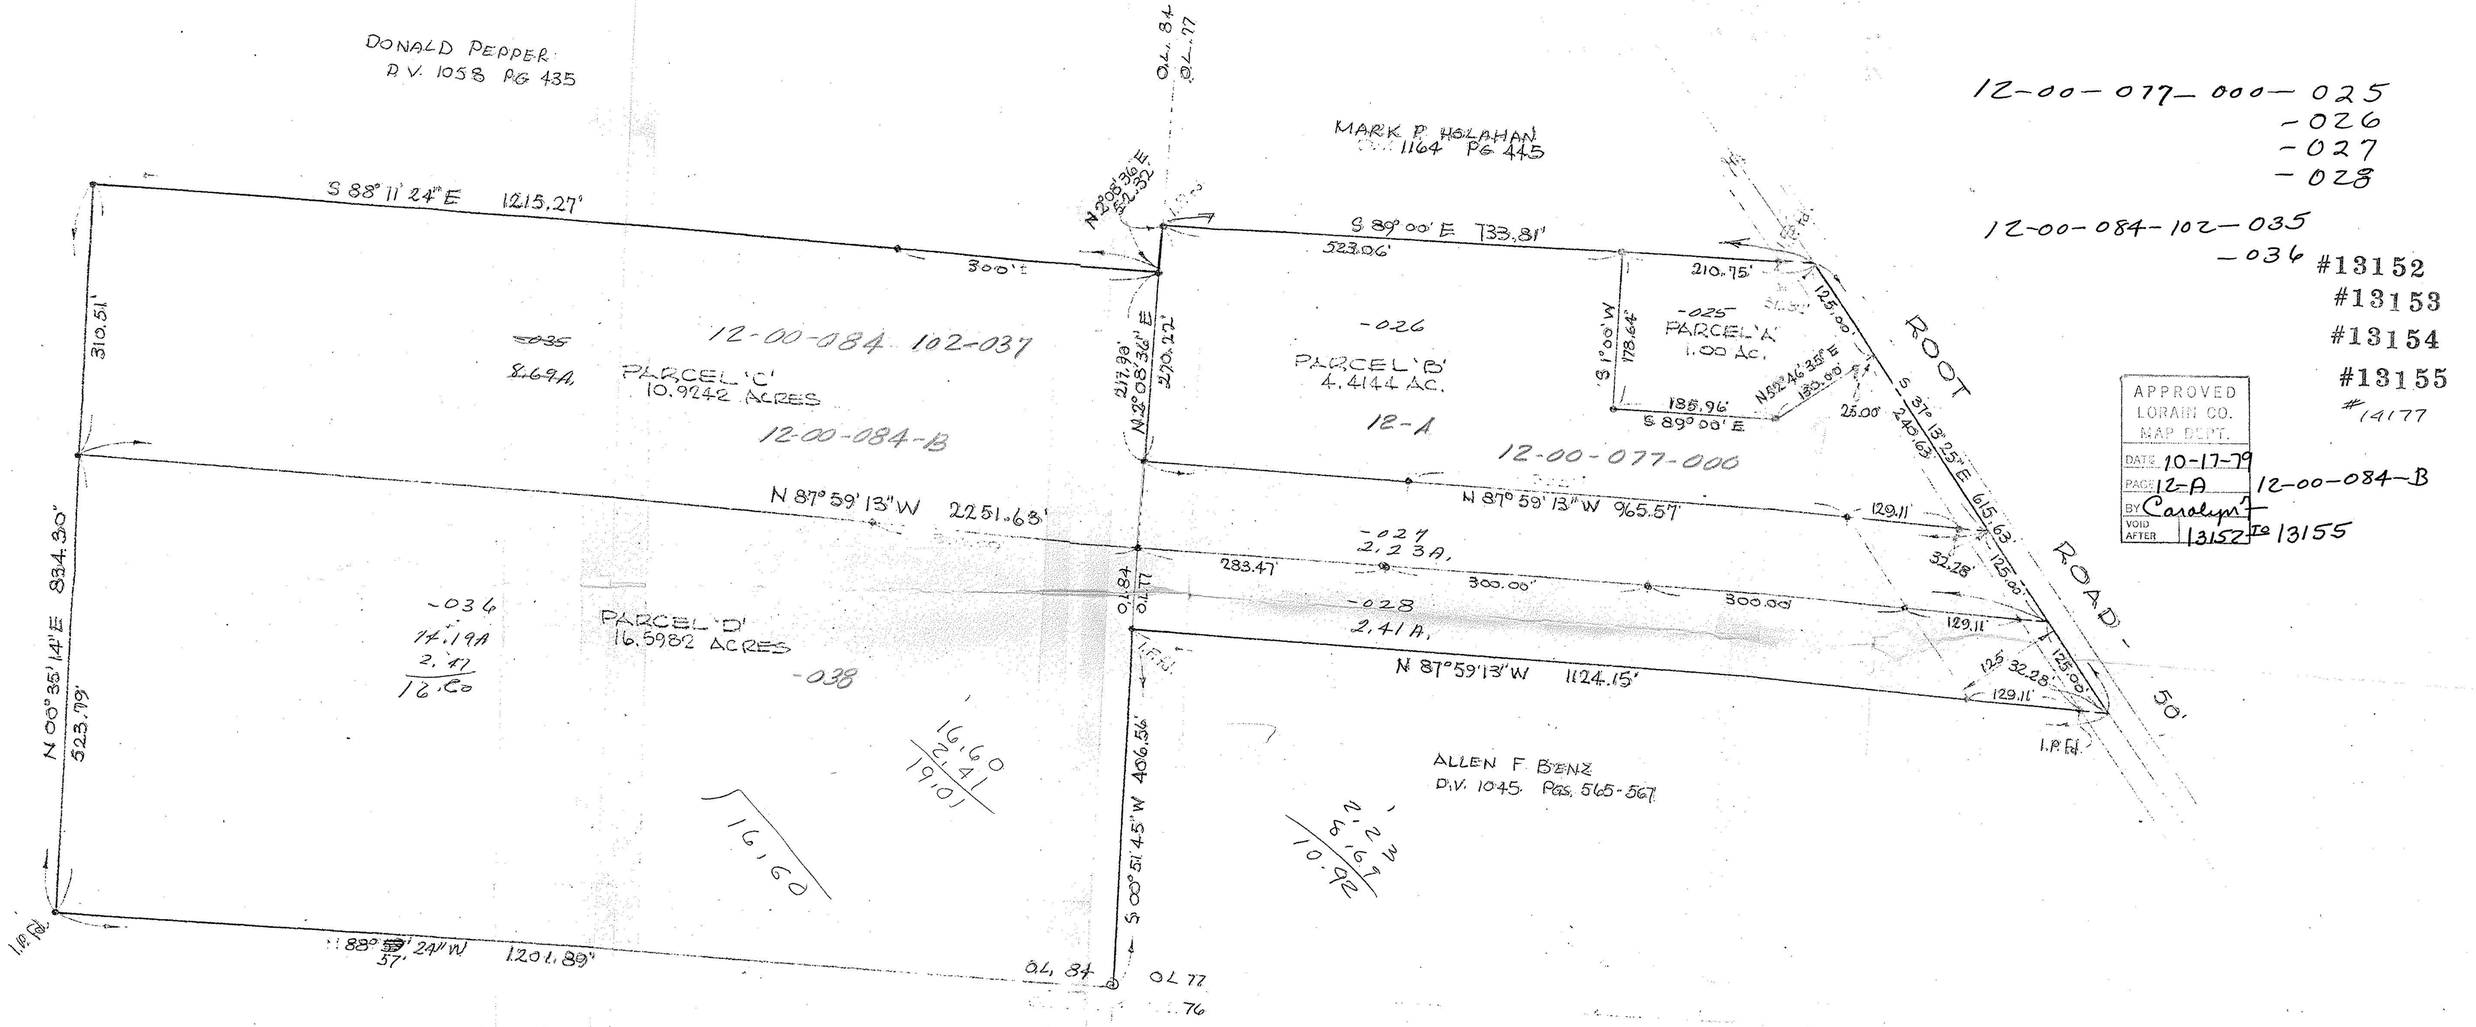
DONALD PEPPER
D.V. 1058 PG 435
MARK P. HOLAHAN
1164 PG 445
S 88° 11' 24" E 1215.27'
S 89° 00' E 733.81'
523.06'
300'±
310.51'
12-00-084 102-037
PARCEL 'C'
10.9242 ACRES
12-00-084-B
PARCEL 'B'
4.4144 AC.
12-A
-026
-025
PARCEL 'A'
1.00 AC.
S 1° 00' W
178.64'
210.75'
125.00'
185.96'
S 89° 00' E
N 32° 46' 35" E
130.00'
25.00'
ROOT
ROAD - 50'
S 37° 13' 25" E
240.63'
615.63'
12-00-077-000
N 87° 59' 13" W 2251.63'
N 87° 59' 13" W 965.57'
129.11'
32.28'
125.00'
-027
2.23 A.
283.47'
300.00'
300.00'
-028
2.41 A.
-036
14.19A
2.41
16.60
PARCEL 'D'
16.5982 ACRES
-038
N 87° 59' 13" W 1124.15'
N 00° 35' 14" E 834.30'
523.79'
16.60
2.41
19.01
16.60
S 00° 51' 45" W 406.56'
ALLEN F. BENZ
D.V. 1045 Pgs. 565-567
2.23
6.69
10.92
88° 57' 24" W 1201.89'
O.L. 84
O.L. 77
76
I.P. Fd.
12-00-077-000-025
-026
-027
-028
12-00-084-102-035
-036
#13152
#13153
#13154
#13155
#14177
APPROVED
LORAIN CO.
MAP DEPT.
DATE 10-17-79
PAGE 12-A
BY Carolyn
VOID AFTER 13152 TO 13155
12-00-084-B