


PARCEL No. 5 4.0014 ACRES  
 SURVEYED OCT. 24-1978  
 13-A · 13-11-022-000-012

- 010  
 PARCEL No. 4 4.0014 ACRES

- 004  
 PARCEL No. 3 4.0014 ACRES

PARCEL No. 2 4.4775 ACRES  
 900 -  
 PARCEL No. 1 5.0001 ACRES  
 200 -

APPROVED	29.02
LORAN	112592
MAP DEPT.	29.02
DATE	4-16-79
PAGE	13-A
BY	Carlyle
VOID AFTER	112592

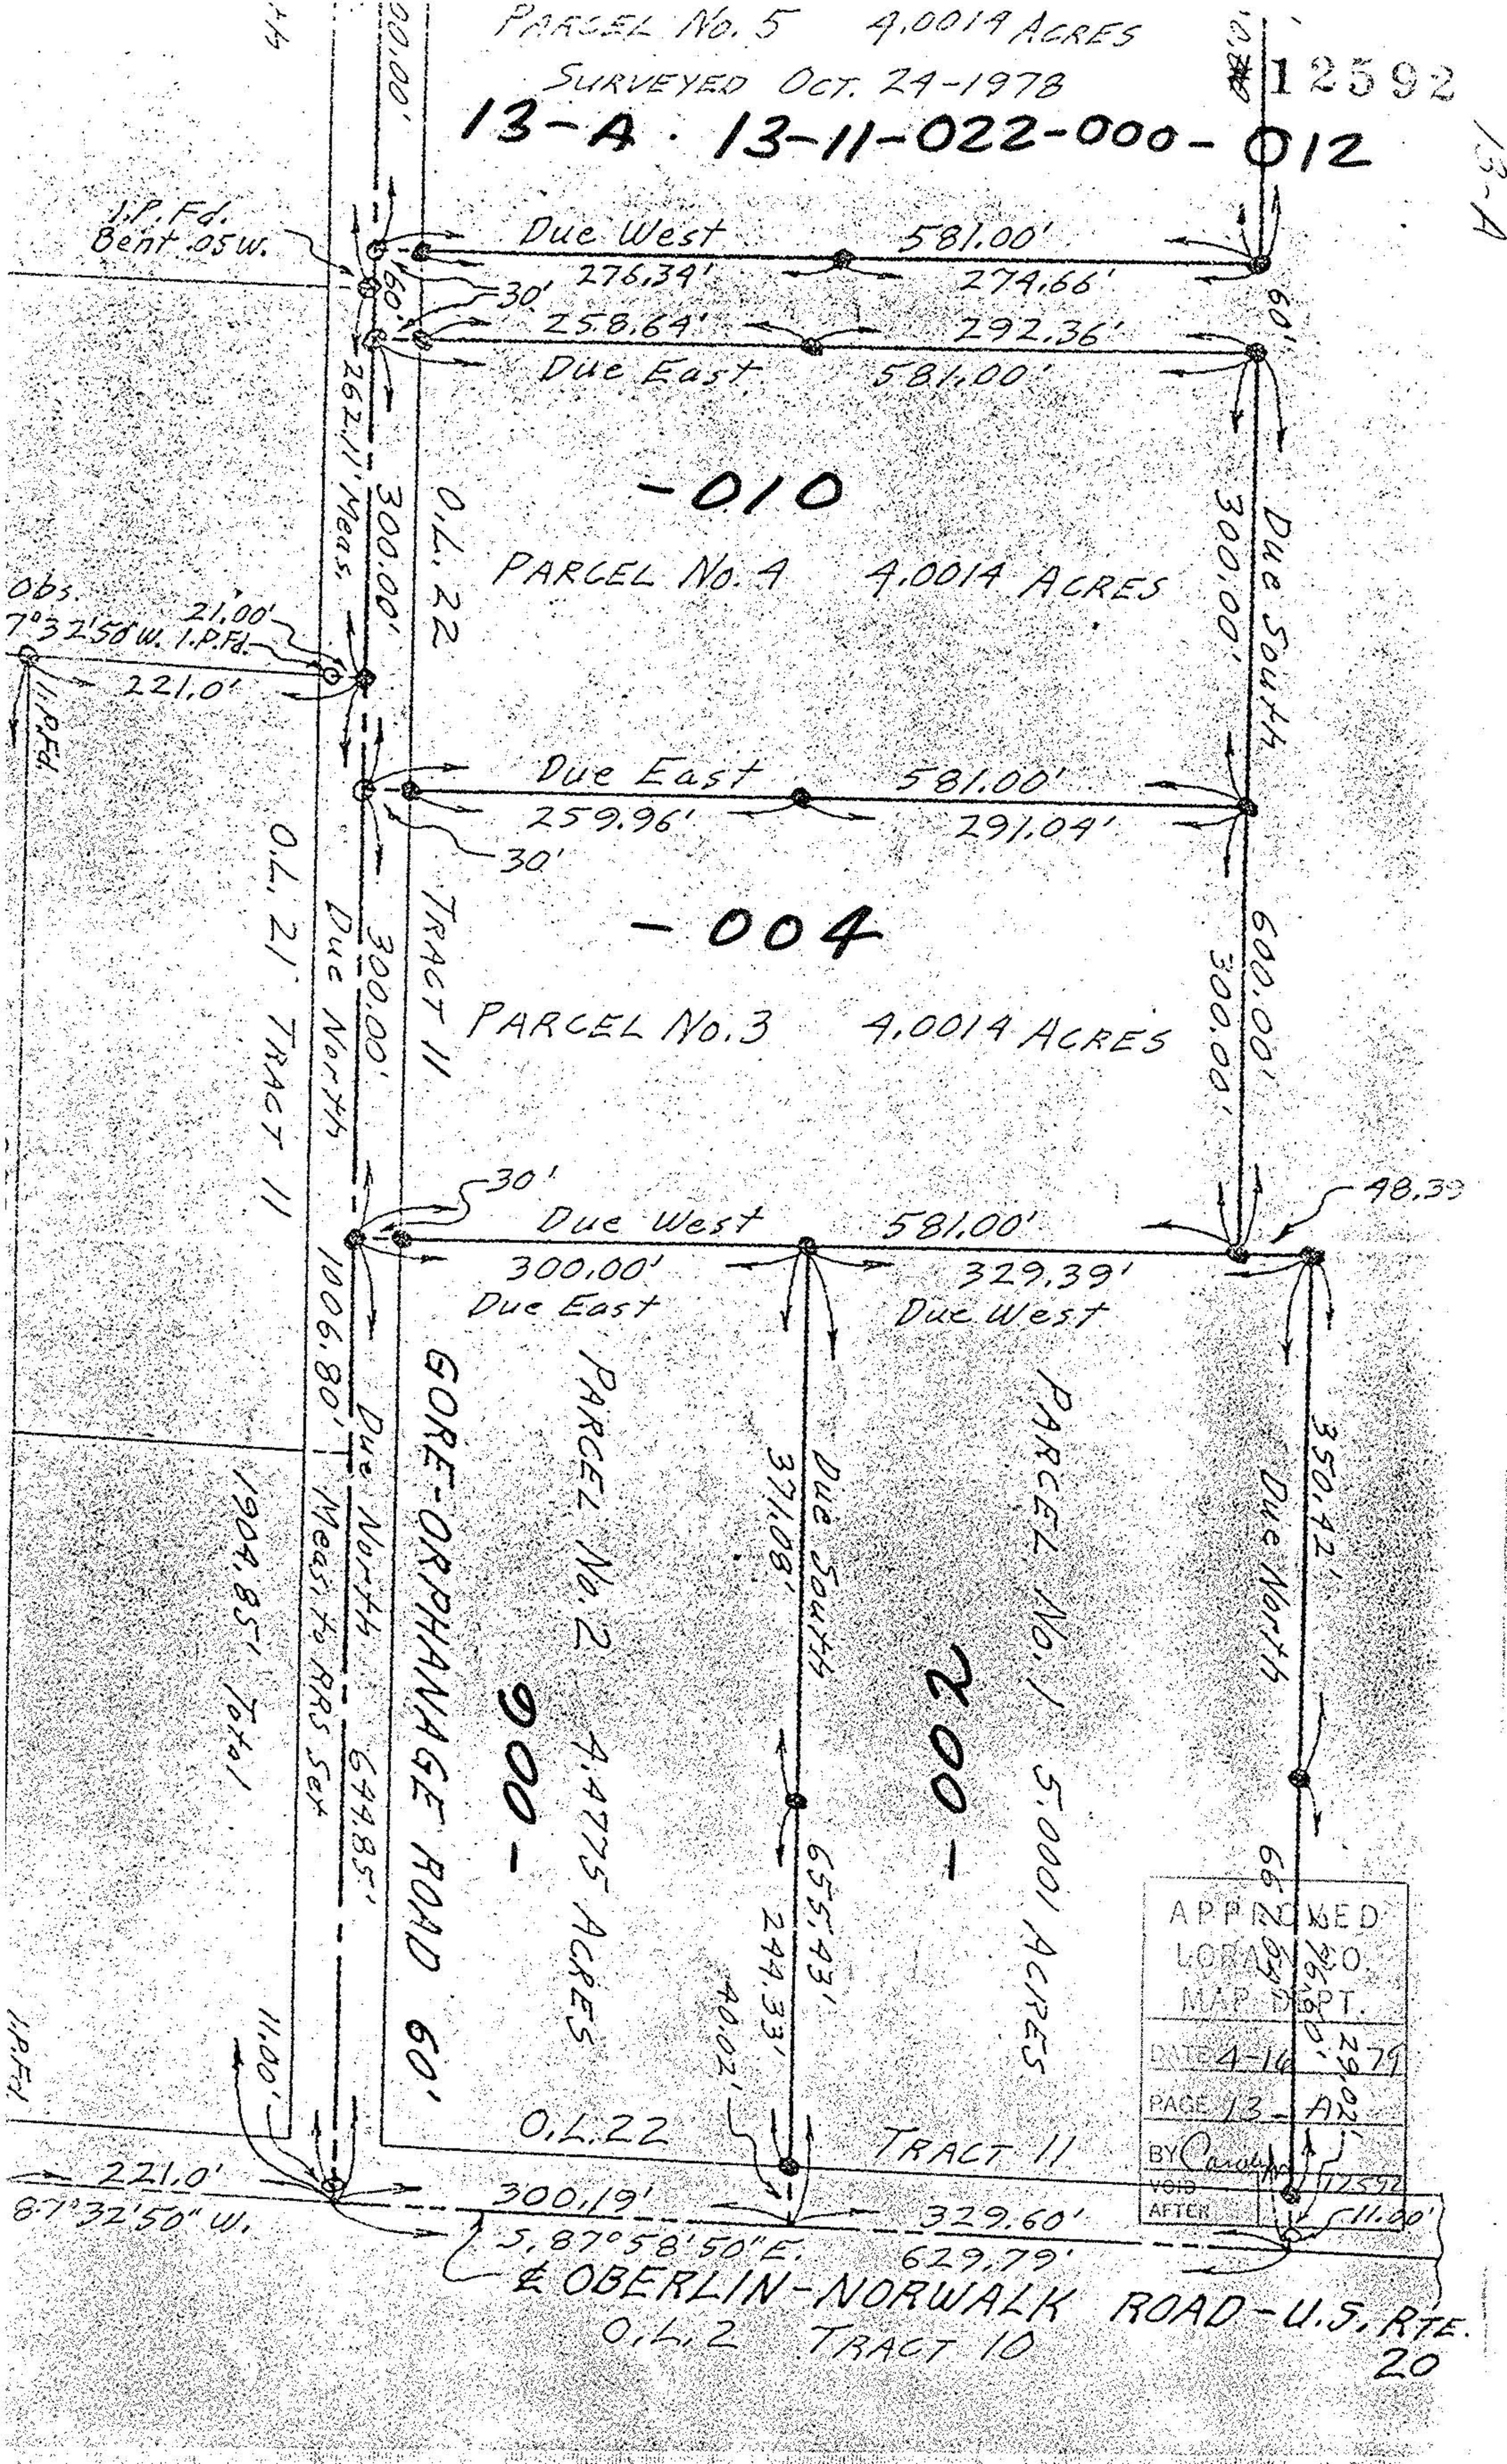

O.L. 22 TRACT 10  
 5, 87° 58' 50" E. 629.79'  
 & OBERLIN-NORWALK ROAD - U.S. RTE. 20