


Reminder - Andrew J. Clark & Ruth A. Clark
Volume 515, Page 113

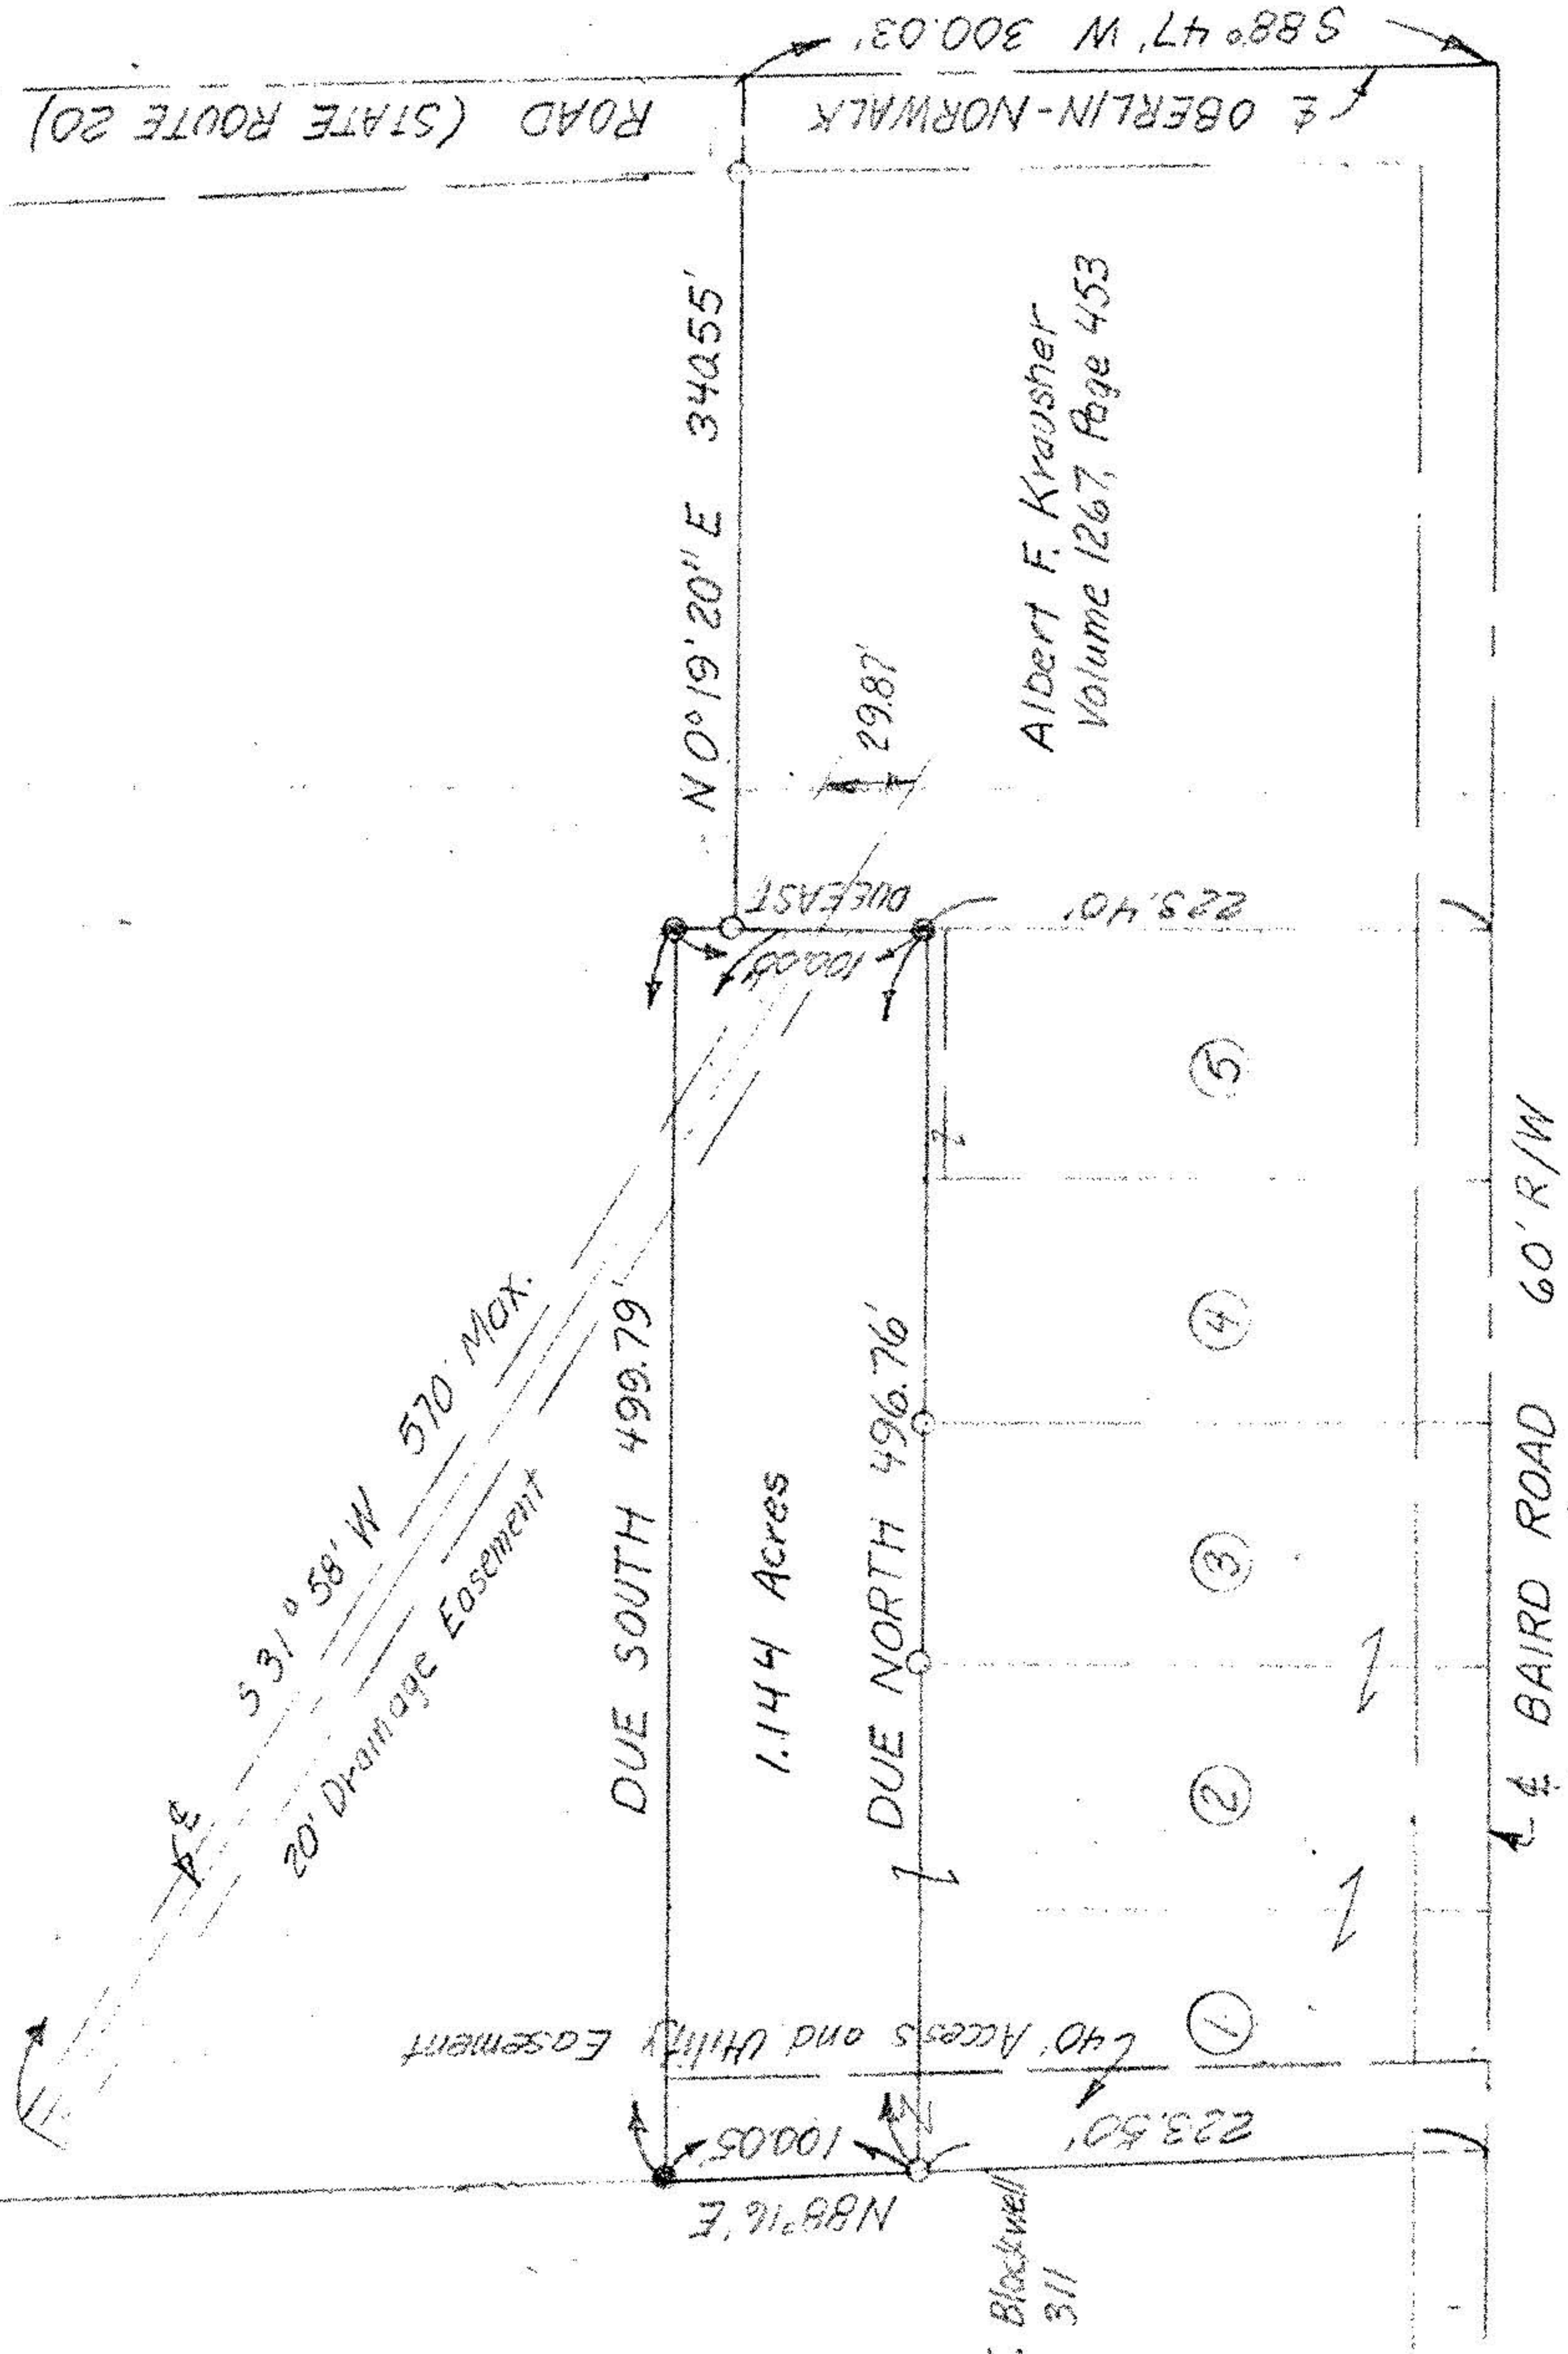


Ralph E & Edith E. Blackwell
Volume 152, Page 311

Albert F. Krausner
Volume 1267, Page 453

#18455
APPROVED
LORAIN CO.
MAP DEPT.
DATE 5-26-89
PAGE 13-B
BY *Carol Francis*
VOID AFTER # 18455

- ① Marvin B. & Judith E. Fannin Volume 1131, Page 522
- ② Marvin B. & Judith E. Fannin Volume 1243, Page 105
- ③ Marvin B. & Judith E. Fannin Volume 1164, Page 266
- ④ Dale L. & Karen C. Husted Volume 1131, Page 526
- ⑤ Ralph P. & Andrea Piotrowski Volume 1065, Page 412

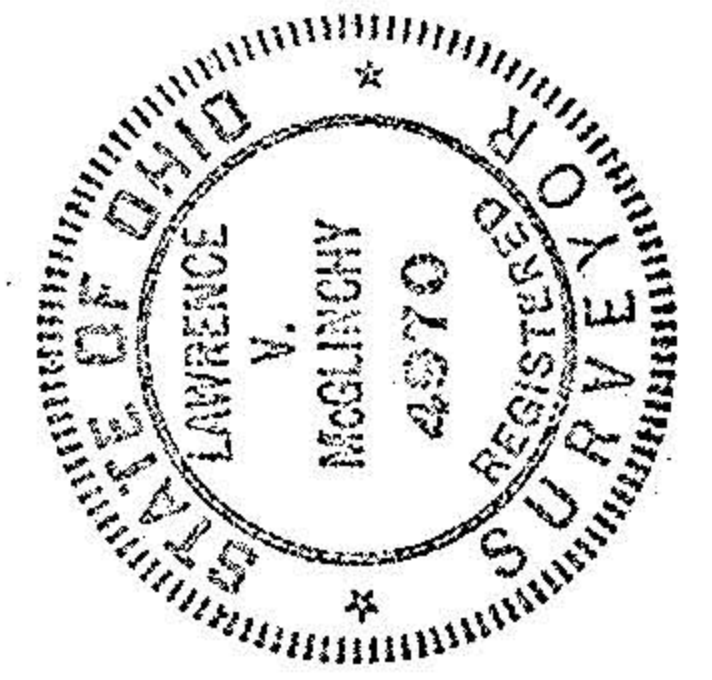

PLAT OF SURVEY FOR
MARVIN B. & JUDITH E. FANNIN
O.L. 3, TRACT 10, CAMDEN TWP.
LORAIN COUNTY, OHIO
McGLINCHY & ASSOCIATES
AMHERST, OHIO 3-8-89
1" = 100'
Job # 898775
Revised 3-14-89

- Iron Pipe Set
- Iron Pipe Found