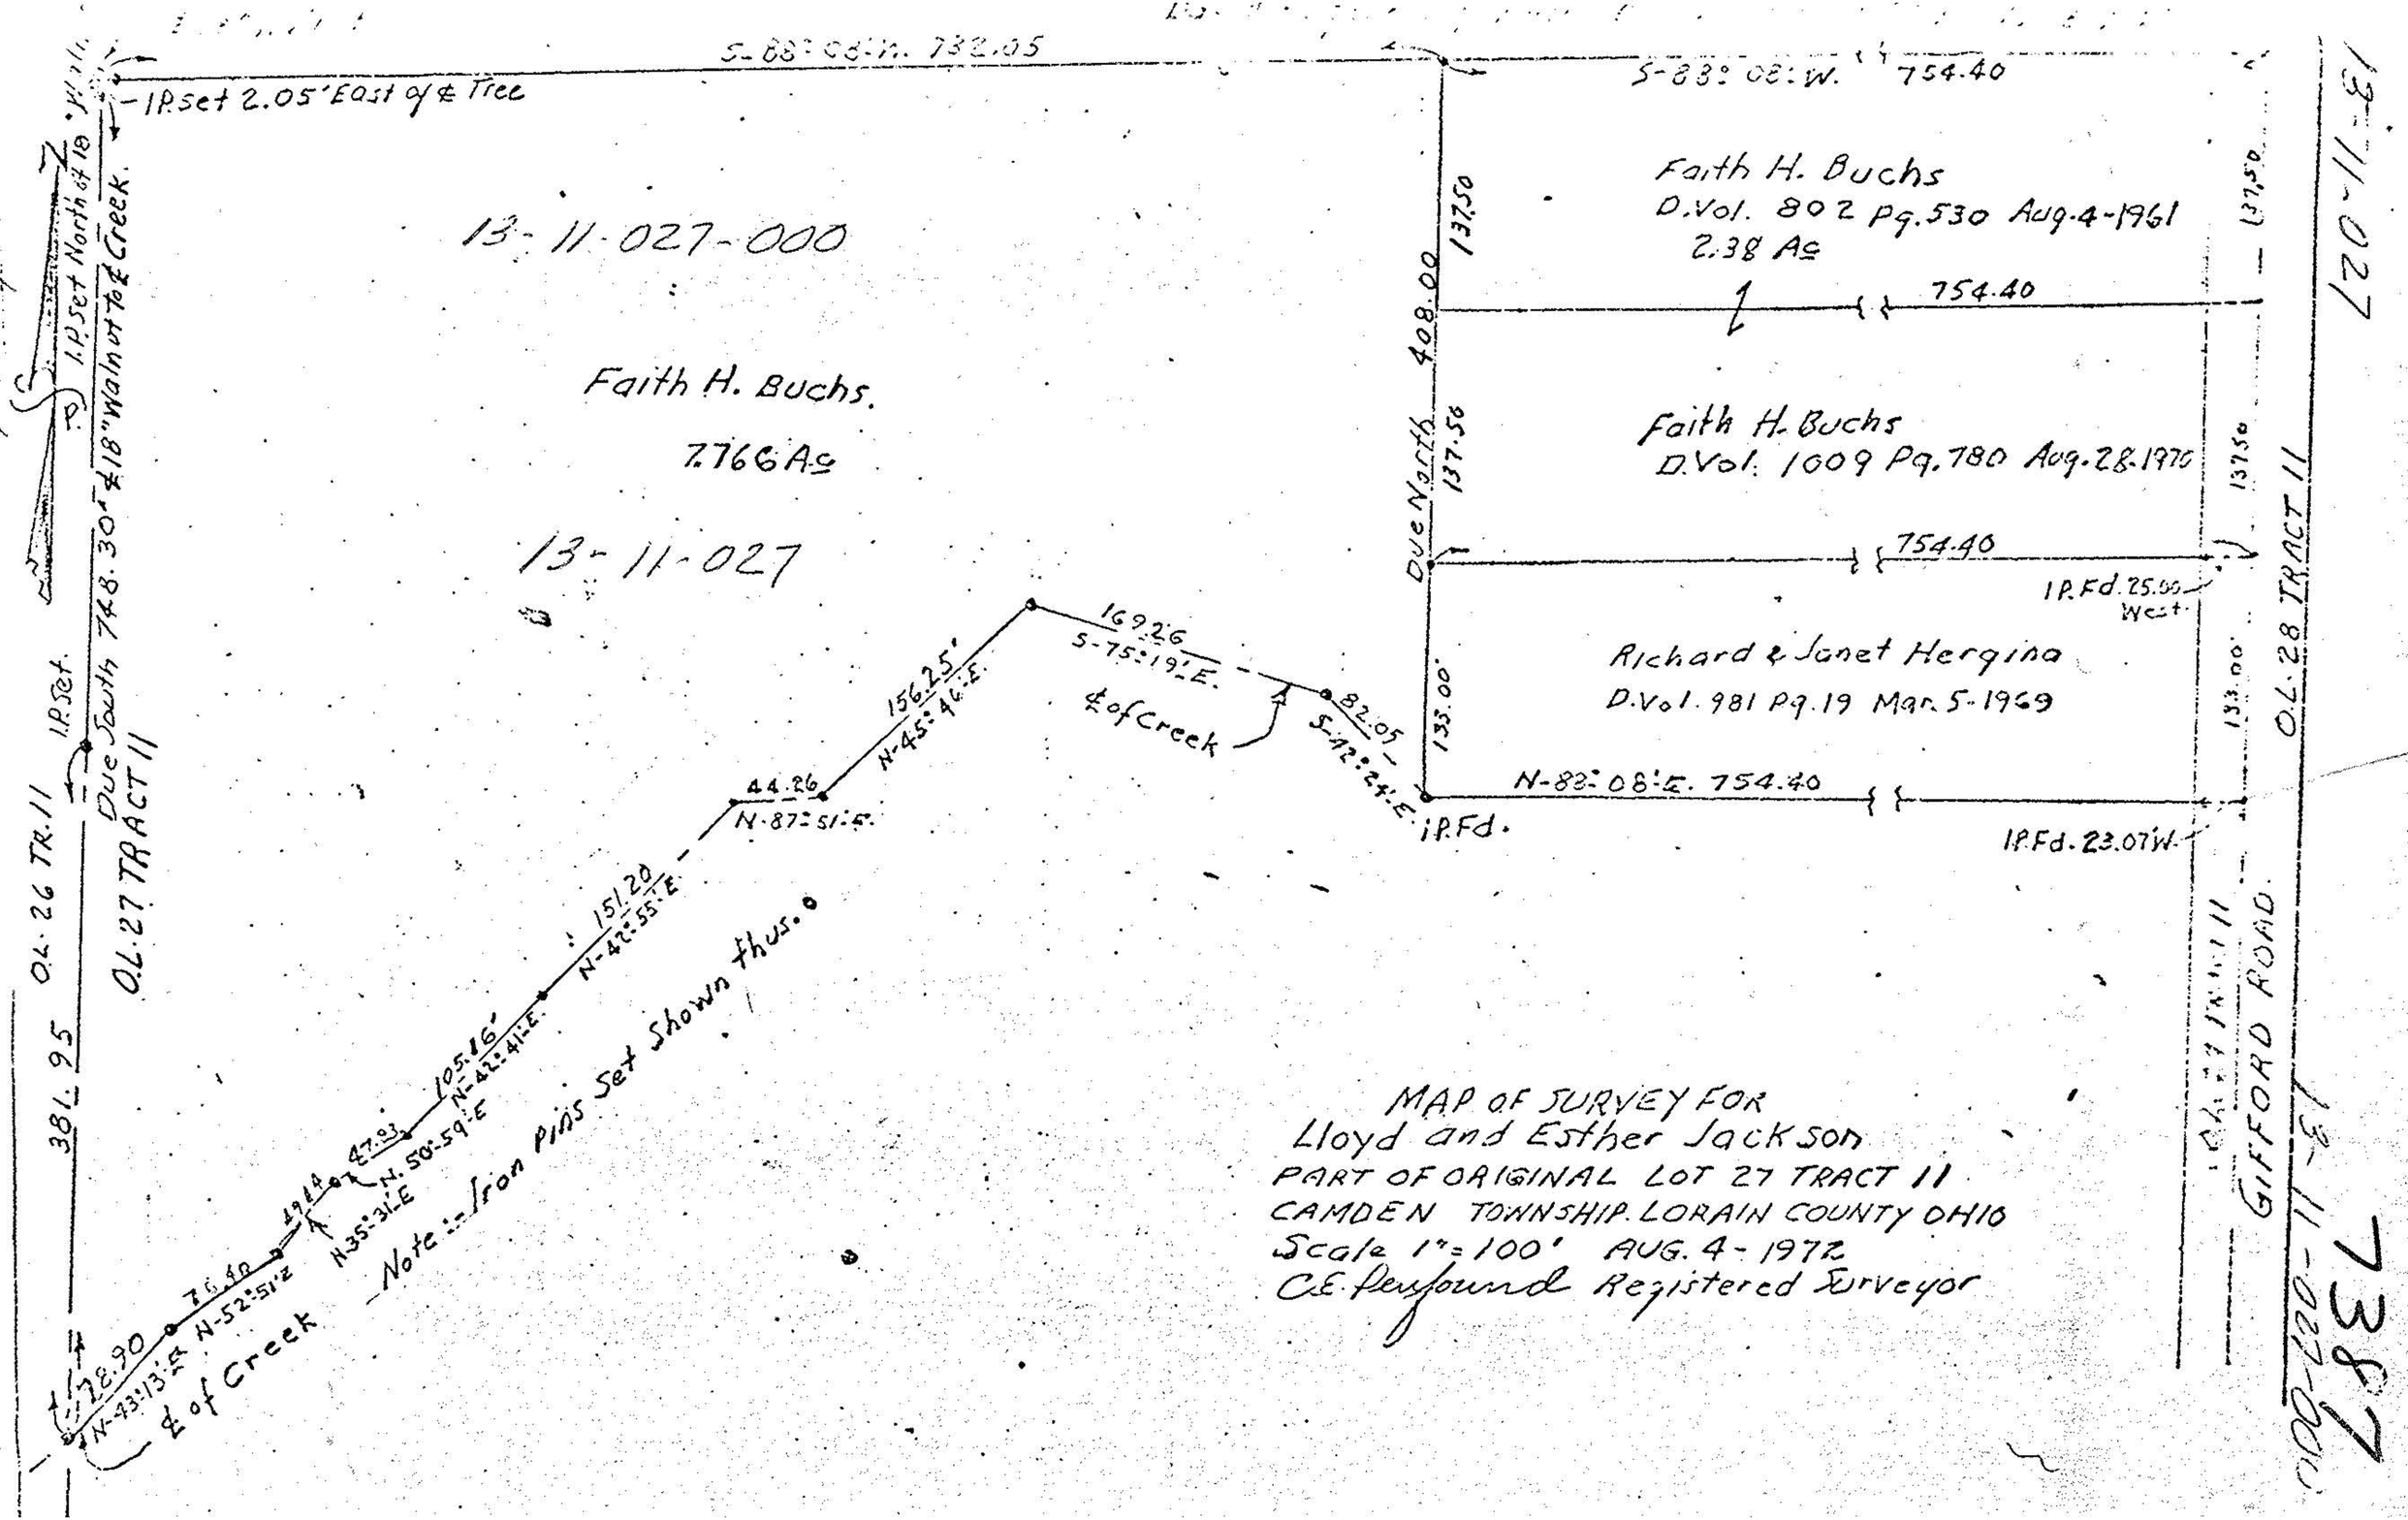

MAP OF SURVEY FOR
Lloyd and Esther Jackson
PART OF ORIGINAL LOT 27 TRACT 11
CAMDEN TOWNSHIP. LORAIN COUNTY OHIO
Scale 1"=100' AUG. 4-1972
C.E. Penfound Registered Surveyor