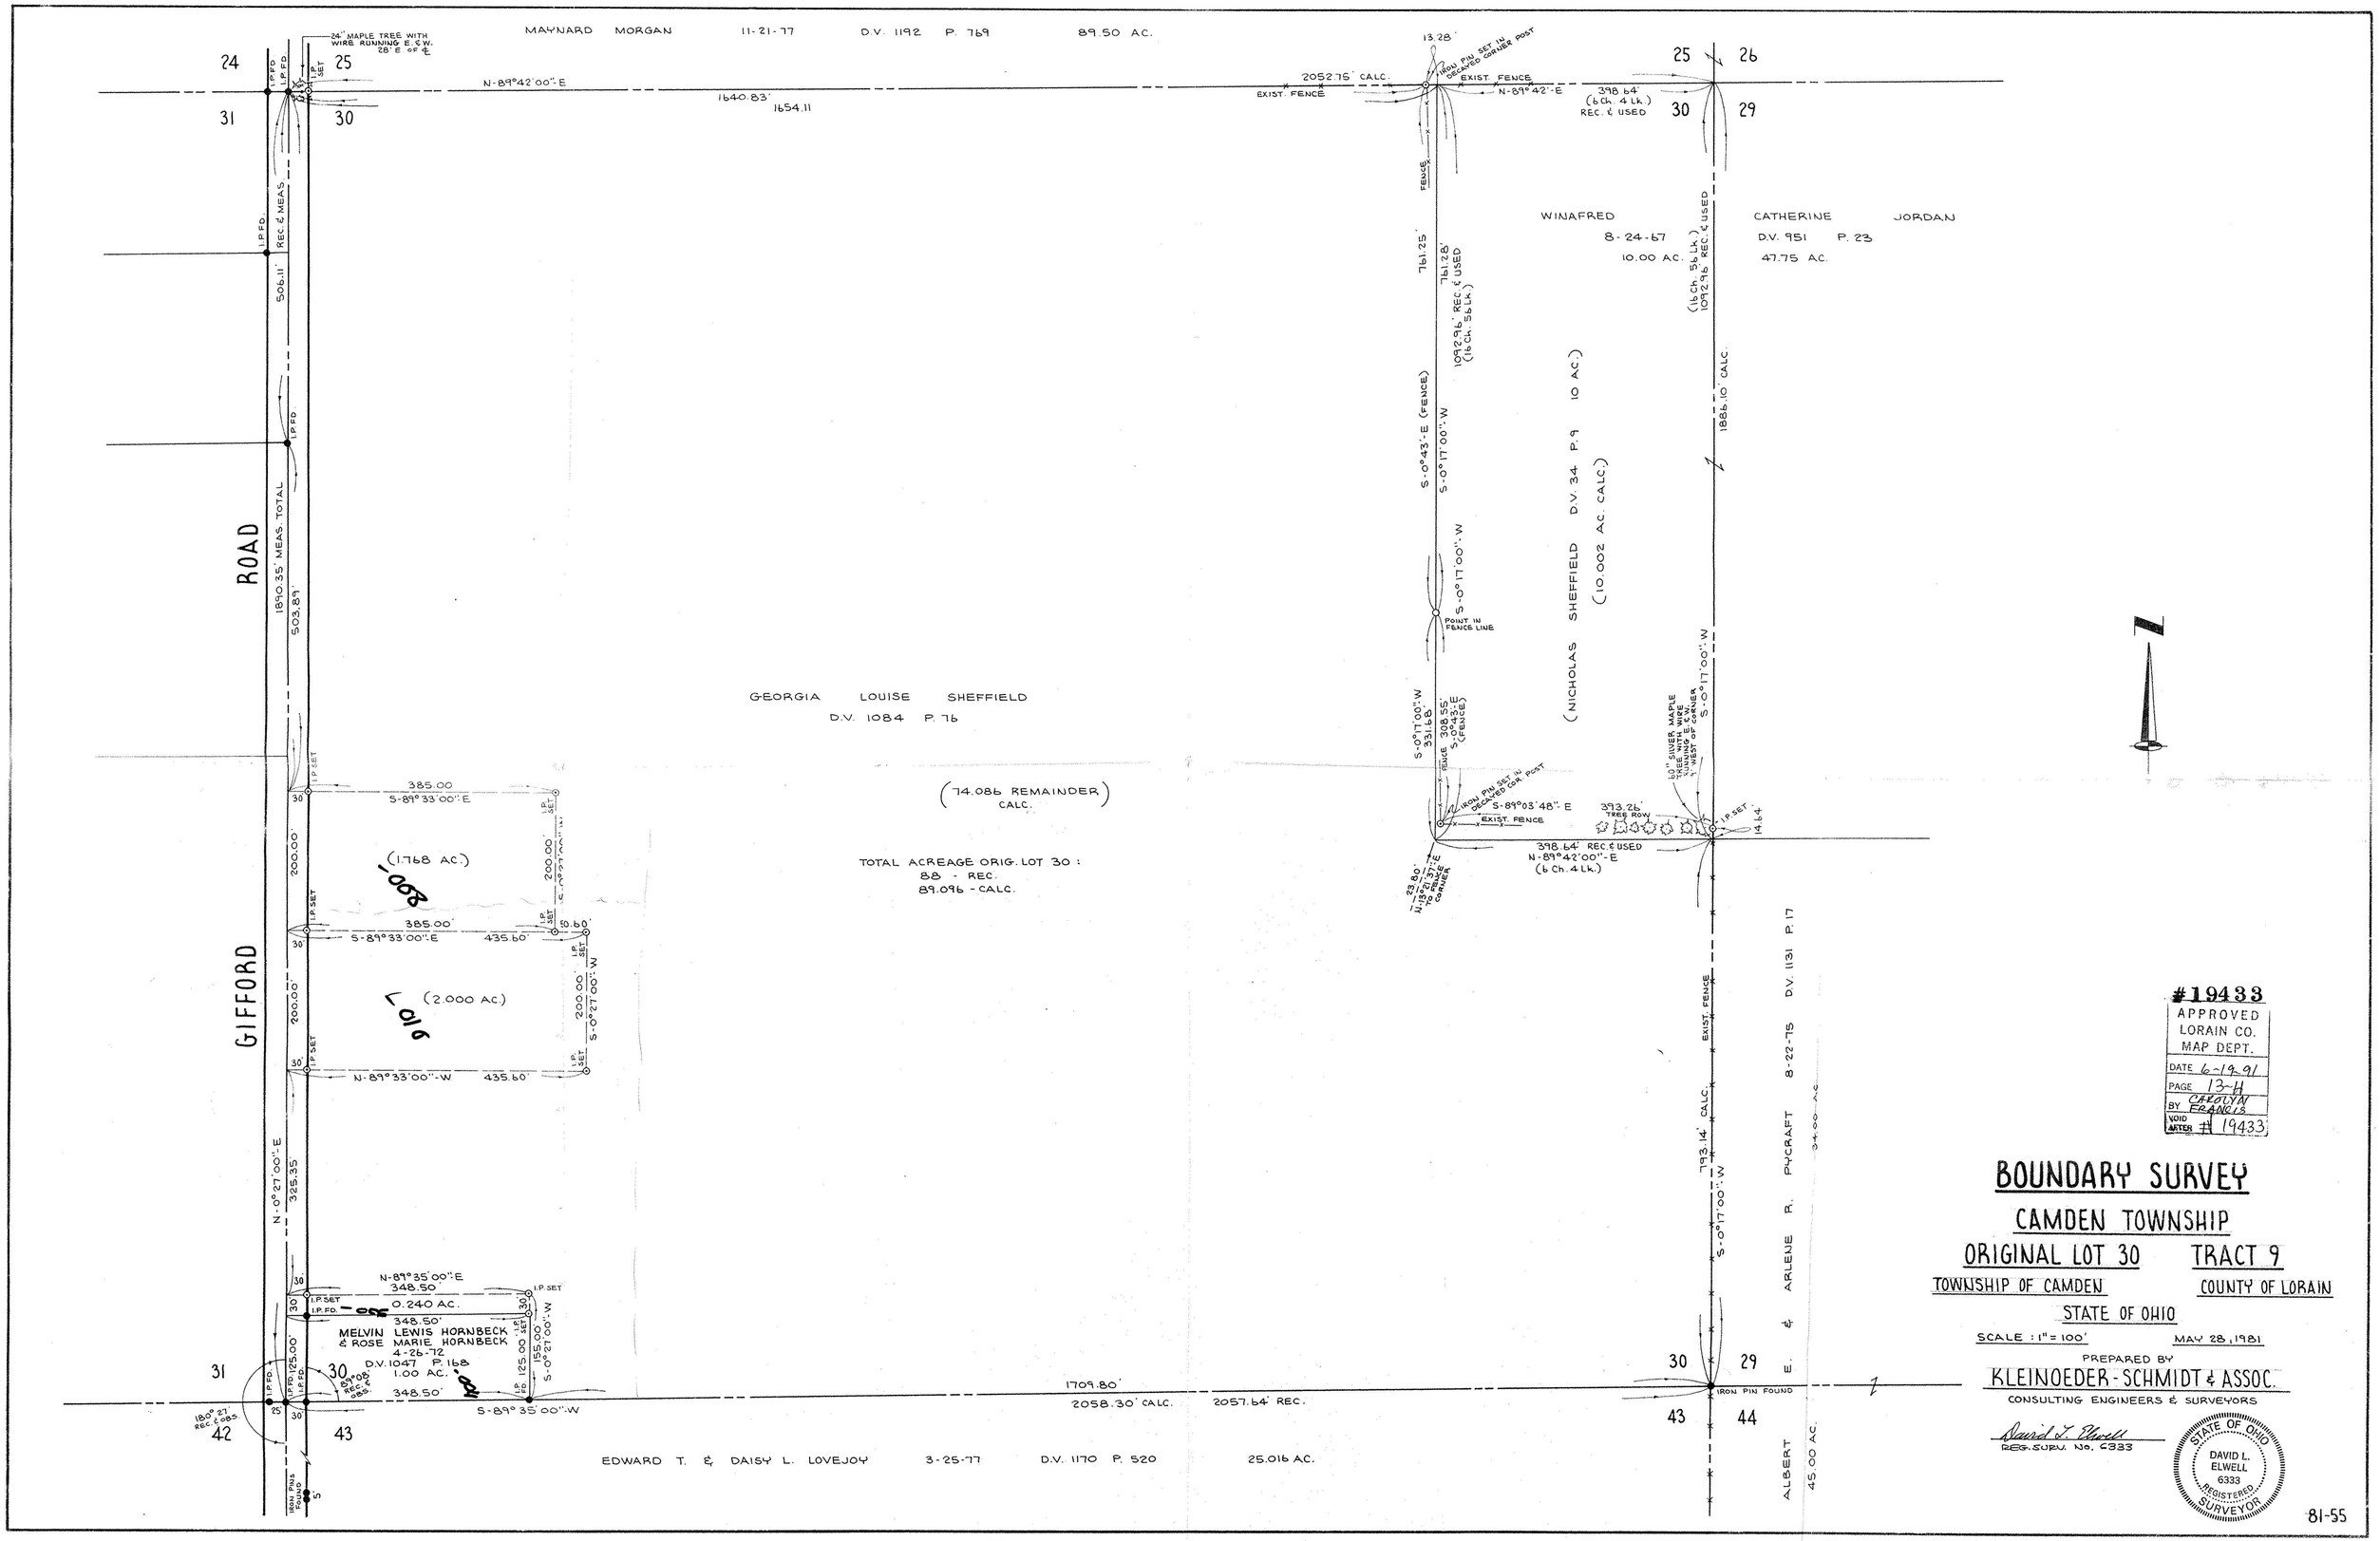

#19433
APPROVED
LORAIN CO.
MAP DEPT.
DATE 6-19-91
PAGE 13-H
BY CAROLYN FRANCIS
VOID AFTER # 19433

BOUNDARY SURVEY

CAMDEN TOWNSHIP

ORIGINAL LOT 30 TRACT 9

TOWNSHIP OF CAMDEN COUNTY OF LORAIN

STATE OF OHIO

SCALE : 1" = 100' MAY 28, 1981

PREPARED BY

KLEINOEDER - SCHMIDT & ASSOC.

CONSULTING ENGINEERS & SURVEYORS

David L. Elwell

REG. SURV. No. 6333

STATE OF OHIO
DAVID L. ELWELL
6333
REGISTERED SURVEYOR

81-55