LAUNDON . SIMON . CAHL & ASSOC. INC.
CONSULTING ENGINEERS & SURVEYORS
219 COURT ST. ELYRIA, OHIO 44035

SURVEY for:
# TED SCHULLER

| | | |
|---|---|---|
| g. Lot 12 | City of | Date SEPT. '91 Scale 1" = 200' |
| rig. Sec | Village of | Dwn. by R.G.S. Chkd. by R.C. |
| Tract 9 | County of LORAIN | Job No. 91-2101 F.B. |
| Township of CAMDEN | State of OHIO | Printed OCT 4 |

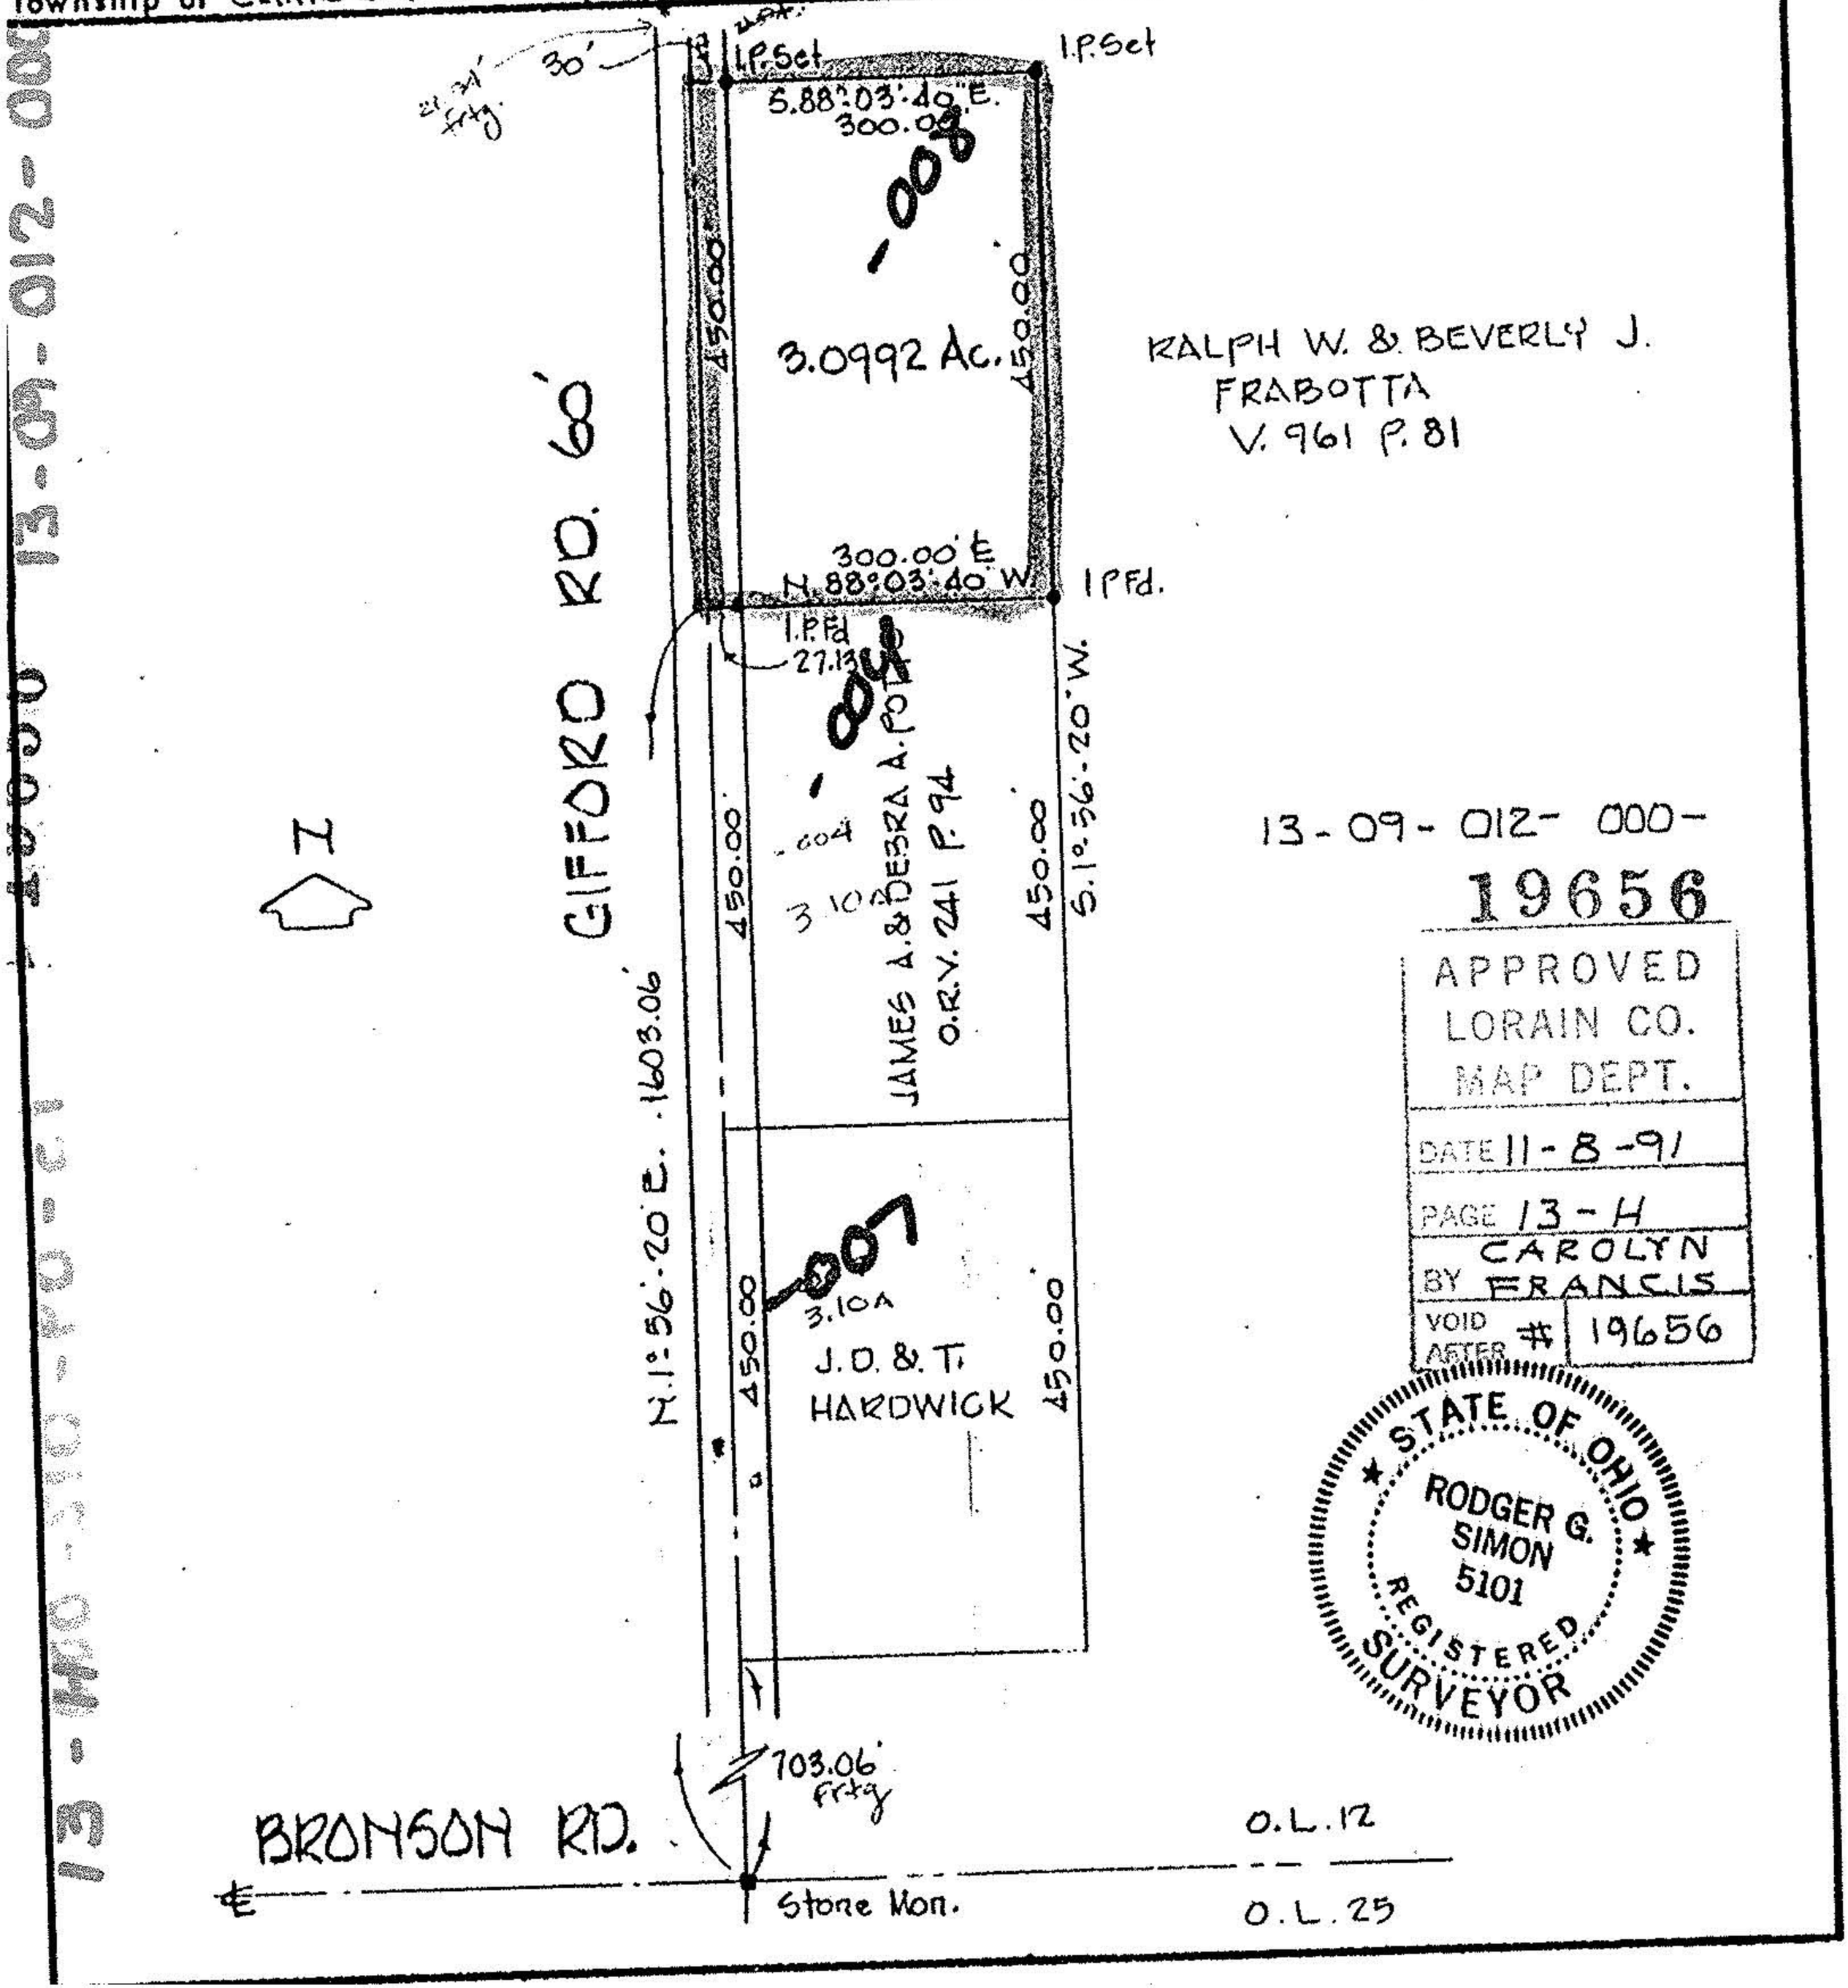


13-09-012-000-008

13-09-012-000-004

13-09-012-000-007

13-09-012-000-

19656

APPROVED
LORAIN CO.
MAP DEPT.
DATE 11-8-91
PAGE 13-H
BY CAROLYN FRANCIS
VOID AFTER # 19656

STATE OF OHIO
RODGER G. SIMON
5101
REGISTERED SURVEYOR