13-09-021-000

Map of Part of Lot 21 and 34 Tract 9 Camden Twp. Lorain Co. Ohio
MAY 2, 1979
By Arnold F. Koepp Reg. Surveyor No. 4306

Map and survey revised June 28, 1988

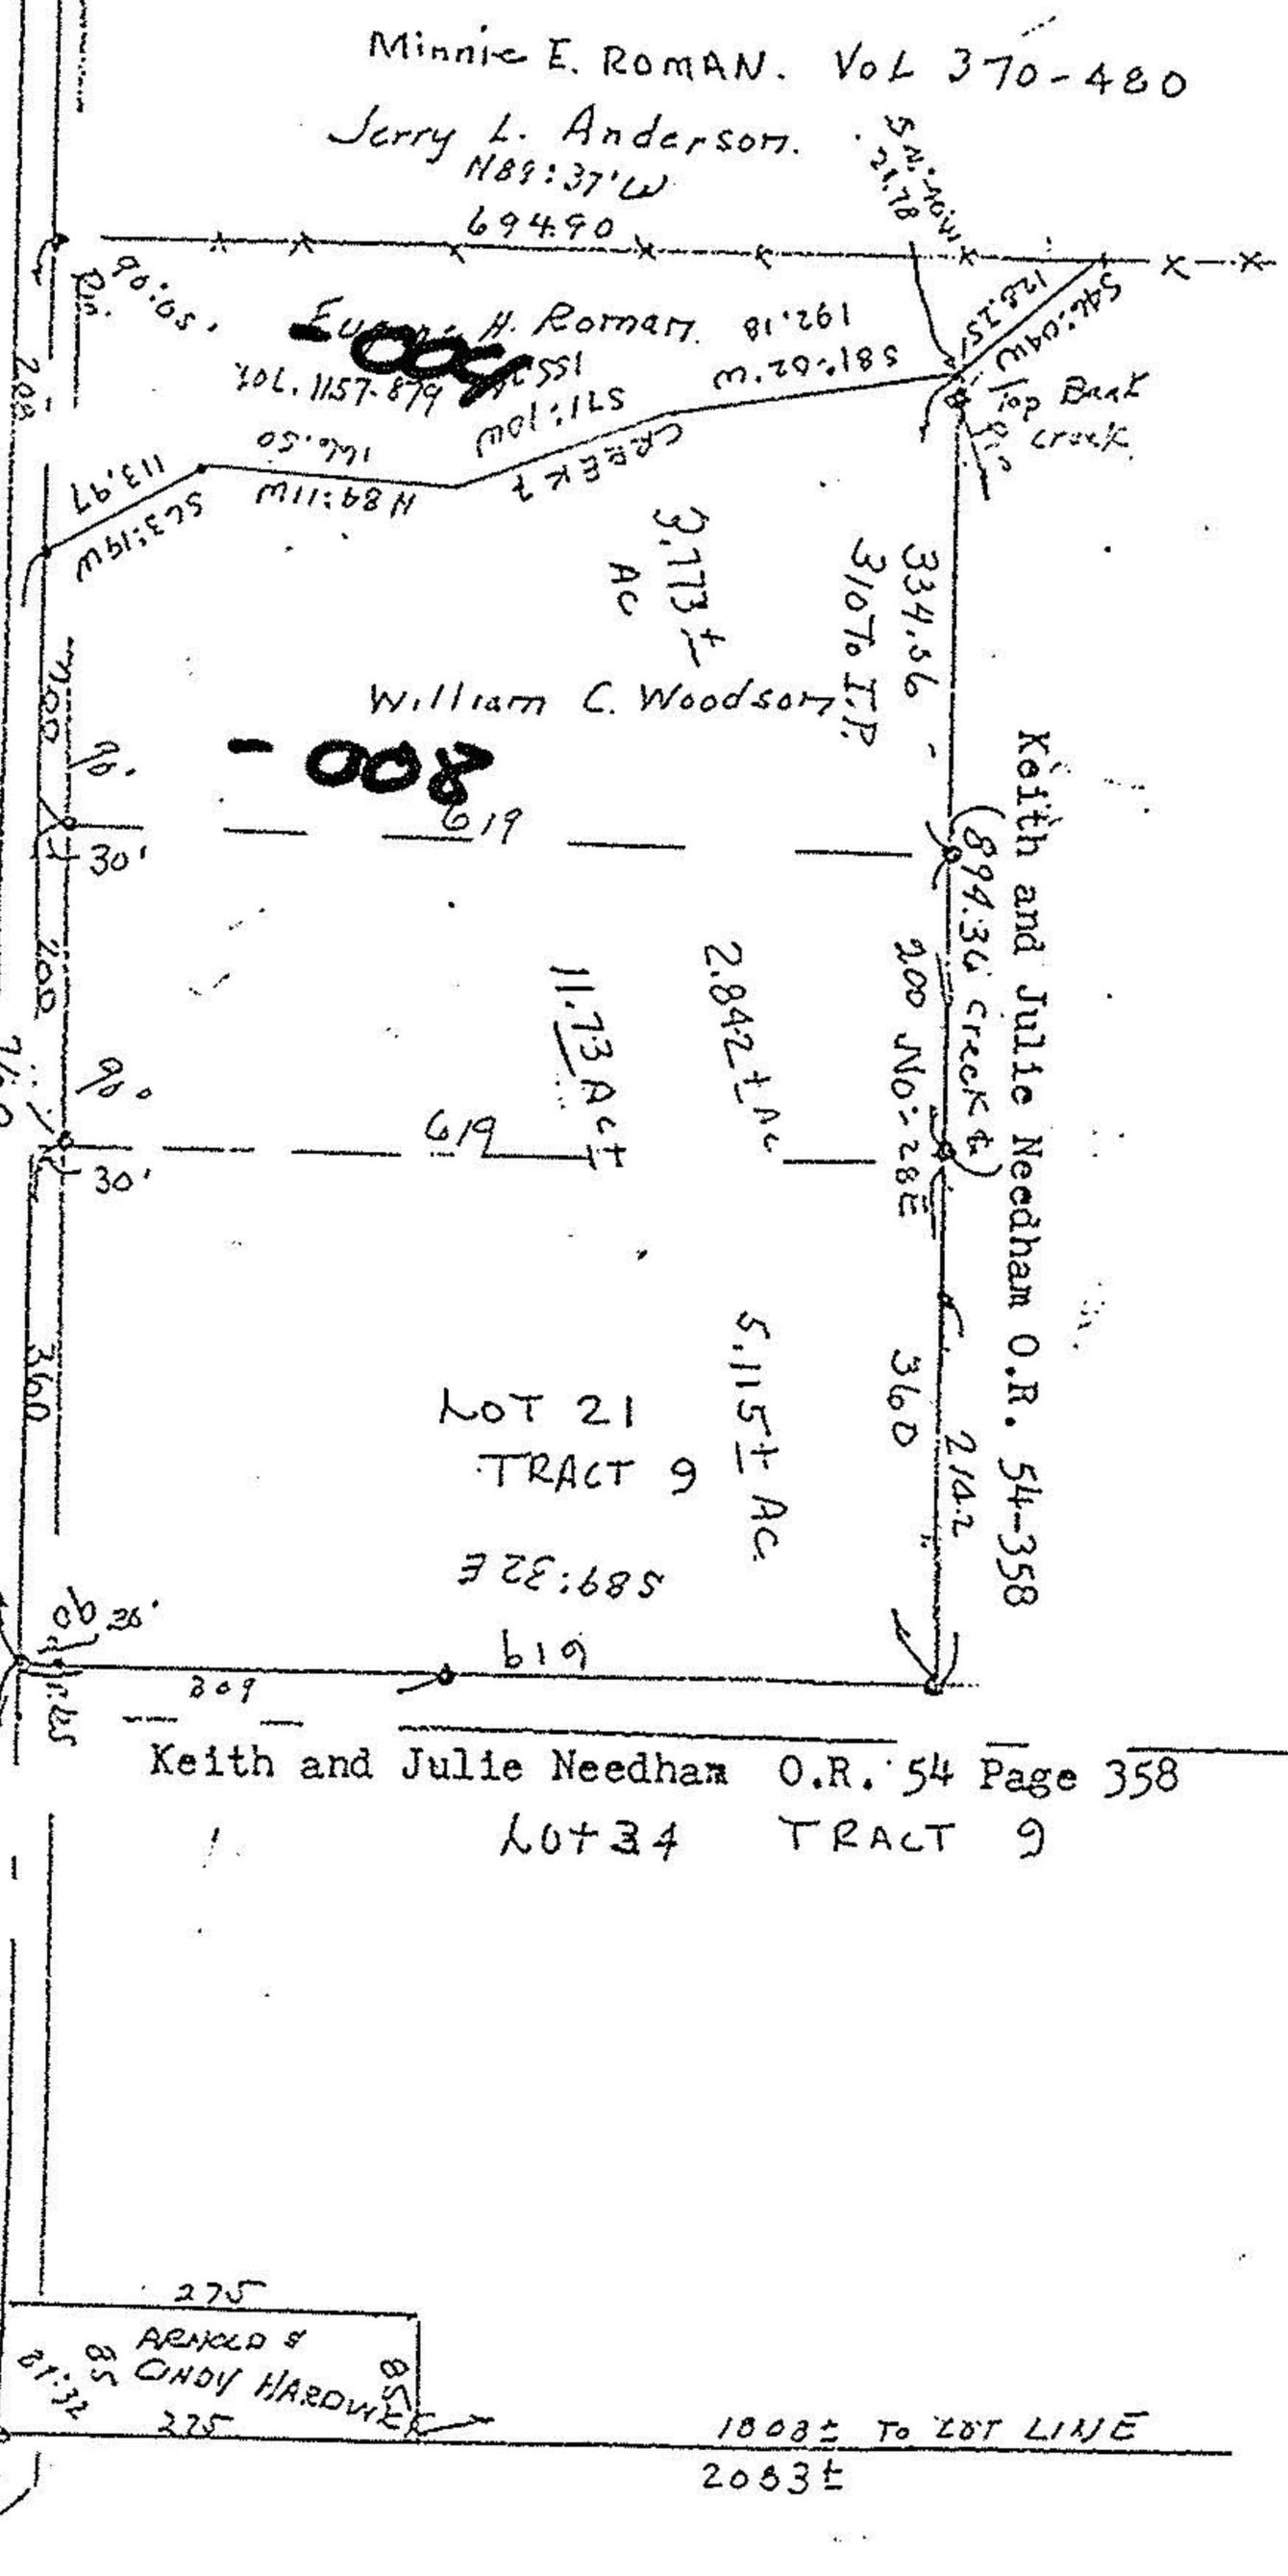

13-09-021-000-008

BAIRD ROAD

#18068

APPROVED
LORAIN CO.
MAP DEPT.
DATE 8-4-88
PAGE 13-F
BY C. Francis
VOID AFTER # 18068