


MAP OF SURVEY

13-11-001
13-A

13-11-001-000-008

Part of Lot No. 1, Tract II
Canden Twp. Lorain Co., Ohio
Scale 1"=200ft. Nov. 20, 1975
Survey by William L. Fox
Registered Surveyor No. 5878

9281
13A

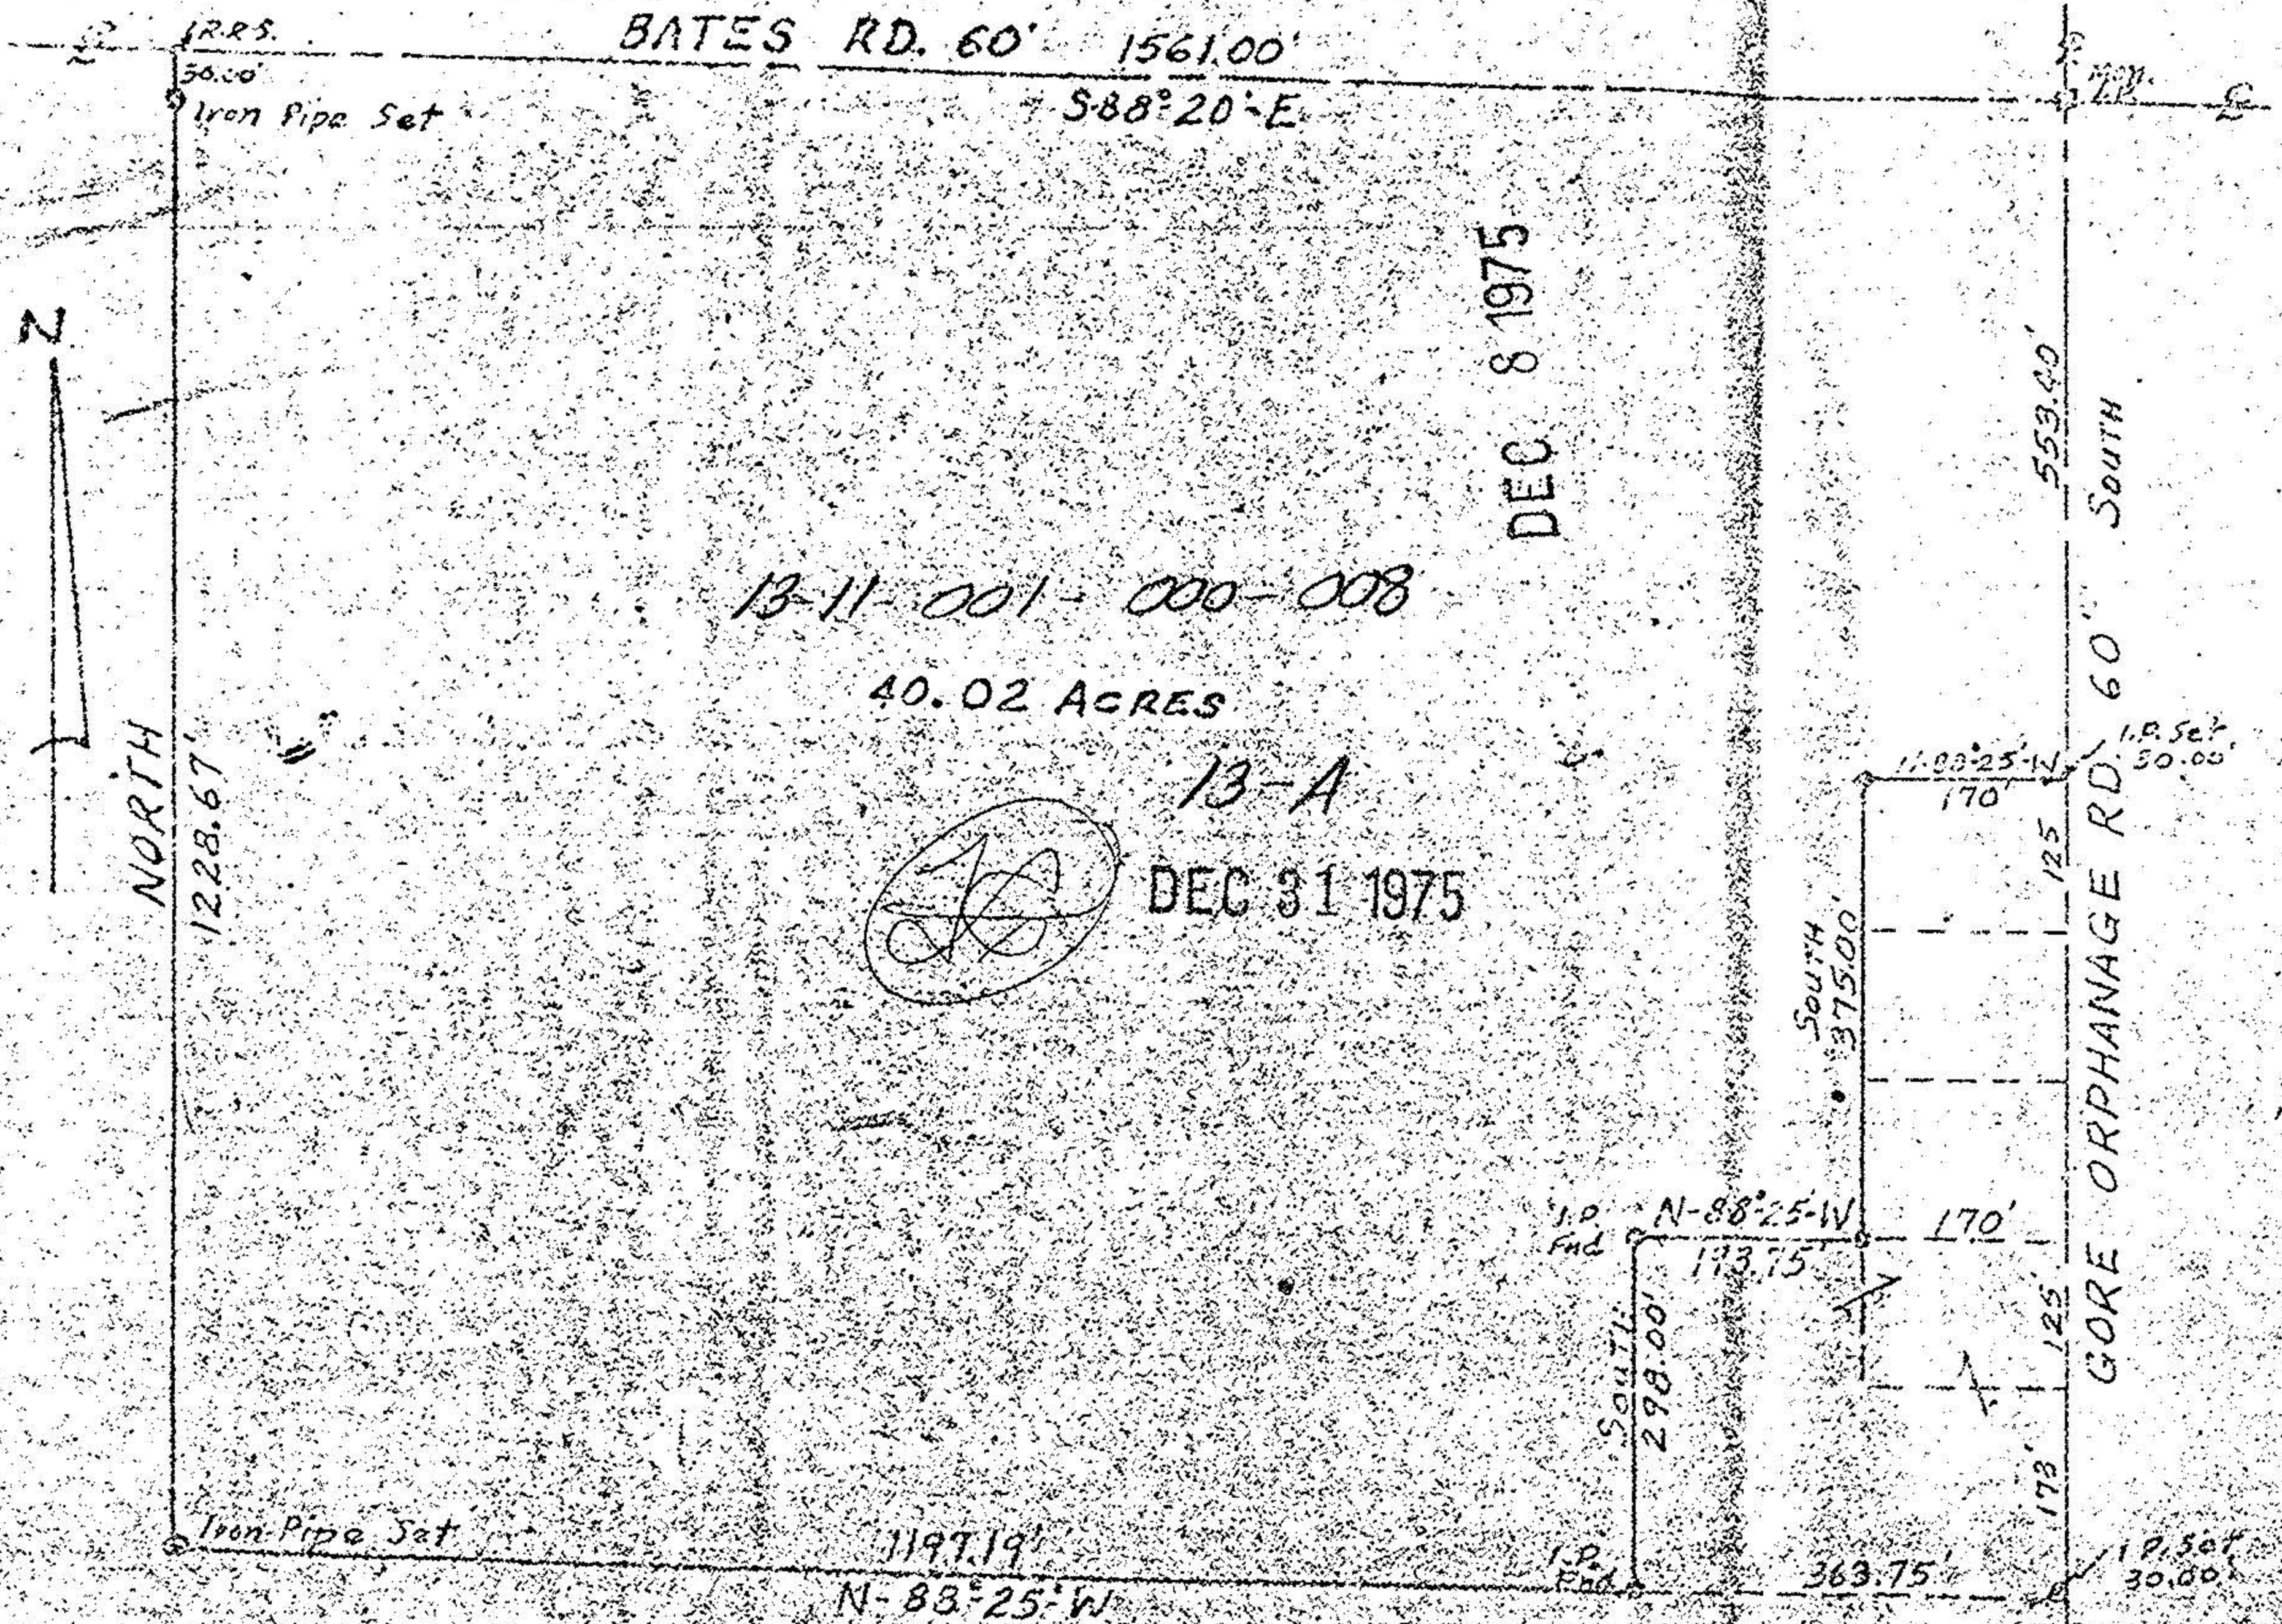


13-11-001-000-008

40.02 ACRES

13-A

DEC 31 1975

DEC 8 1975

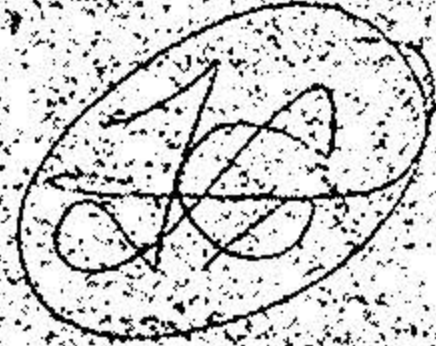

Owners: James & June Buchs

1 P. Set
30.00'

13-11-001-000-008