13-C #16822 15-10-014.000

Survey map of part of Lot 12 Tract 10 Camden Twp. Lorain Co. Ohio
Scale 1" 300' May 5, 1986
By Arnold F. Koepp Reg. Surveyor No. 4306

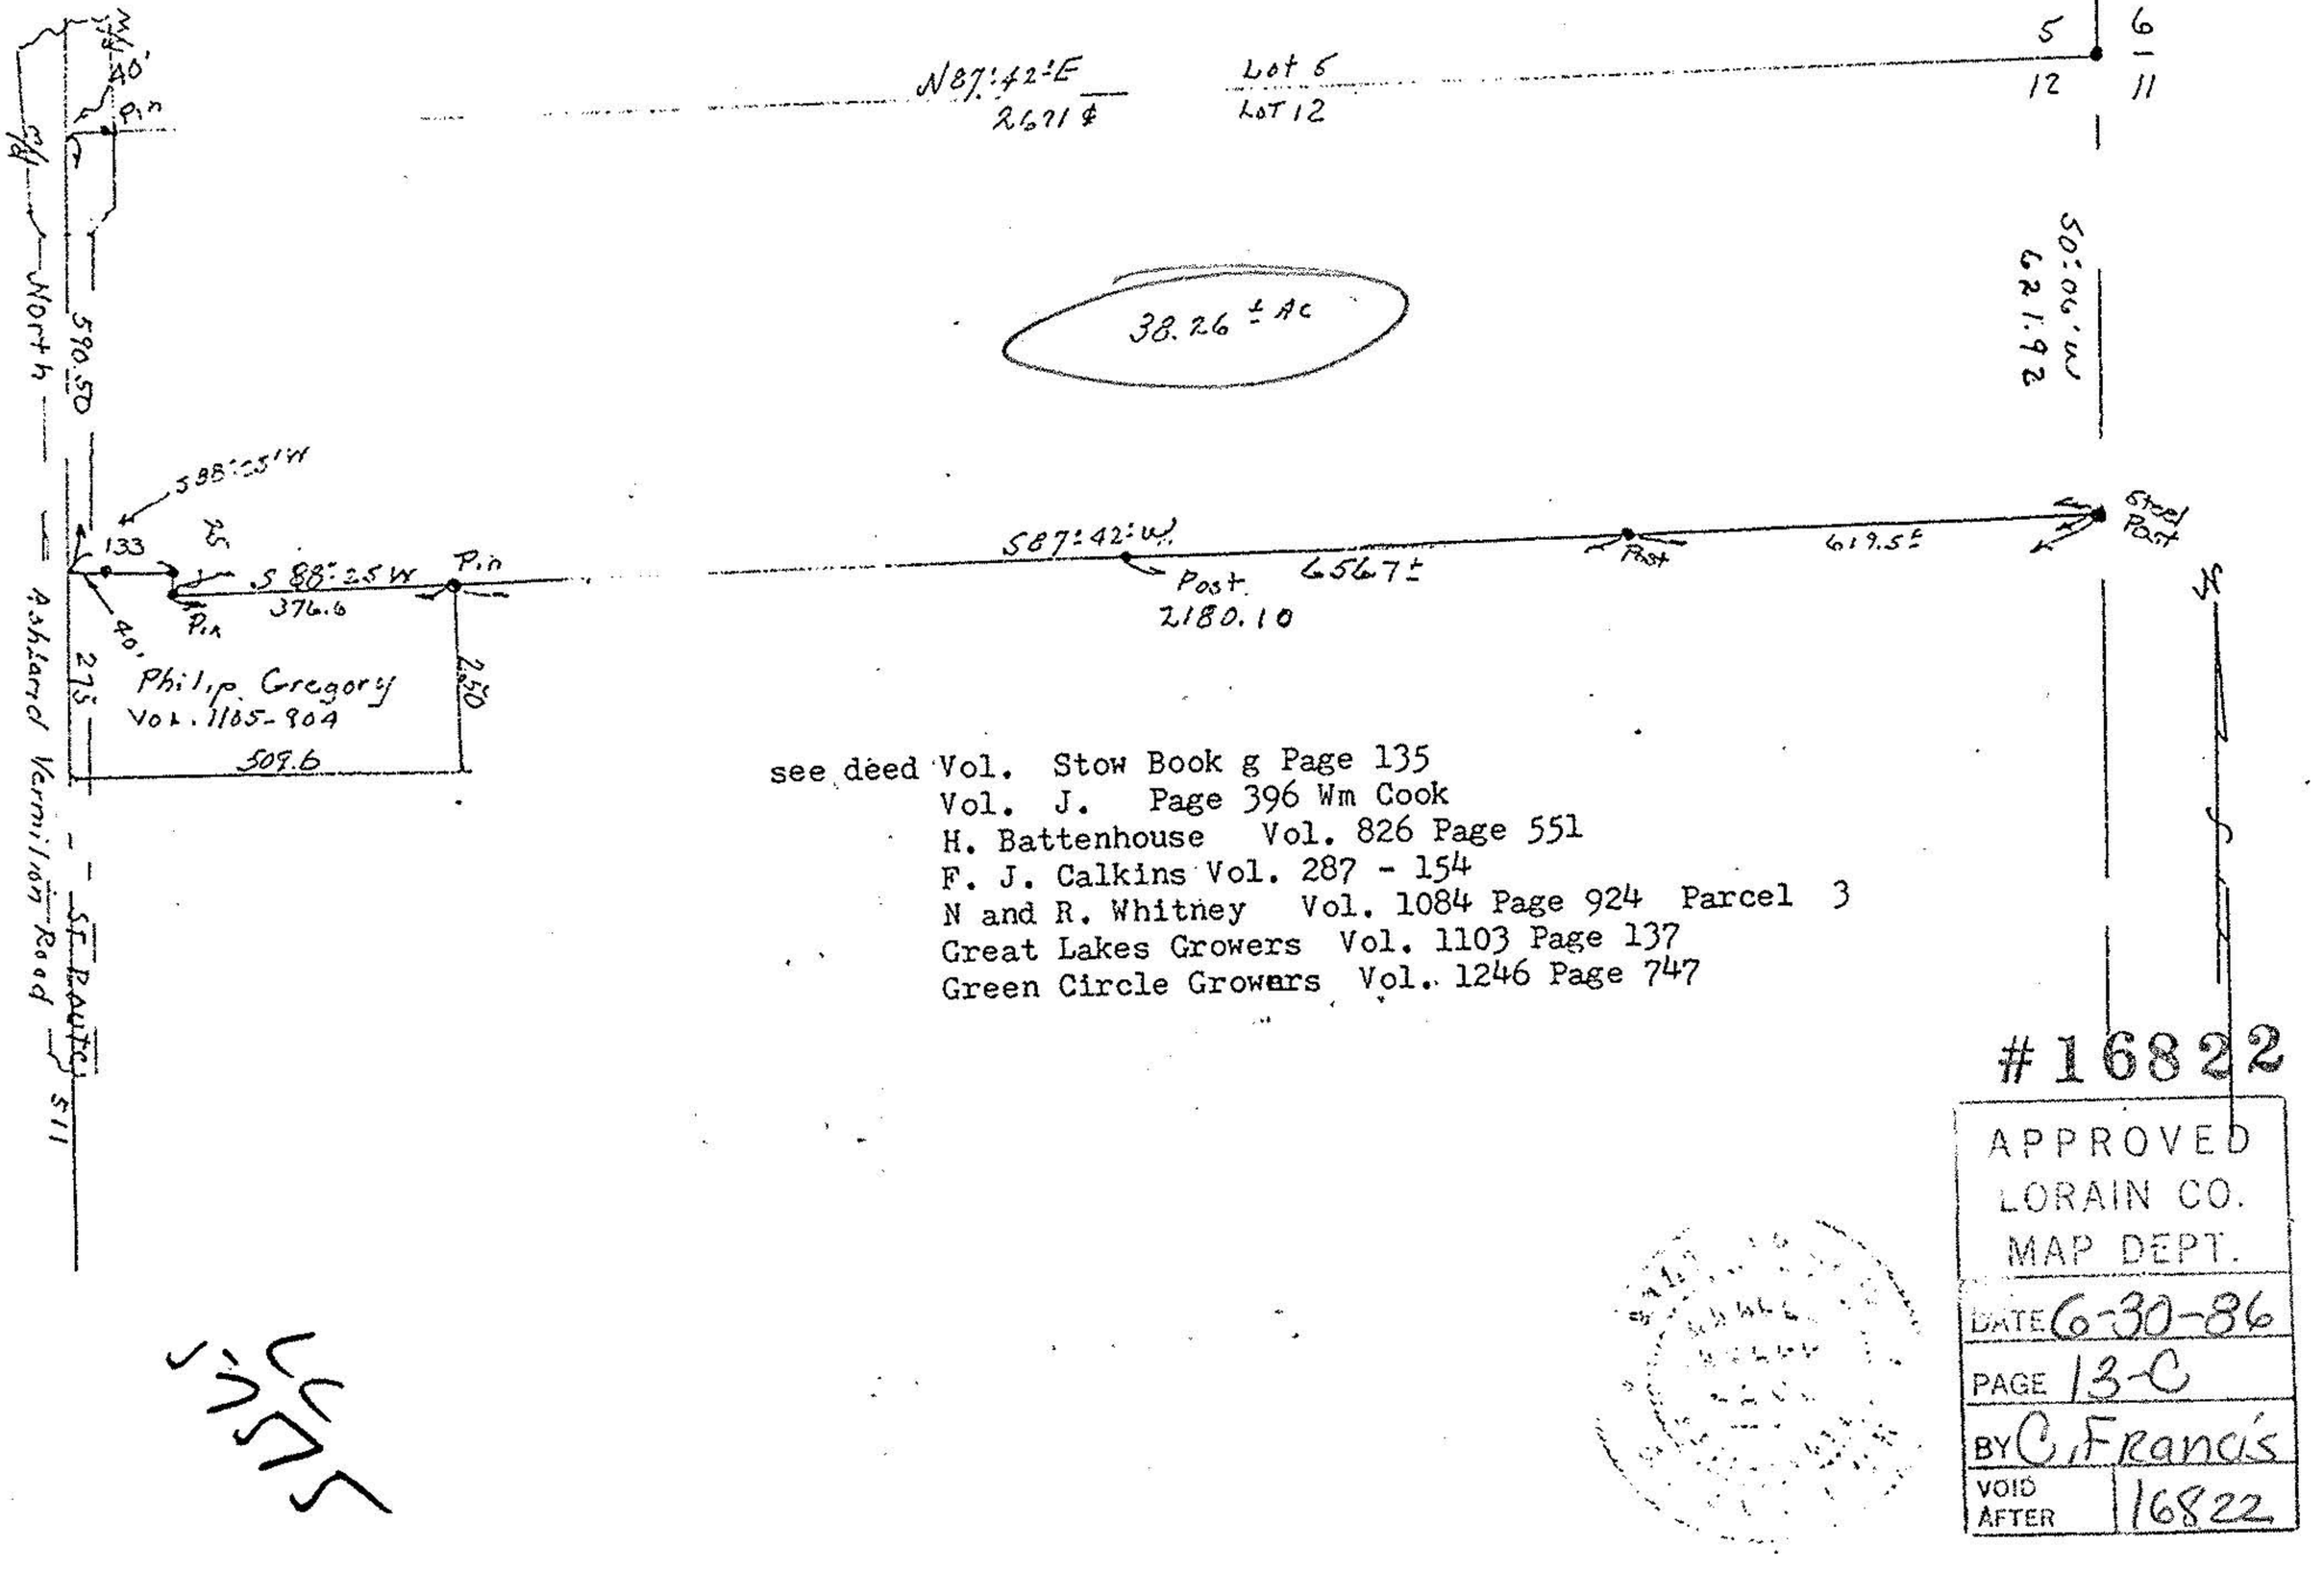

see deed Vol. Stow Book g Page 135
Vol. J. Page 396 Wm Cook
H. Battenhouse Vol. 826 Page 551
F. J. Calkins Vol. 287 - 154
N and R. Whitney Vol. 1084 Page 924 Parcel 3
Great Lakes Growers Vol. 1103 Page 137
Green Circle Growers Vol. 1246 Page 747

#16822

APPROVED
LORAIN CO.
MAP DEPT.
DATE 6-30-86
PAGE 13-C
BY C. Francis
VOID AFTER 16822