13-H-043-000-010 012 013 014

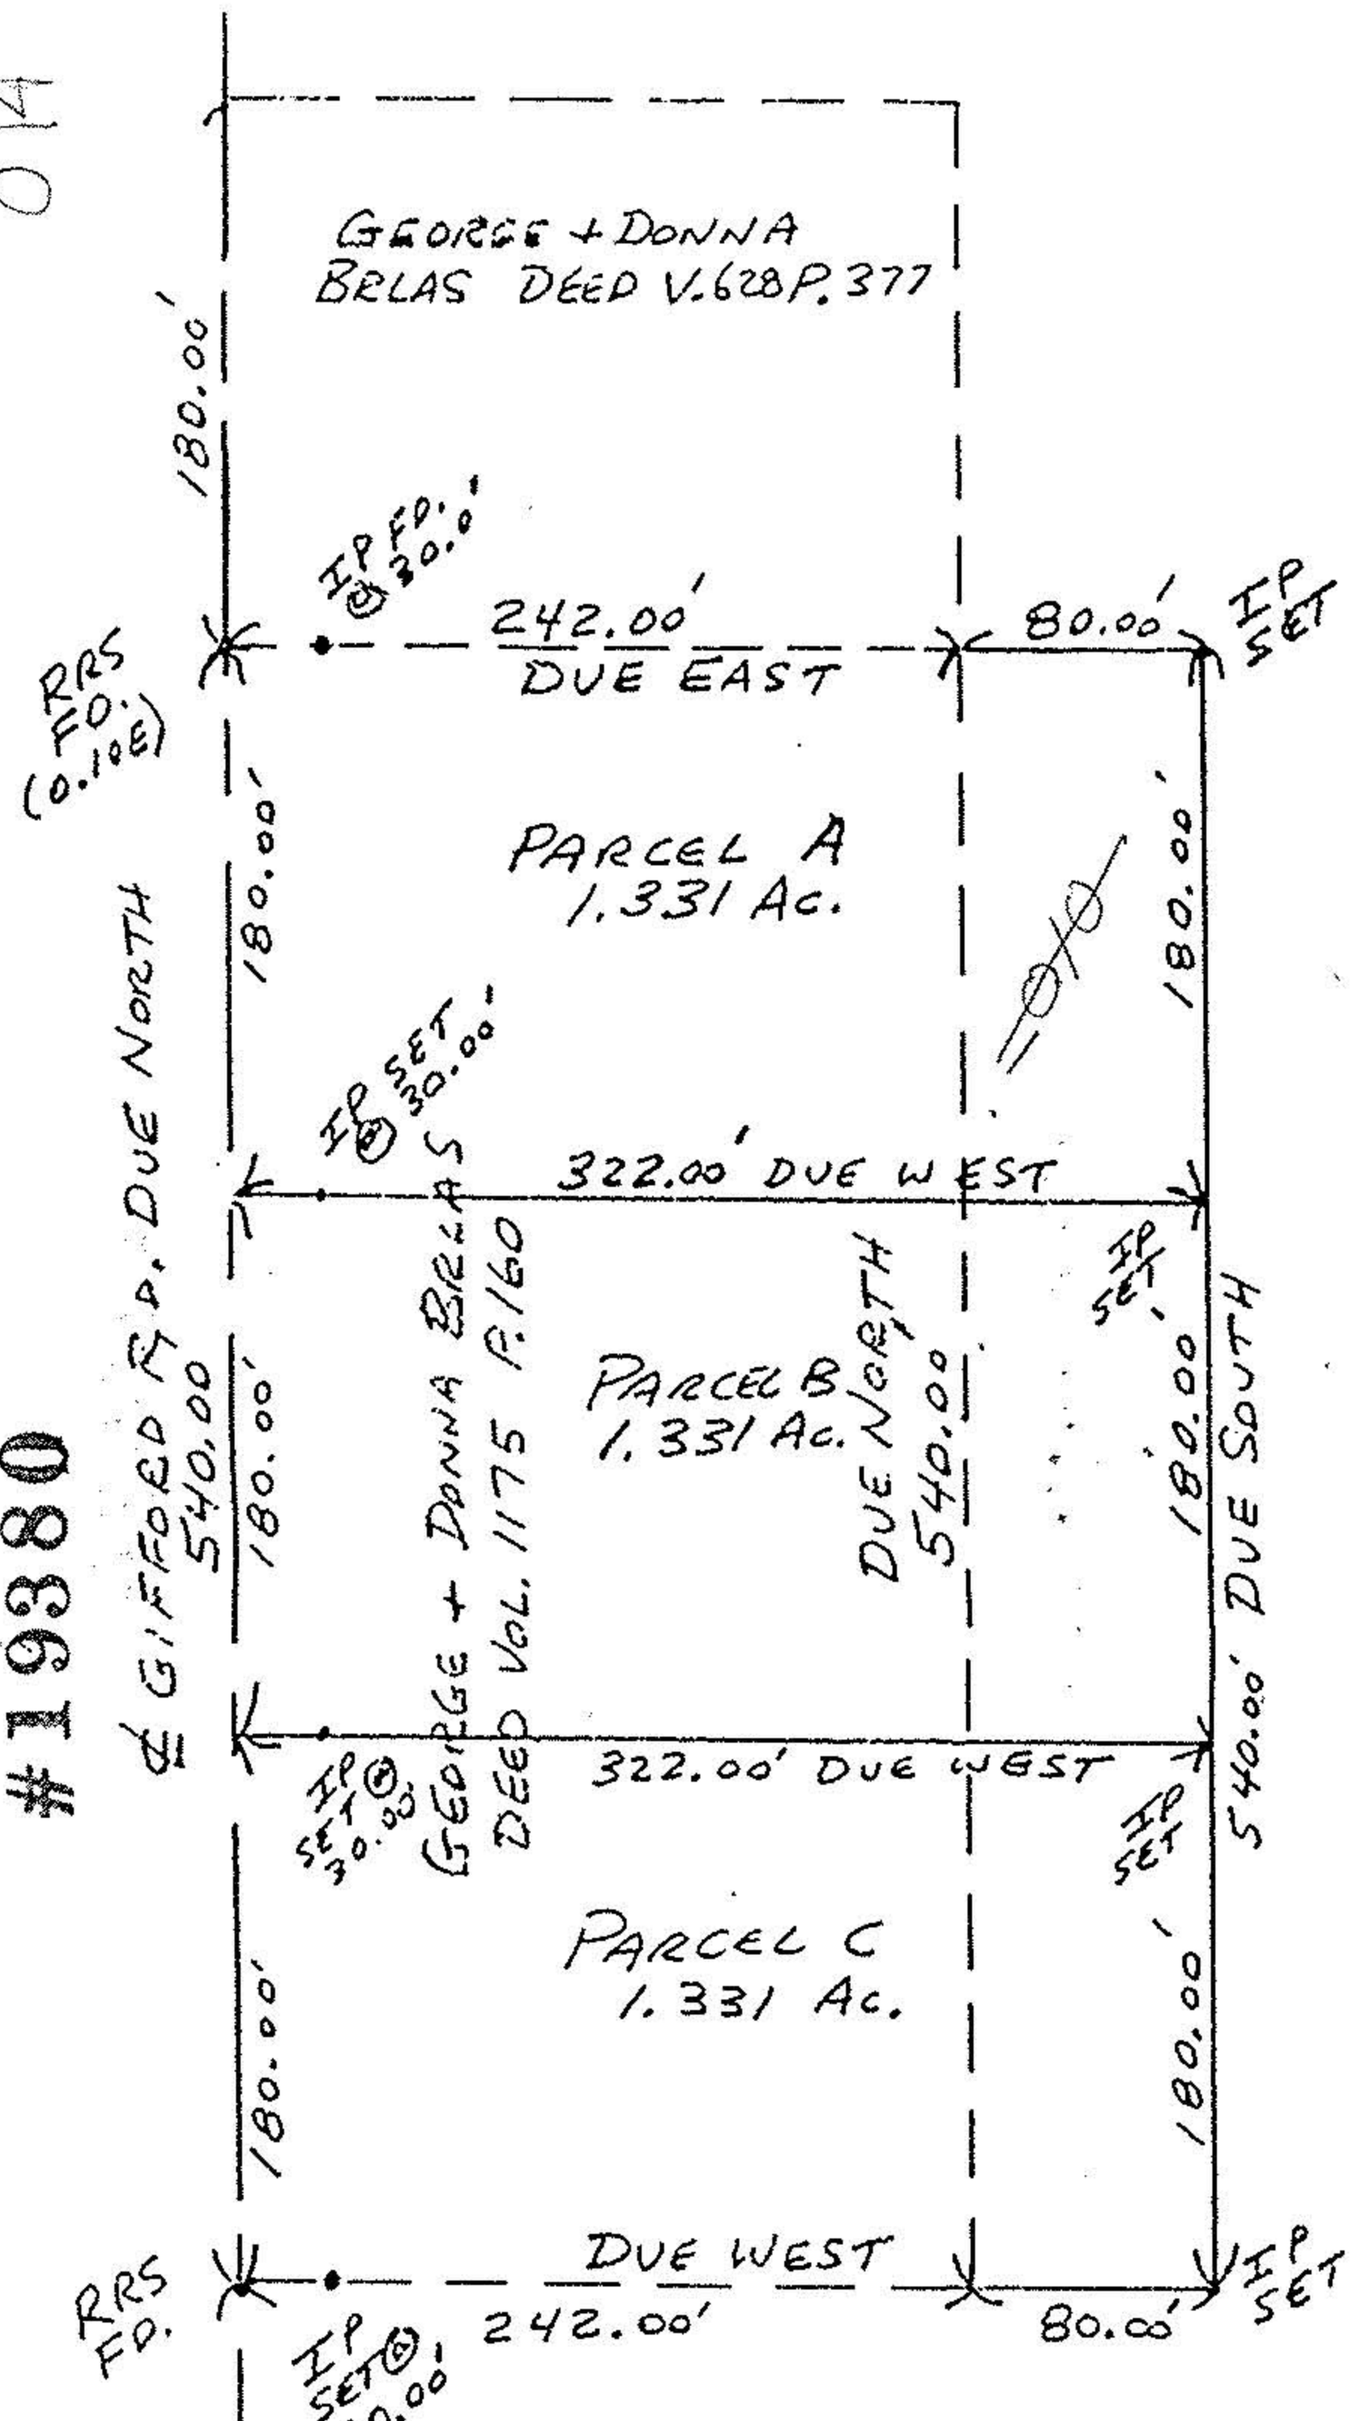

NORTH
SCALE 1" = 100'

ETHEL M. EARL
DEED V. 1003 P. 353, PAR. #2
64.00 AC. ORIG.
63.008 AC. REM.

STATE OF OHIO
JOHN R. HAMILTON
6861
REGISTERED PROFESSIONAL SURVEYOR

MAP OF SURVEY FOR
GEORGE + DONNA BELAS
O.L. 43 - TRACT 9 - CAMDEN TWP.
JAN. 1991 SCALE 1" = 100'
JOHN R. HAMILTON
REG. SURV. #6861

#19380
~~#19379~~ VOID

APPROVED LORAIN CO. MAP DEPT.	
DATE 5-20-91	
PAGE 13-H	
BY CAROLYN FLANCIS	
VOID AFTER #	19379

13-H-000-043-000 ~~19329~~ VOID #19380