# MAP OF SURVEY, LOT SPLIT AND ASSEMBLY

PREPARED FOR

## JULIA GREEN

SITUATED IN THE TOWNSHIP OF CAMDEN, COUNTY OF LORAIN, STATE OF OHIO
AND BEING KNOWN AS PART OF ORIGINAL CANDEN TOWNSHIP LOT 39, TRACT 9

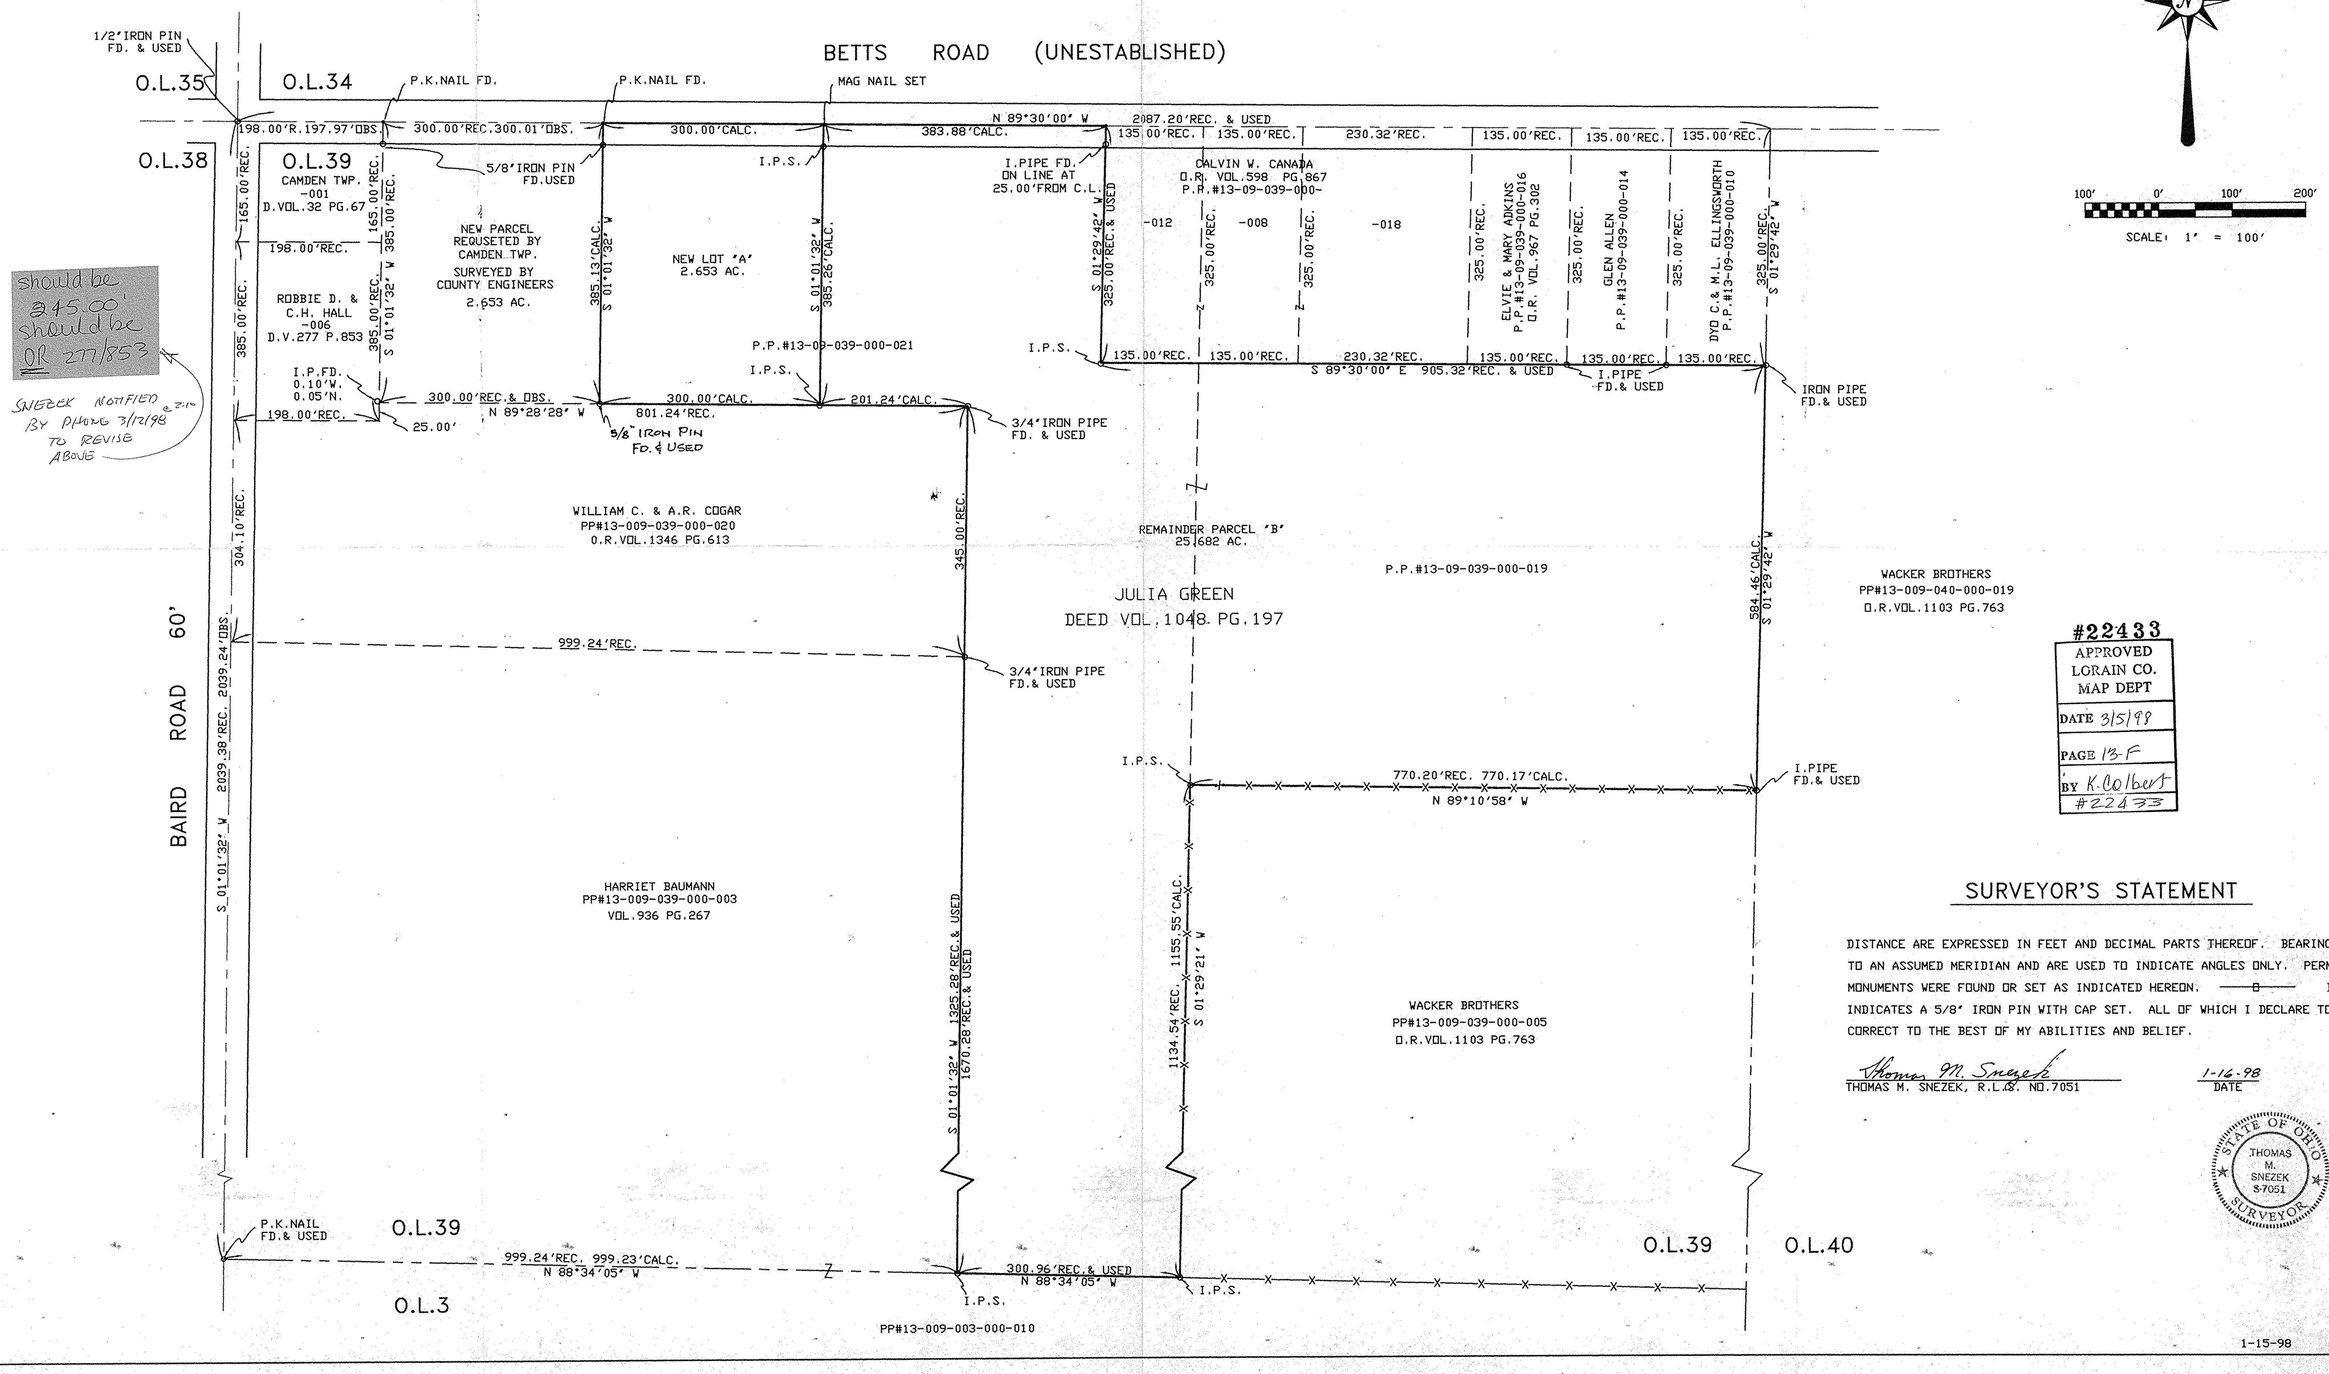


#22433
APPROVED
LORAIN CO.
MAP DEPT
DATE 3/5/98
PAGE 13-F
BY K.Colbert
#22433

## SURVEYOR'S STATEMENT

DISTANCE ARE EXPRESSED IN FEET AND DECIMAL PARTS THEREOF. BEARINGS ARE TO AN ASSUMED MERIDIAN AND ARE USED TO INDICATE ANGLES ONLY. PERMANENT MONUMENTS WERE FOUND OR SET AS INDICATED HEREON. —o— I.P.S. INDICATES A 5/8" IRON PIN WITH CAP SET. ALL OF WHICH I DECLARE TO BE CORRECT TO THE BEST OF MY ABILITIES AND BELIEF.

Thomas M. Snezek
THOMAS M. SNEZEK, R.L.S. NO.7051

1-16-98
DATE

STATE OF OHIO THOMAS M. SNEZEK S-7051 SURVEYOR

1-15-98 P.N.9801