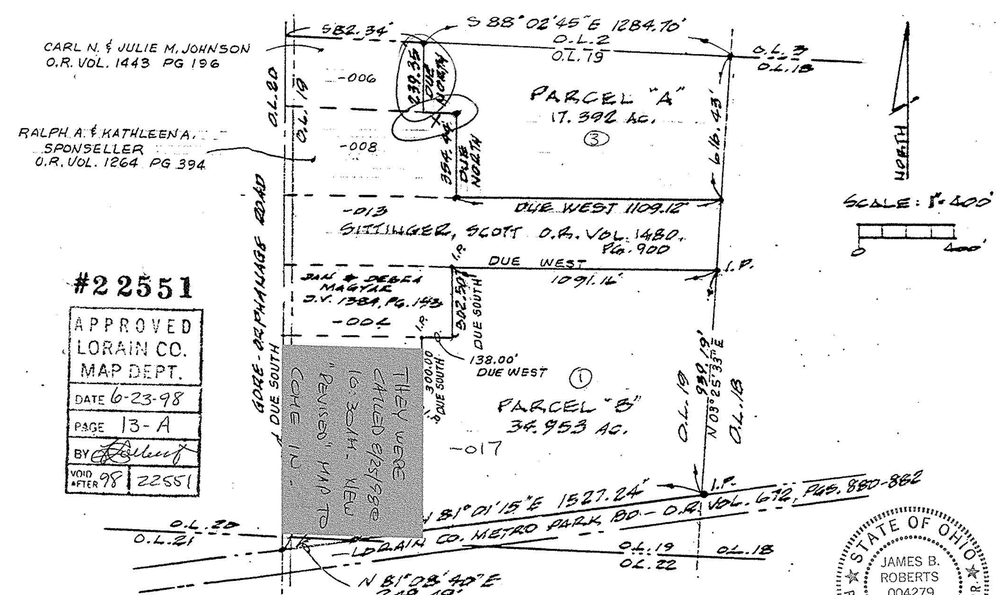


#22551

| APPROVED LORAIN CO. MAP DEPT. |
|---|
| DATE 6-23-98 |
| PAGE 13-A |
| BY |
| VOID AFTER 98 \| 22551 |

MAP of REMAINING ACREAGE - AS COMBINED
-PREPARED FOR BRIAN FORTUNE

PART of ORIG. CAMDEN TWP. LOTS 19 & 22, TRACT II
LORAIN COUNTY OHIO

K. E. McCARTNEY & ASSOCIATES
MAR. 1998 #985725




#22551

| APPROVED LORAIN CO. MAP DEPT. |
|---|
| DATE 6-23-98 |
| PAGE 13-A |
| BY |
| VOID AFTER 98 \| 22551 |

MAP of PARCEL SPLIT SURVEY
PREPARED FOR BRIAN FORTUNE

PART of ORIG. CAMDEN TWP. LOT 22, TRACT II
LORAIN COUNTY, OHIO

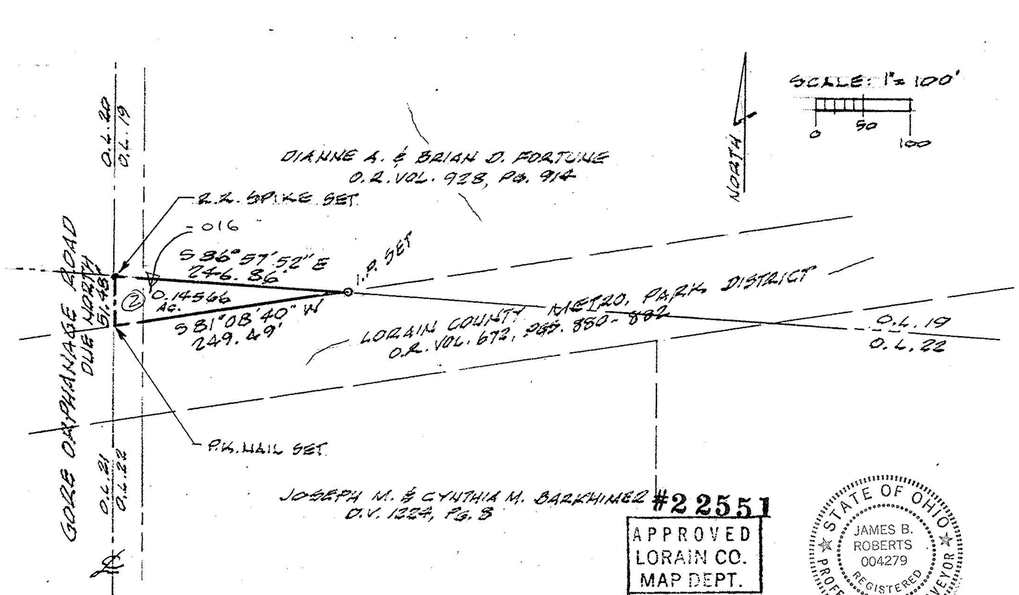REF: SPLIT FROM P.P.# 13-11-022-000-013

K. E. McCARTNEY & ASSOCIATES
FEB., 1998 #985725-B