PARCEL I.D. NO. OHB C70 017
LORAIN COUNTY, OHIO

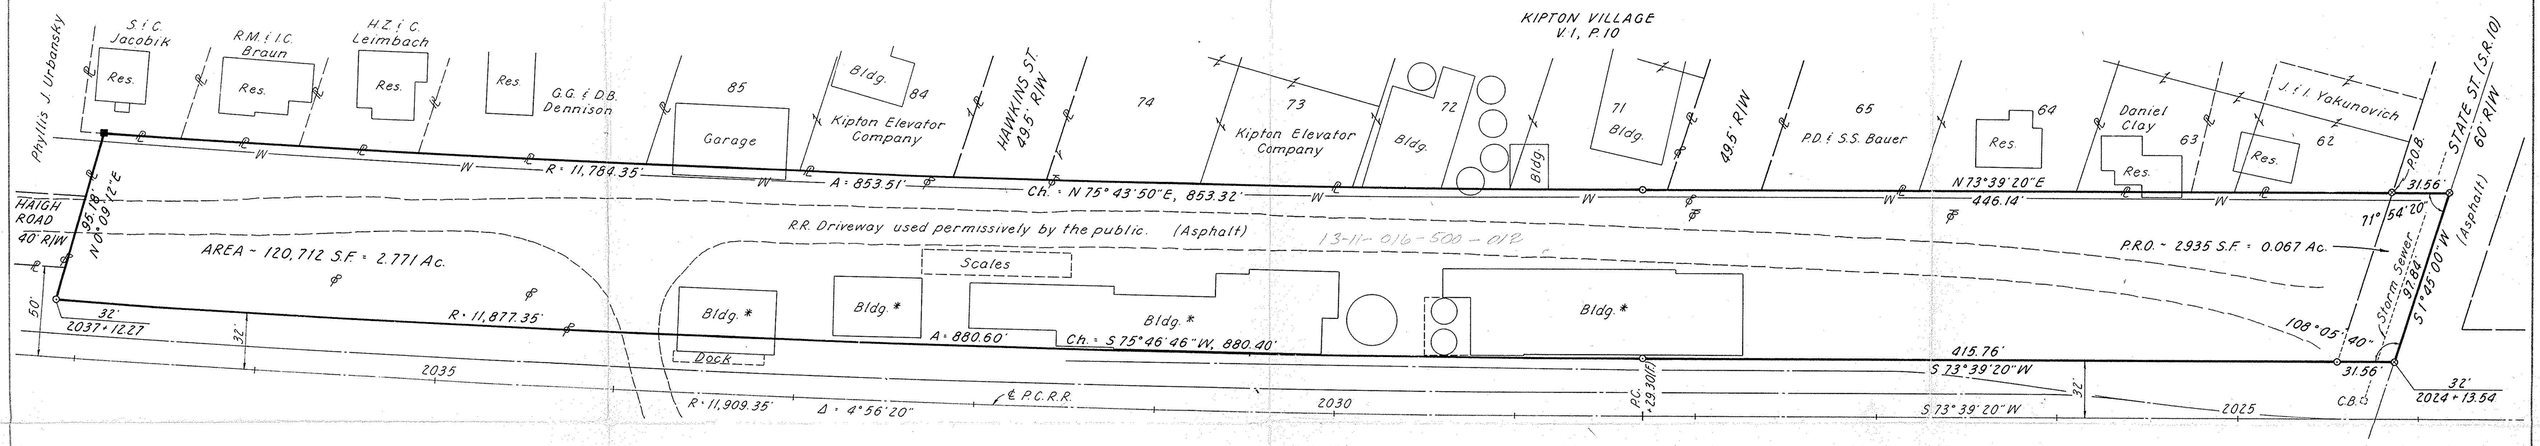

* On Land Leased by Kipton Elevator Co.

LEGEND
- ⊙ I.P. Set
- ⊗ R.R. Spike Set
- ■ Mon. Fd. & Used

THIS SURVEY CERTIFIED AS TO CORRECTNESS TO THE PENN CENTRAL TRANSPORTATION COMPANY AND TO THE TITLE INSURANCE COMPANY INSURING THEIR INTERESTS IN THE PREMISES.

Richard D. Keller

RICHARD D. KELLER, REG. SURVEYOR NO. 5648

SEPTEMBER 19, 1977

Richland Engineering Limited
CONSULTING ENGINEERS
MANSFIELD, OHIO

SURVEY of 2.771 ACRES
being in the
VILLAGE of KIPTON, CAMDEN TWP.
TRACT 11, LOT 16, T-4-N, R-19-W
LORAIN COUNTY, OHIO

SYA-112

CALC.	DRAWN	TRACED	CHECKED	REVIEWED	DATE	REVISED
REF	WLF					