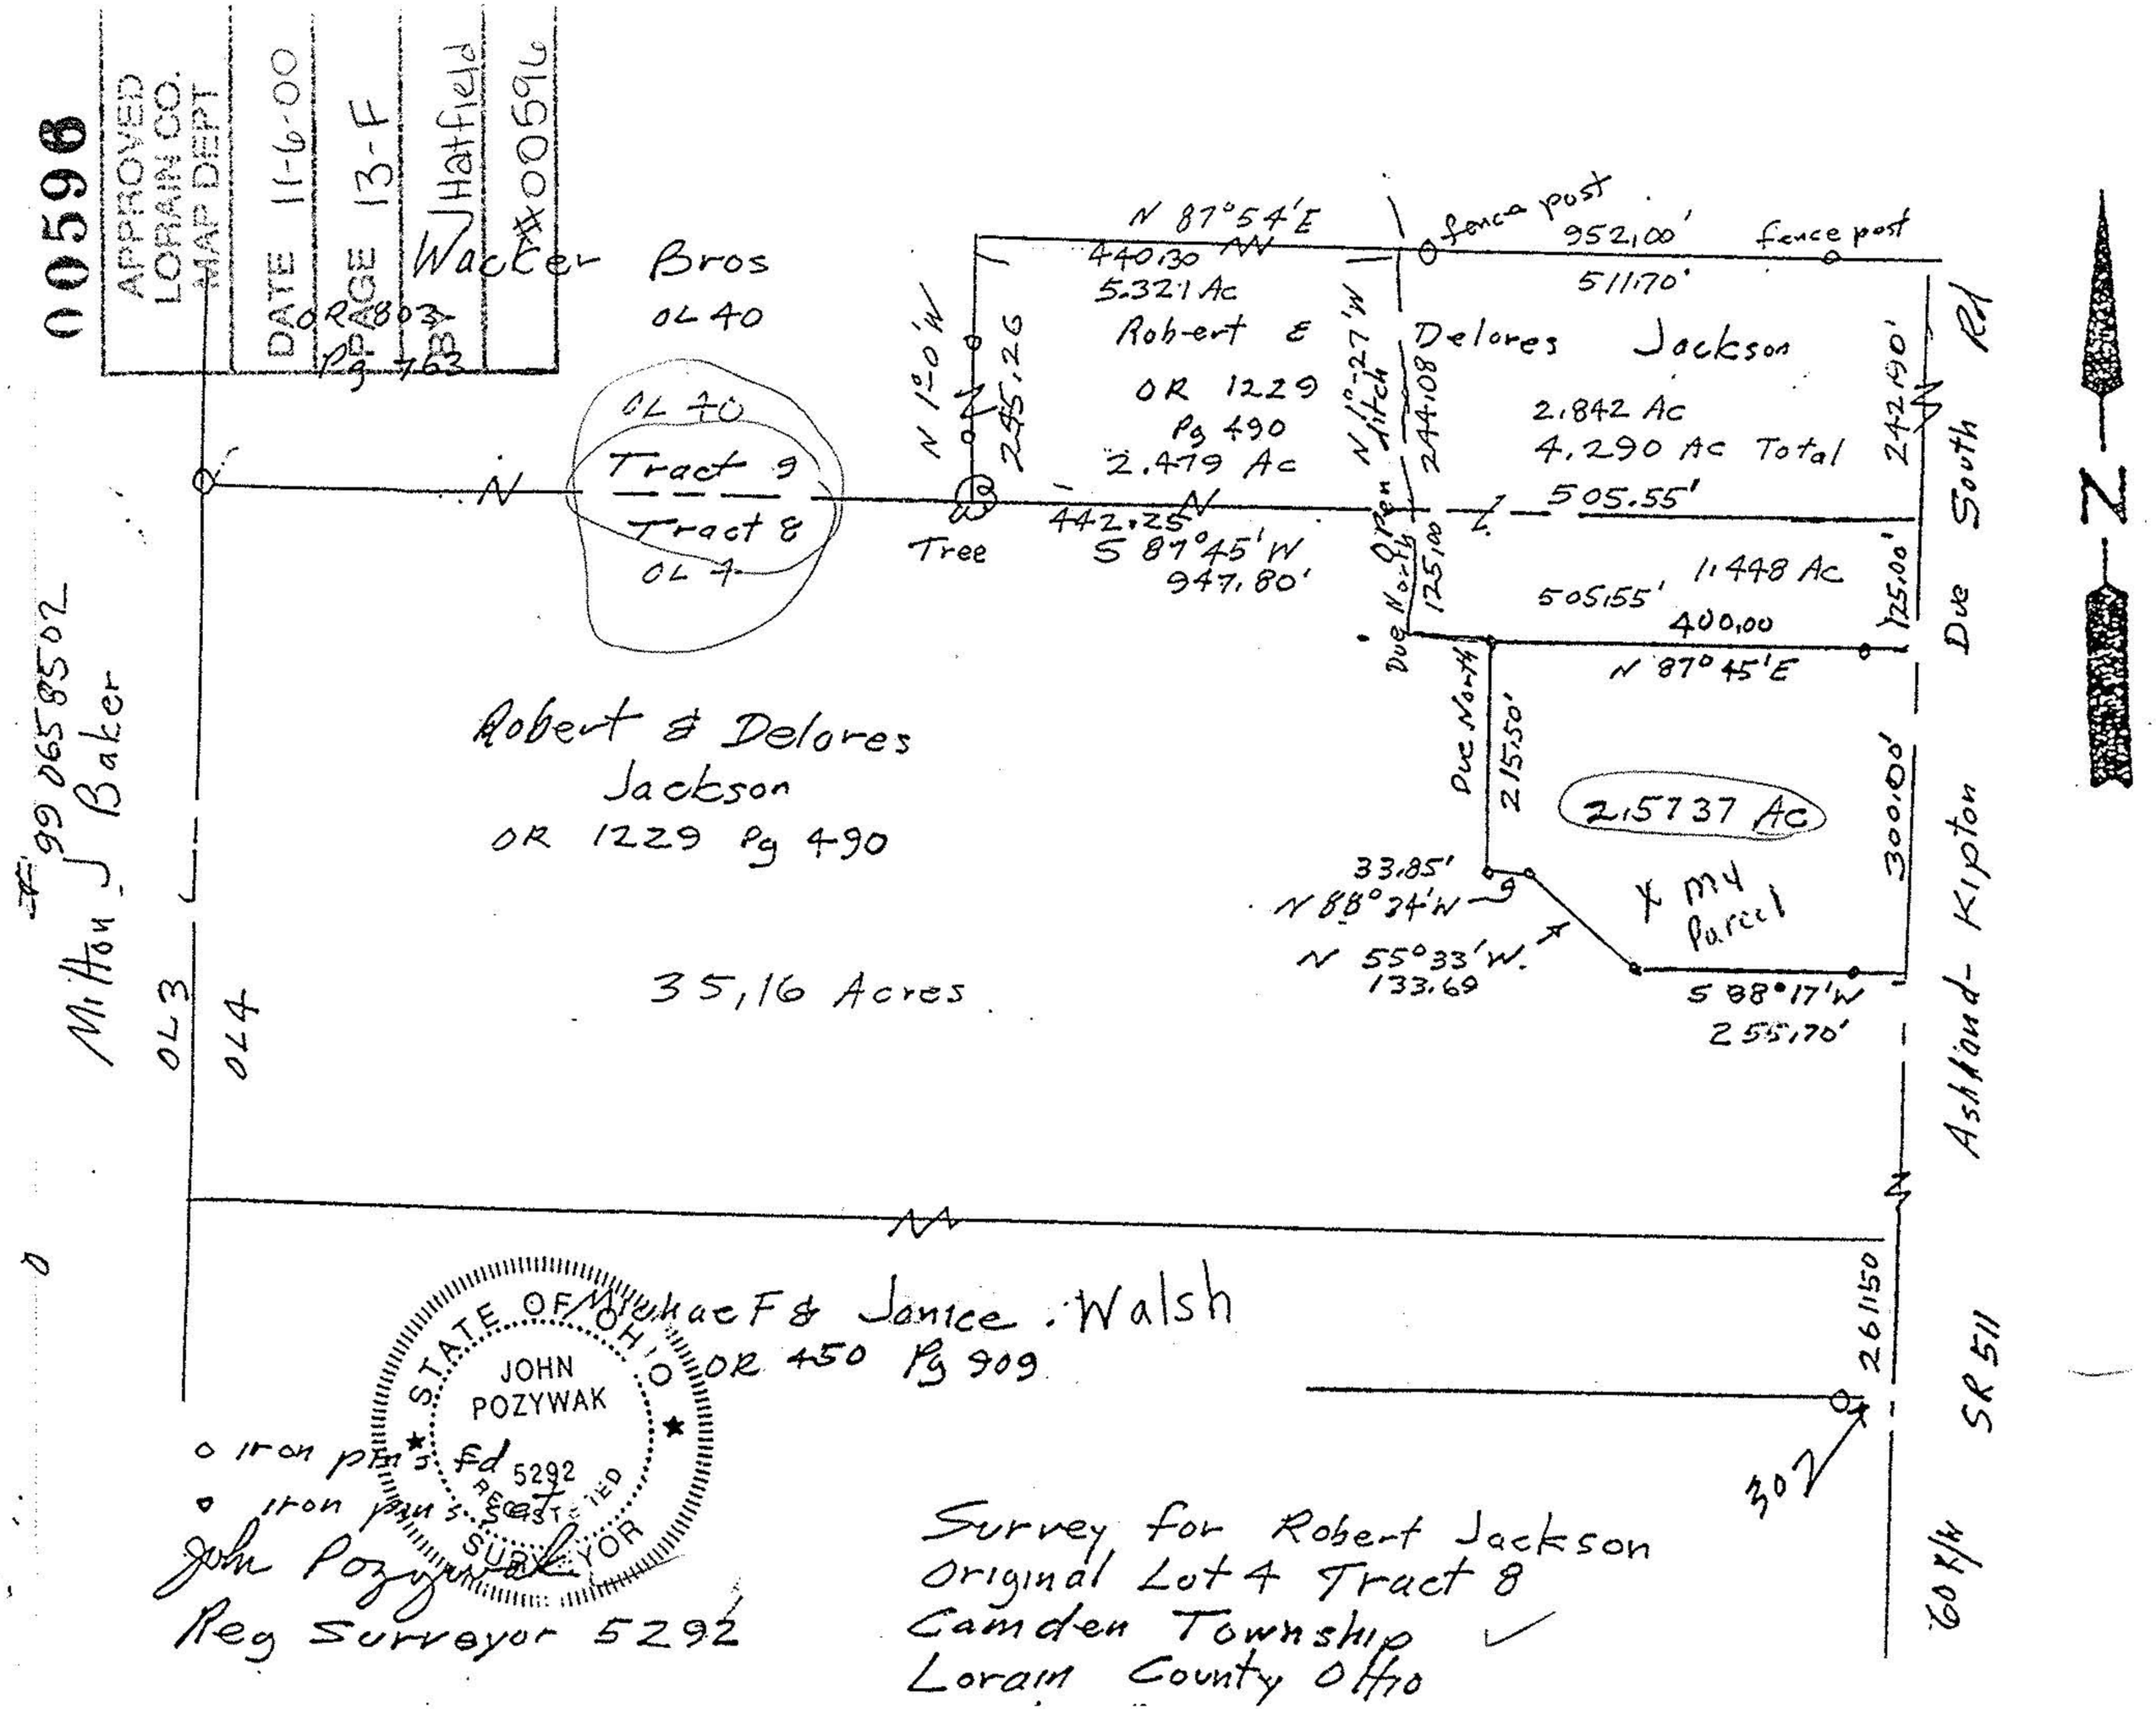

00596
APPROVED
LORAIN CO.
MAP DEPT
DATE 11-6-00
PAGE 13-F
BY JHatfield
#00596
Wacker Bros
OL 40
OR 803
Pg 763
OL 40
Tract 9
Tract 8
OL 4
N
Tree
N 1°0'W
245.26
N 87°54'E
440.30
5.321 Ac
Robert & Delores Jackson
OR 1229
Pg 490
2.479 Ac
442.25
S 87°45'W
947.80'
N 1°-27'W
Open ditch
244.08
fence post
952.00'
fence post
511.70'
2.842 Ac
4.290 Ac Total
505.55'
242.90'
Due South Rd
Due North
125.00
1.448 Ac
505.55'
400.00
N 87°45'E
125.00'
Due North
215.50'
2.5737 Ac
300.00'
Ashland-Kipton
33.85'
N 88°34'W
N 55°33'W
133.69
X my Parcel
S 88°17'W
255.70'
Robert & Delores
Jackson
OR 1229 Pg 490
35.16 Acres
Milton J Baker
#99 065 8502
OL 3
OL 4
Michael F & Janice Walsh
OR 450 Pg 909
261.50
SR 511
302
60 R/W
STATE OF OHIO
JOHN POZYWAK
5292
REGISTERED
SURVEYOR
o iron pins fd
• iron pins set
John Pozywak
Reg Surveyor 5292
Survey for Robert Jackson
Original Lot 4 Tract 8
Camden Township
Lorain County Ohio