


Janice Merrill & Sandra Krupp

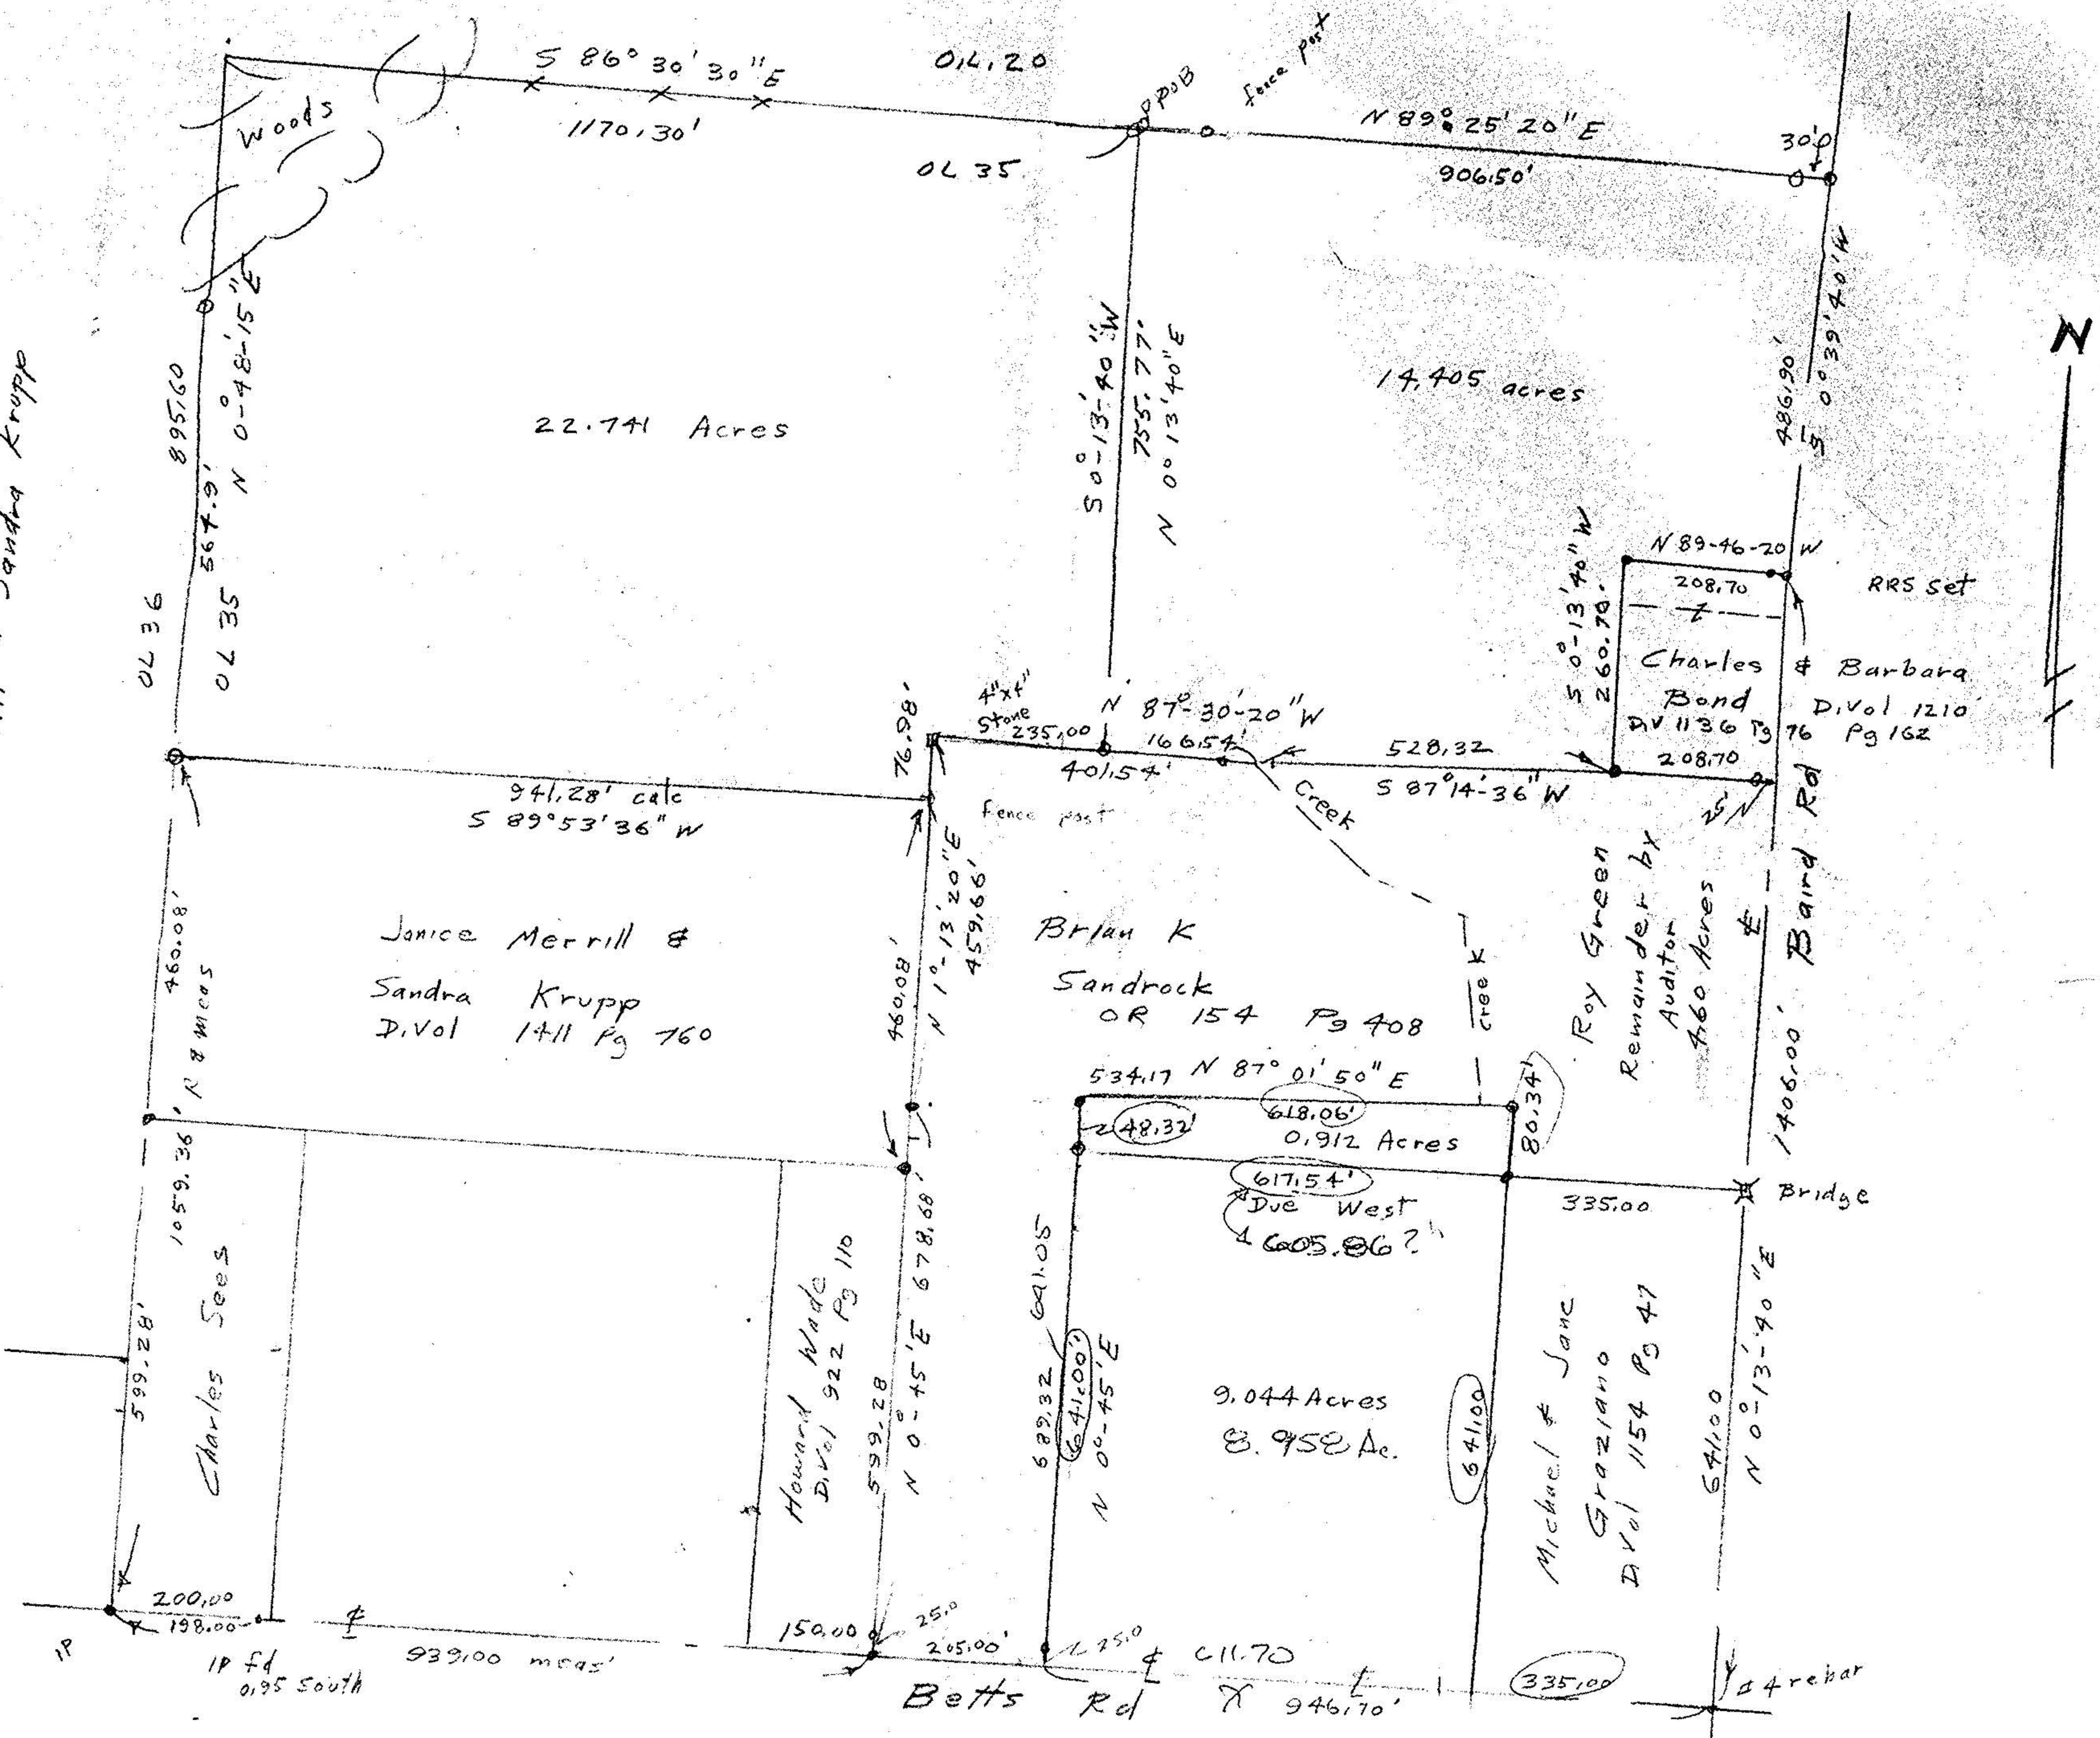

- Iron pipes fd
- Iron pipes set

John Poyzwal  
Reg Surveyor  
5292

Survey for Roy Green  
Part Original Lot 35 Tract 9  
Lorain County Ohio  
Scale 1" = 200' Sept. 16, 1991

