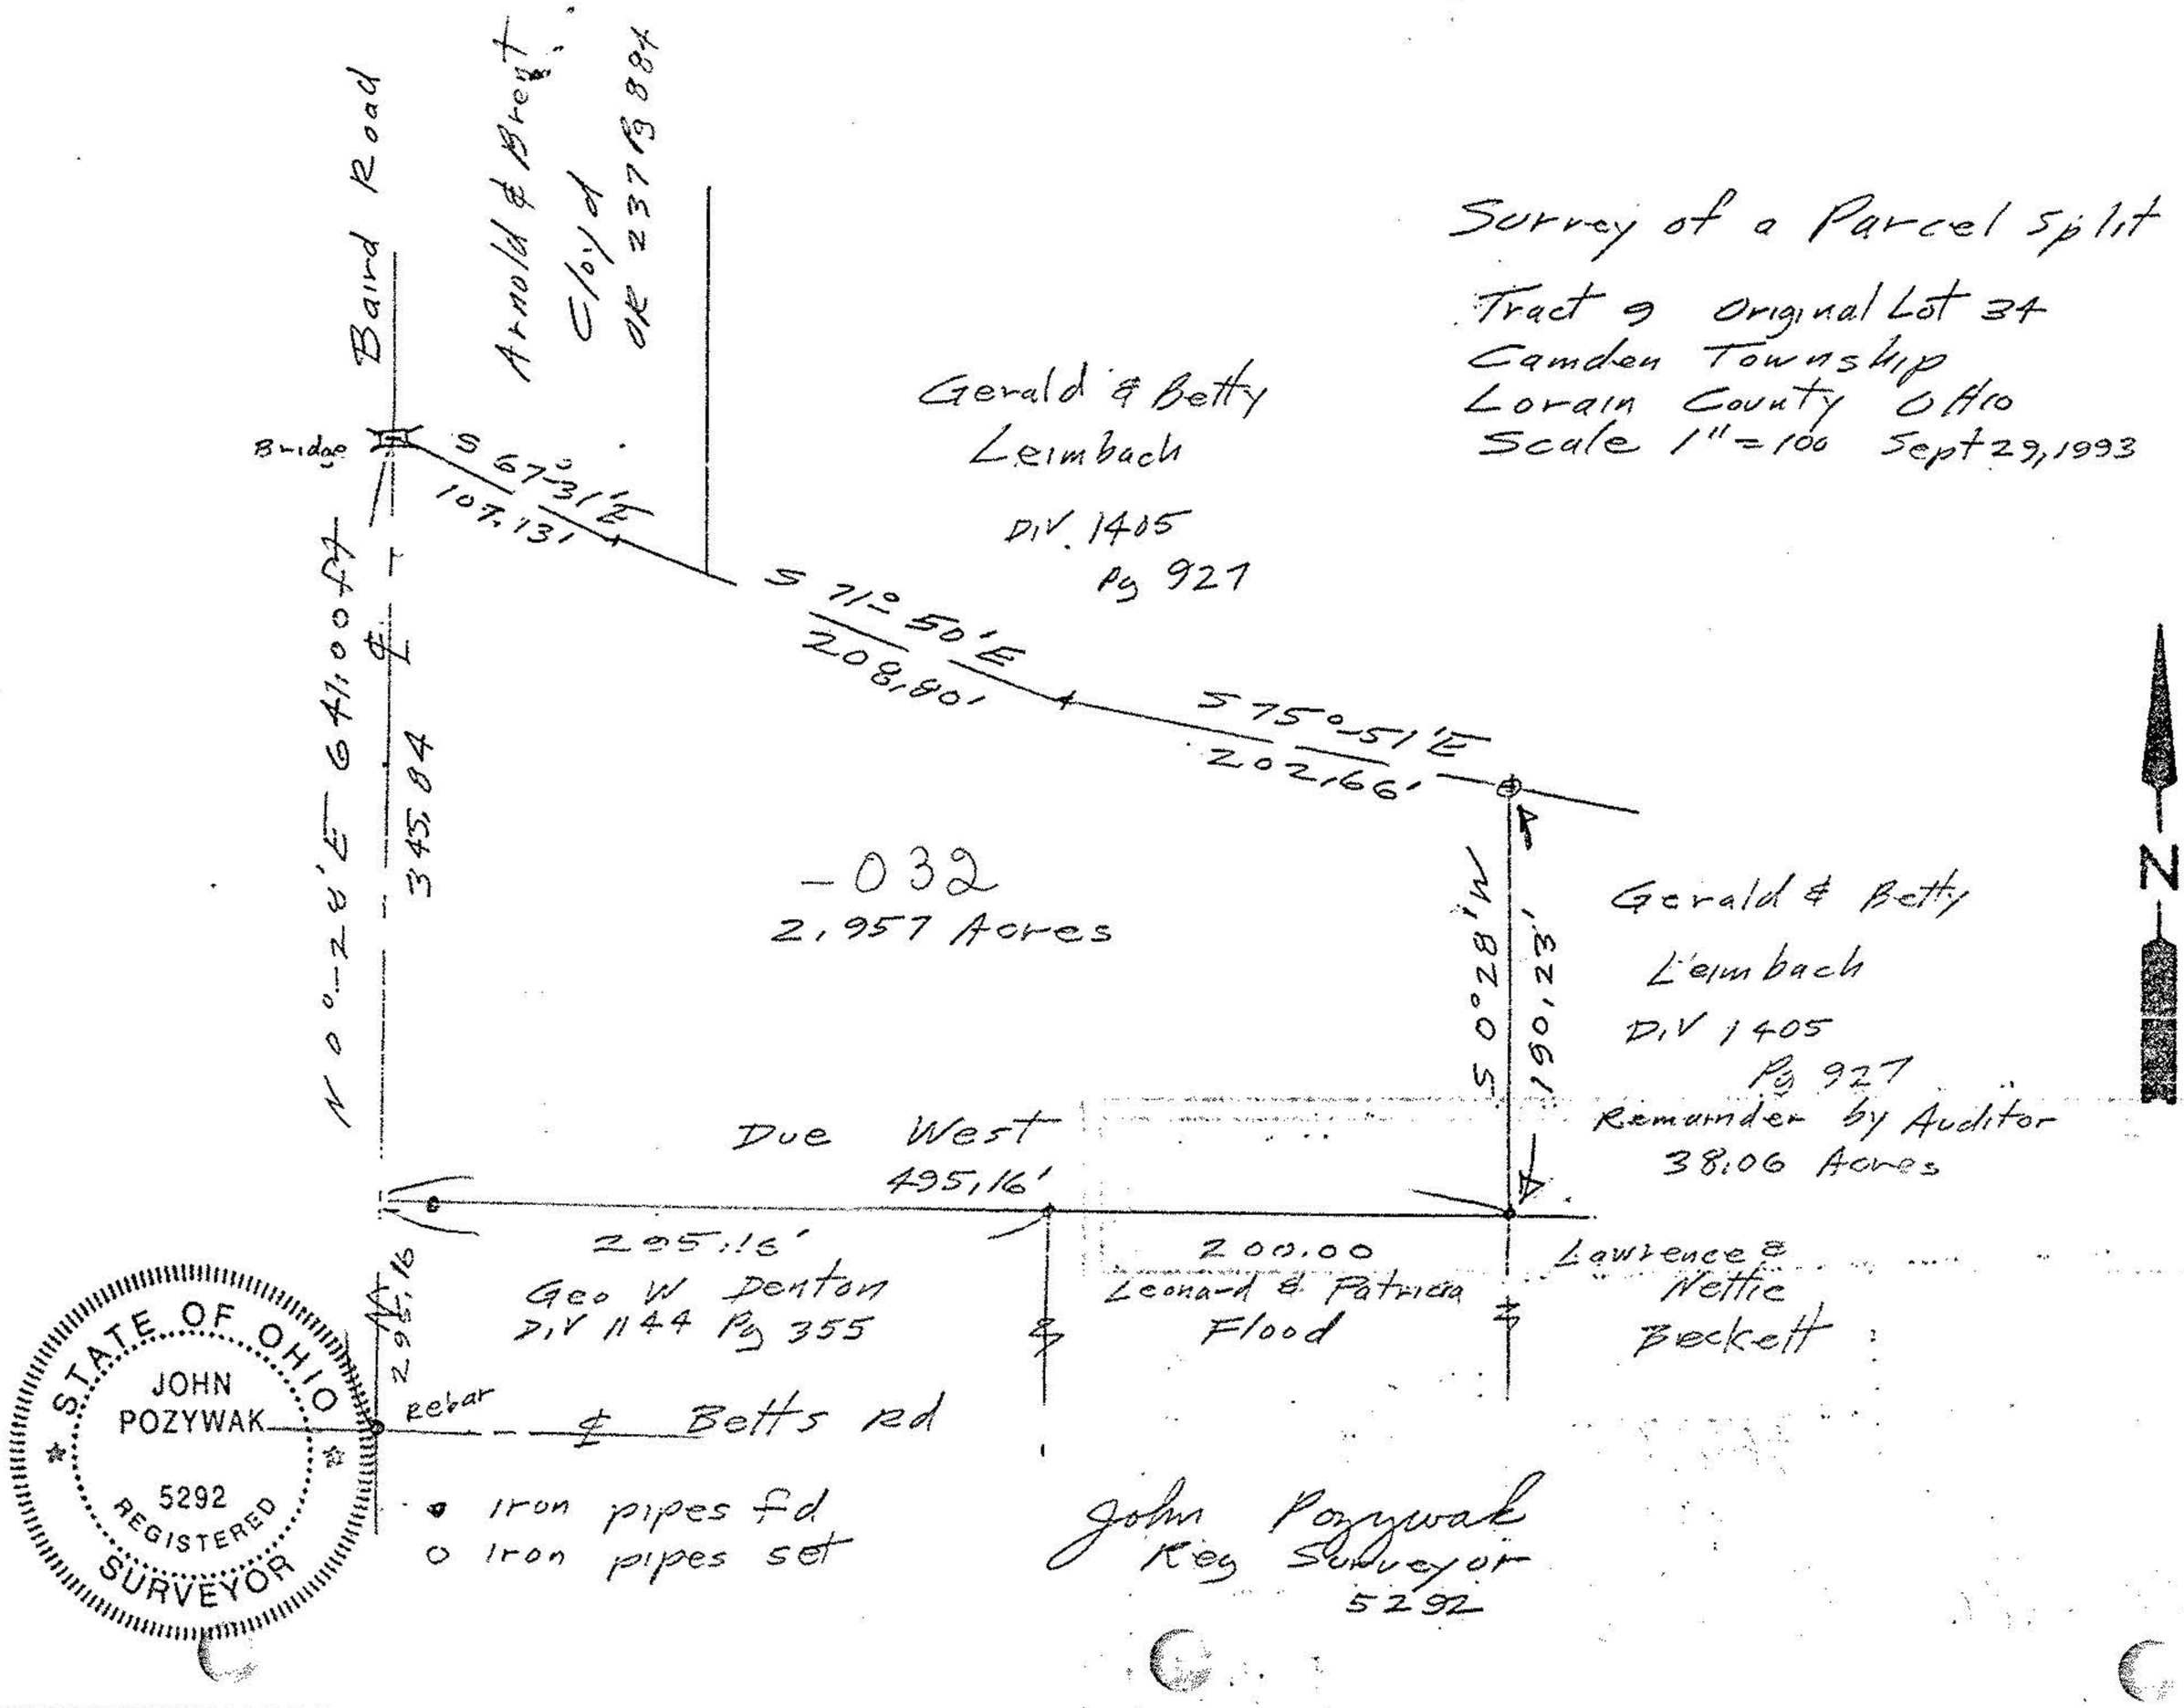
Survey of a Parcel Split
Tract 9 Original Lot 34
Camden Township
Lorain County Ohio
Scale 1" = 100 Sept 29, 1993
Baird Road
Arnold & Brent Cloyd OR 237 Pg 884
Bridge
S 67°31'E 107.13'
Gerald & Betty Leimbach
DIV. 1405 Pg 927
S 71°50'E 208.80'
S 75°51'E 202.66'
N 0°28'E 641.00 ft
345.84
-032
2.957 Acres
S 0°28'W 190.23'
Gerald & Betty Leimbach
DIV 1405 Pg 927
Remainder by Auditor
38.06 Acres
Due West 495.16'
295.16'
Geo W Denton
DIV 1144 Pg 355
200.00
Leonard & Patricia Flood
Lawrence & Nettie Beckett
295.16
Rebar
℄ Betts Rd
• Iron pipes fd
○ Iron pipes set
John Pozywak
Reg Surveyor
5292
STATE OF OHIO
JOHN POZYWAK
5292
REGISTERED
SURVEYOR
N