


TRACT II ORIGINAL LOT 25

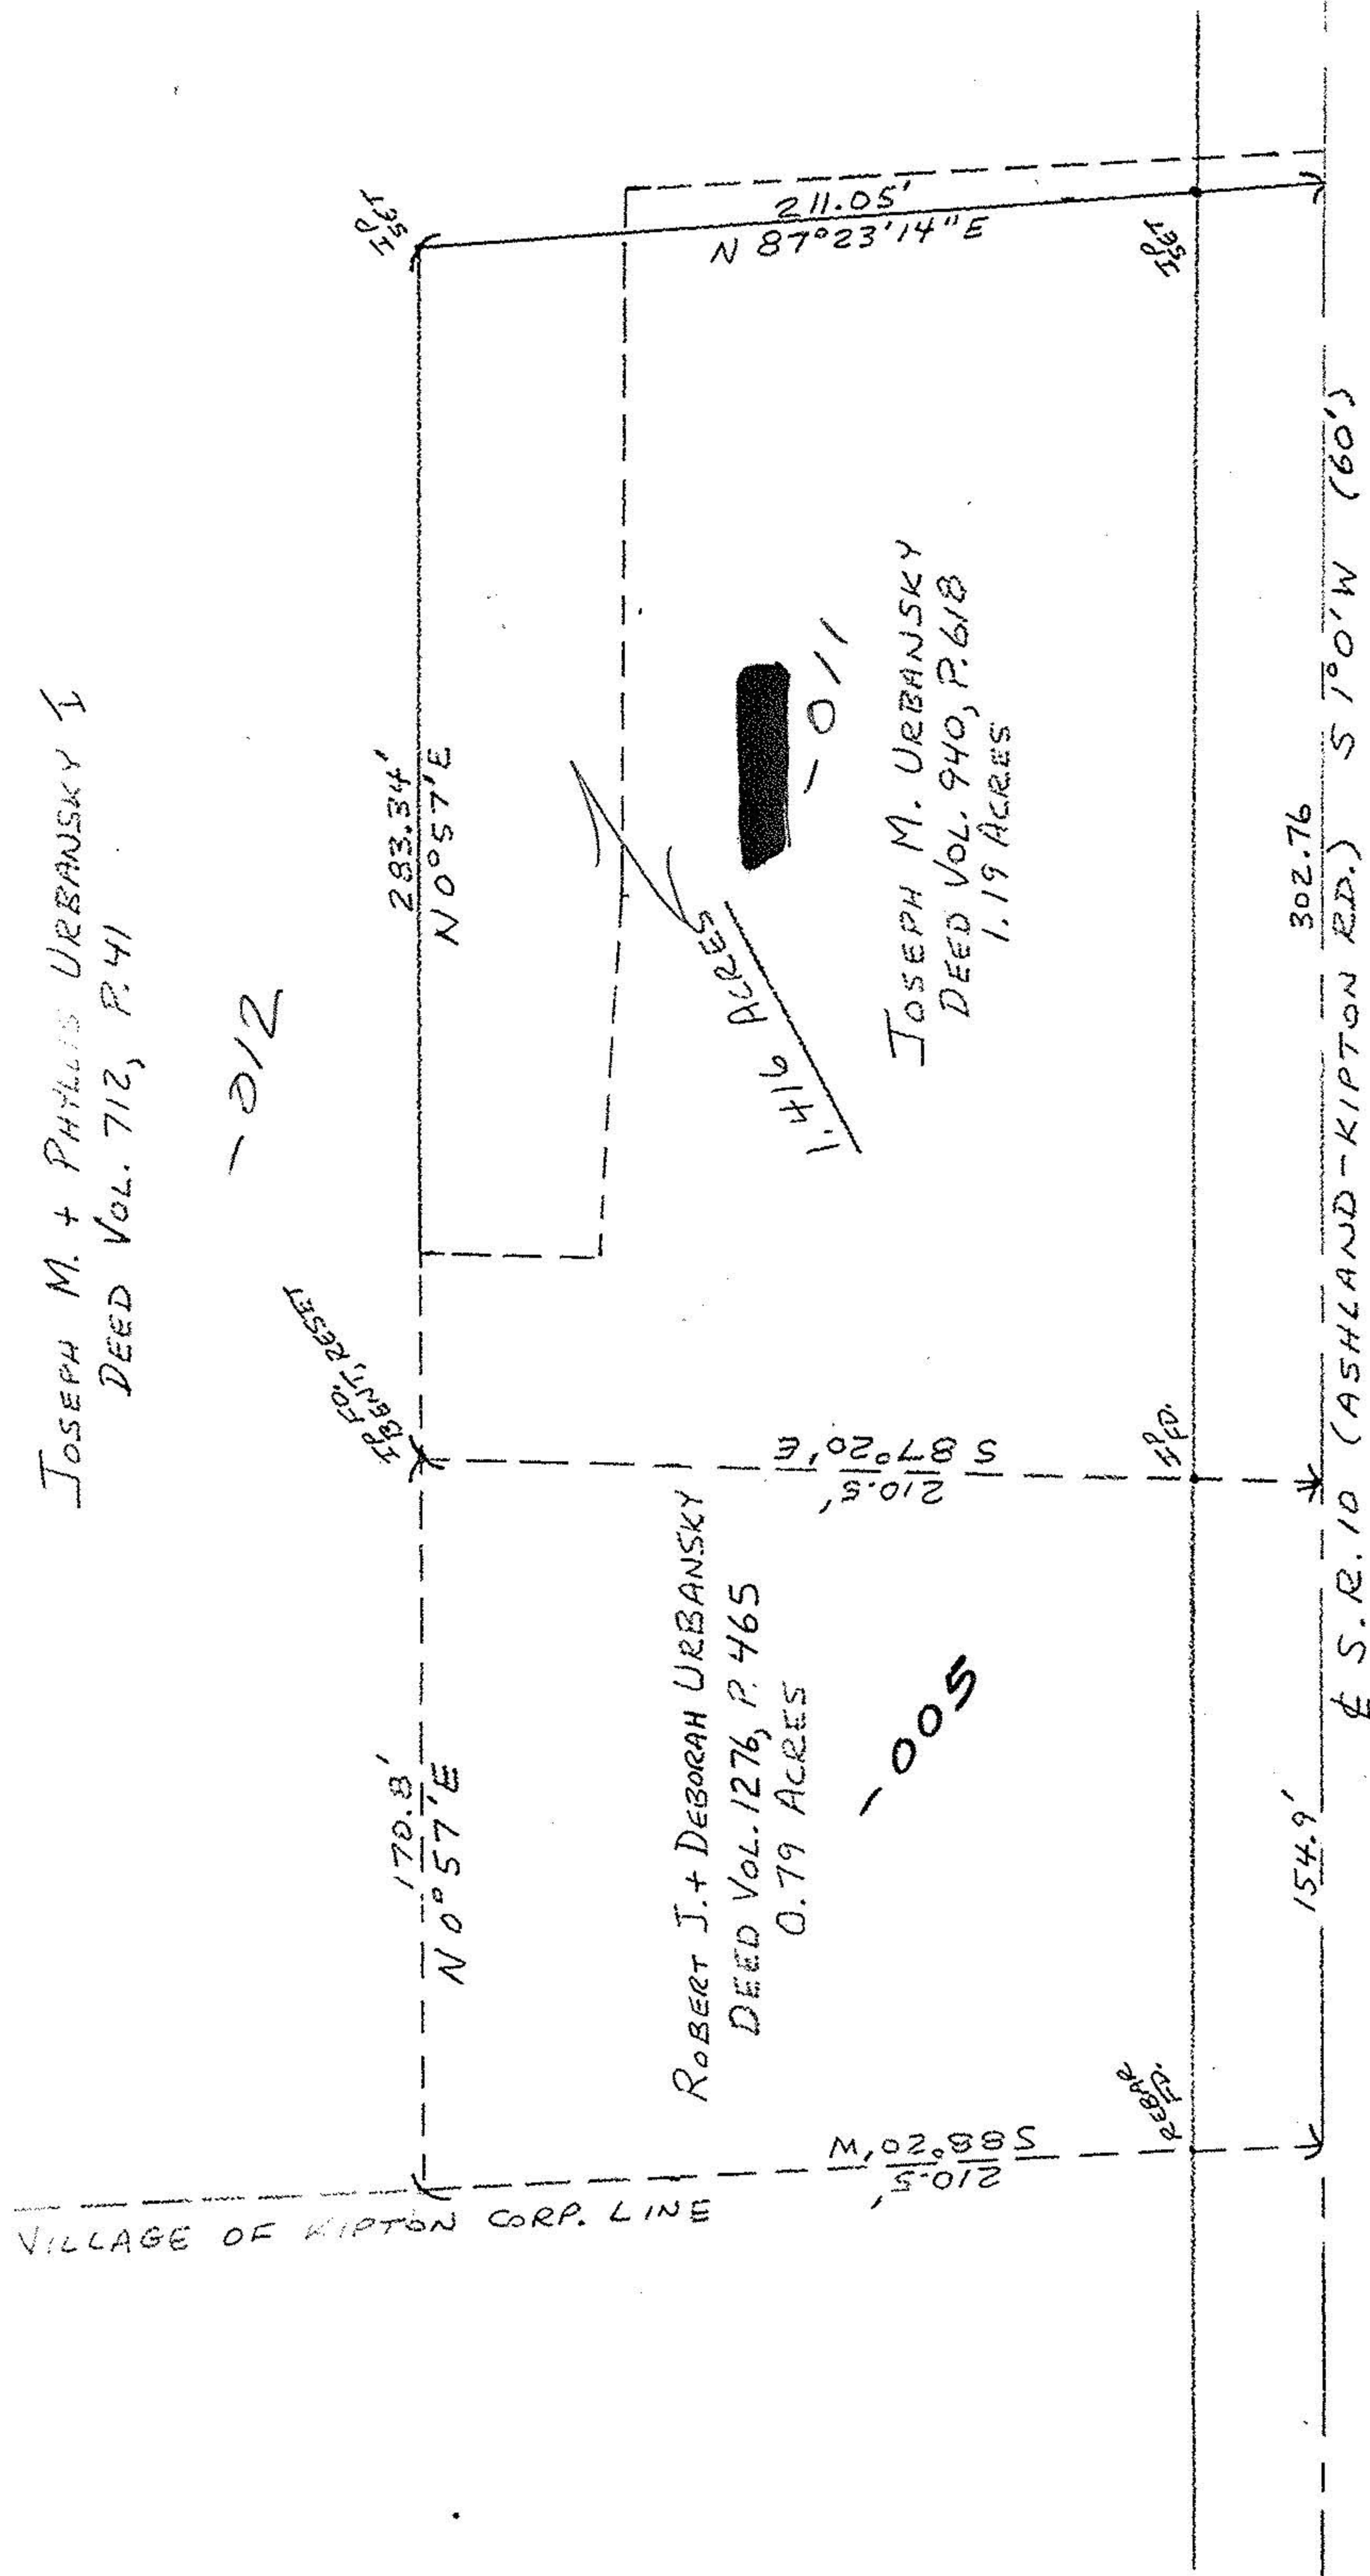

JOSEPH M. + PHYLLIS URBANSKY I
DEED VOL. 712, P. 41

-012

TR. FOR TRACT II


ROBERT J. + DEBORAH URBANSKY
DEED VOL. 1276, P. 465
0.79 ACRES

-005

JOSEPH M. URBANSKY
DEED VOL. 940, P. 618
1.19 ACRES

1.416 ACRES
-011

302.76
E S.R. 10 (ASHLAND-KIPTON RD.) S 70° W (60')

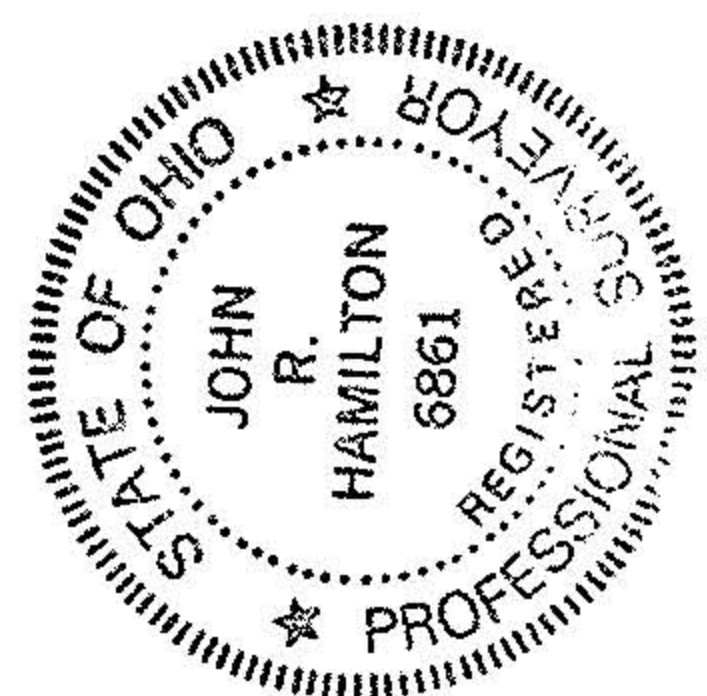

NORTH
SCALE 1"=50'

MAP OF SURVEY FOR JOSEPH URBANSKY CAMDEN TWP. -- TRACT II -- ORIGINAL LOT 25	
SCALE: 1" = 50'	APPROVED BY:
DATE: 2/17/86	DRAWN BY: JRH
REVISED 2/25/86	
JOHN R. HAMILTON - REG. SURVEYOR # 6861	
DRAWING NUMBER	