


12663  
Lorain Co. Map 13-19  
By Loran Rupp Registered Surveyor

#12663

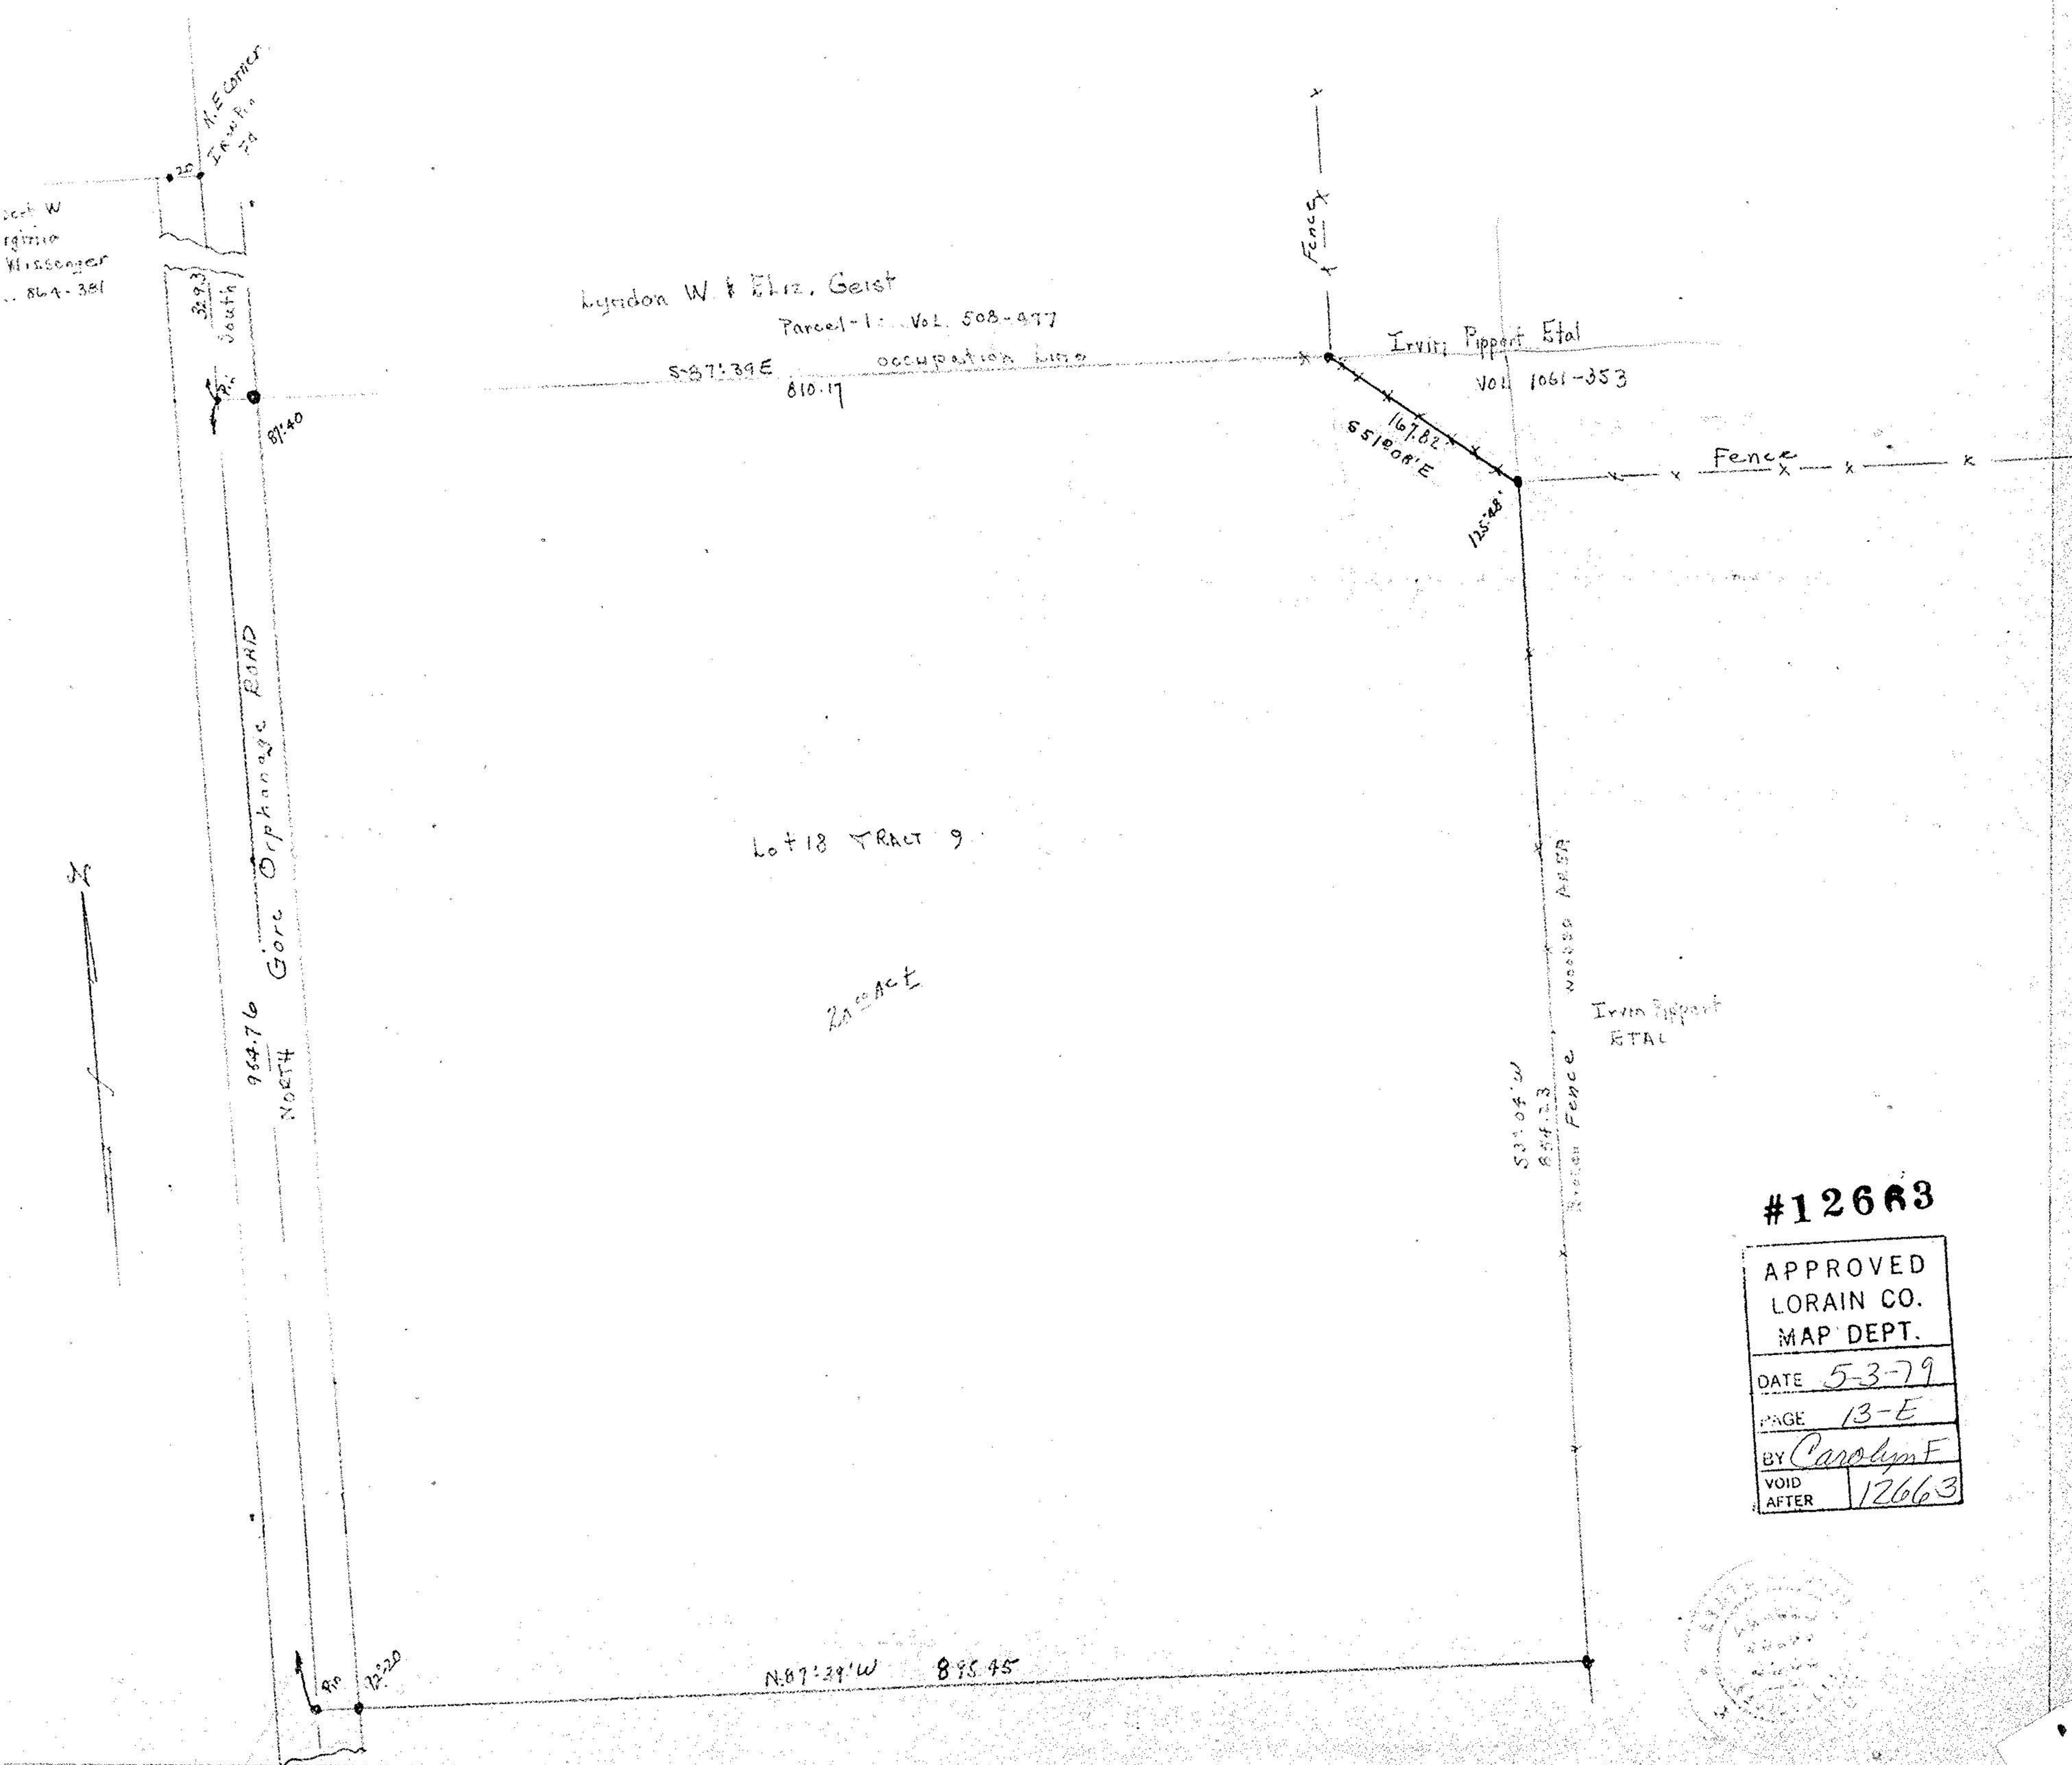

#12663

APPROVED LORAIN CO. MAP DEPT.	
DATE	5-3-79
PAGE	13-E
BY	Carolyn F
VOID AFTER	12663

