
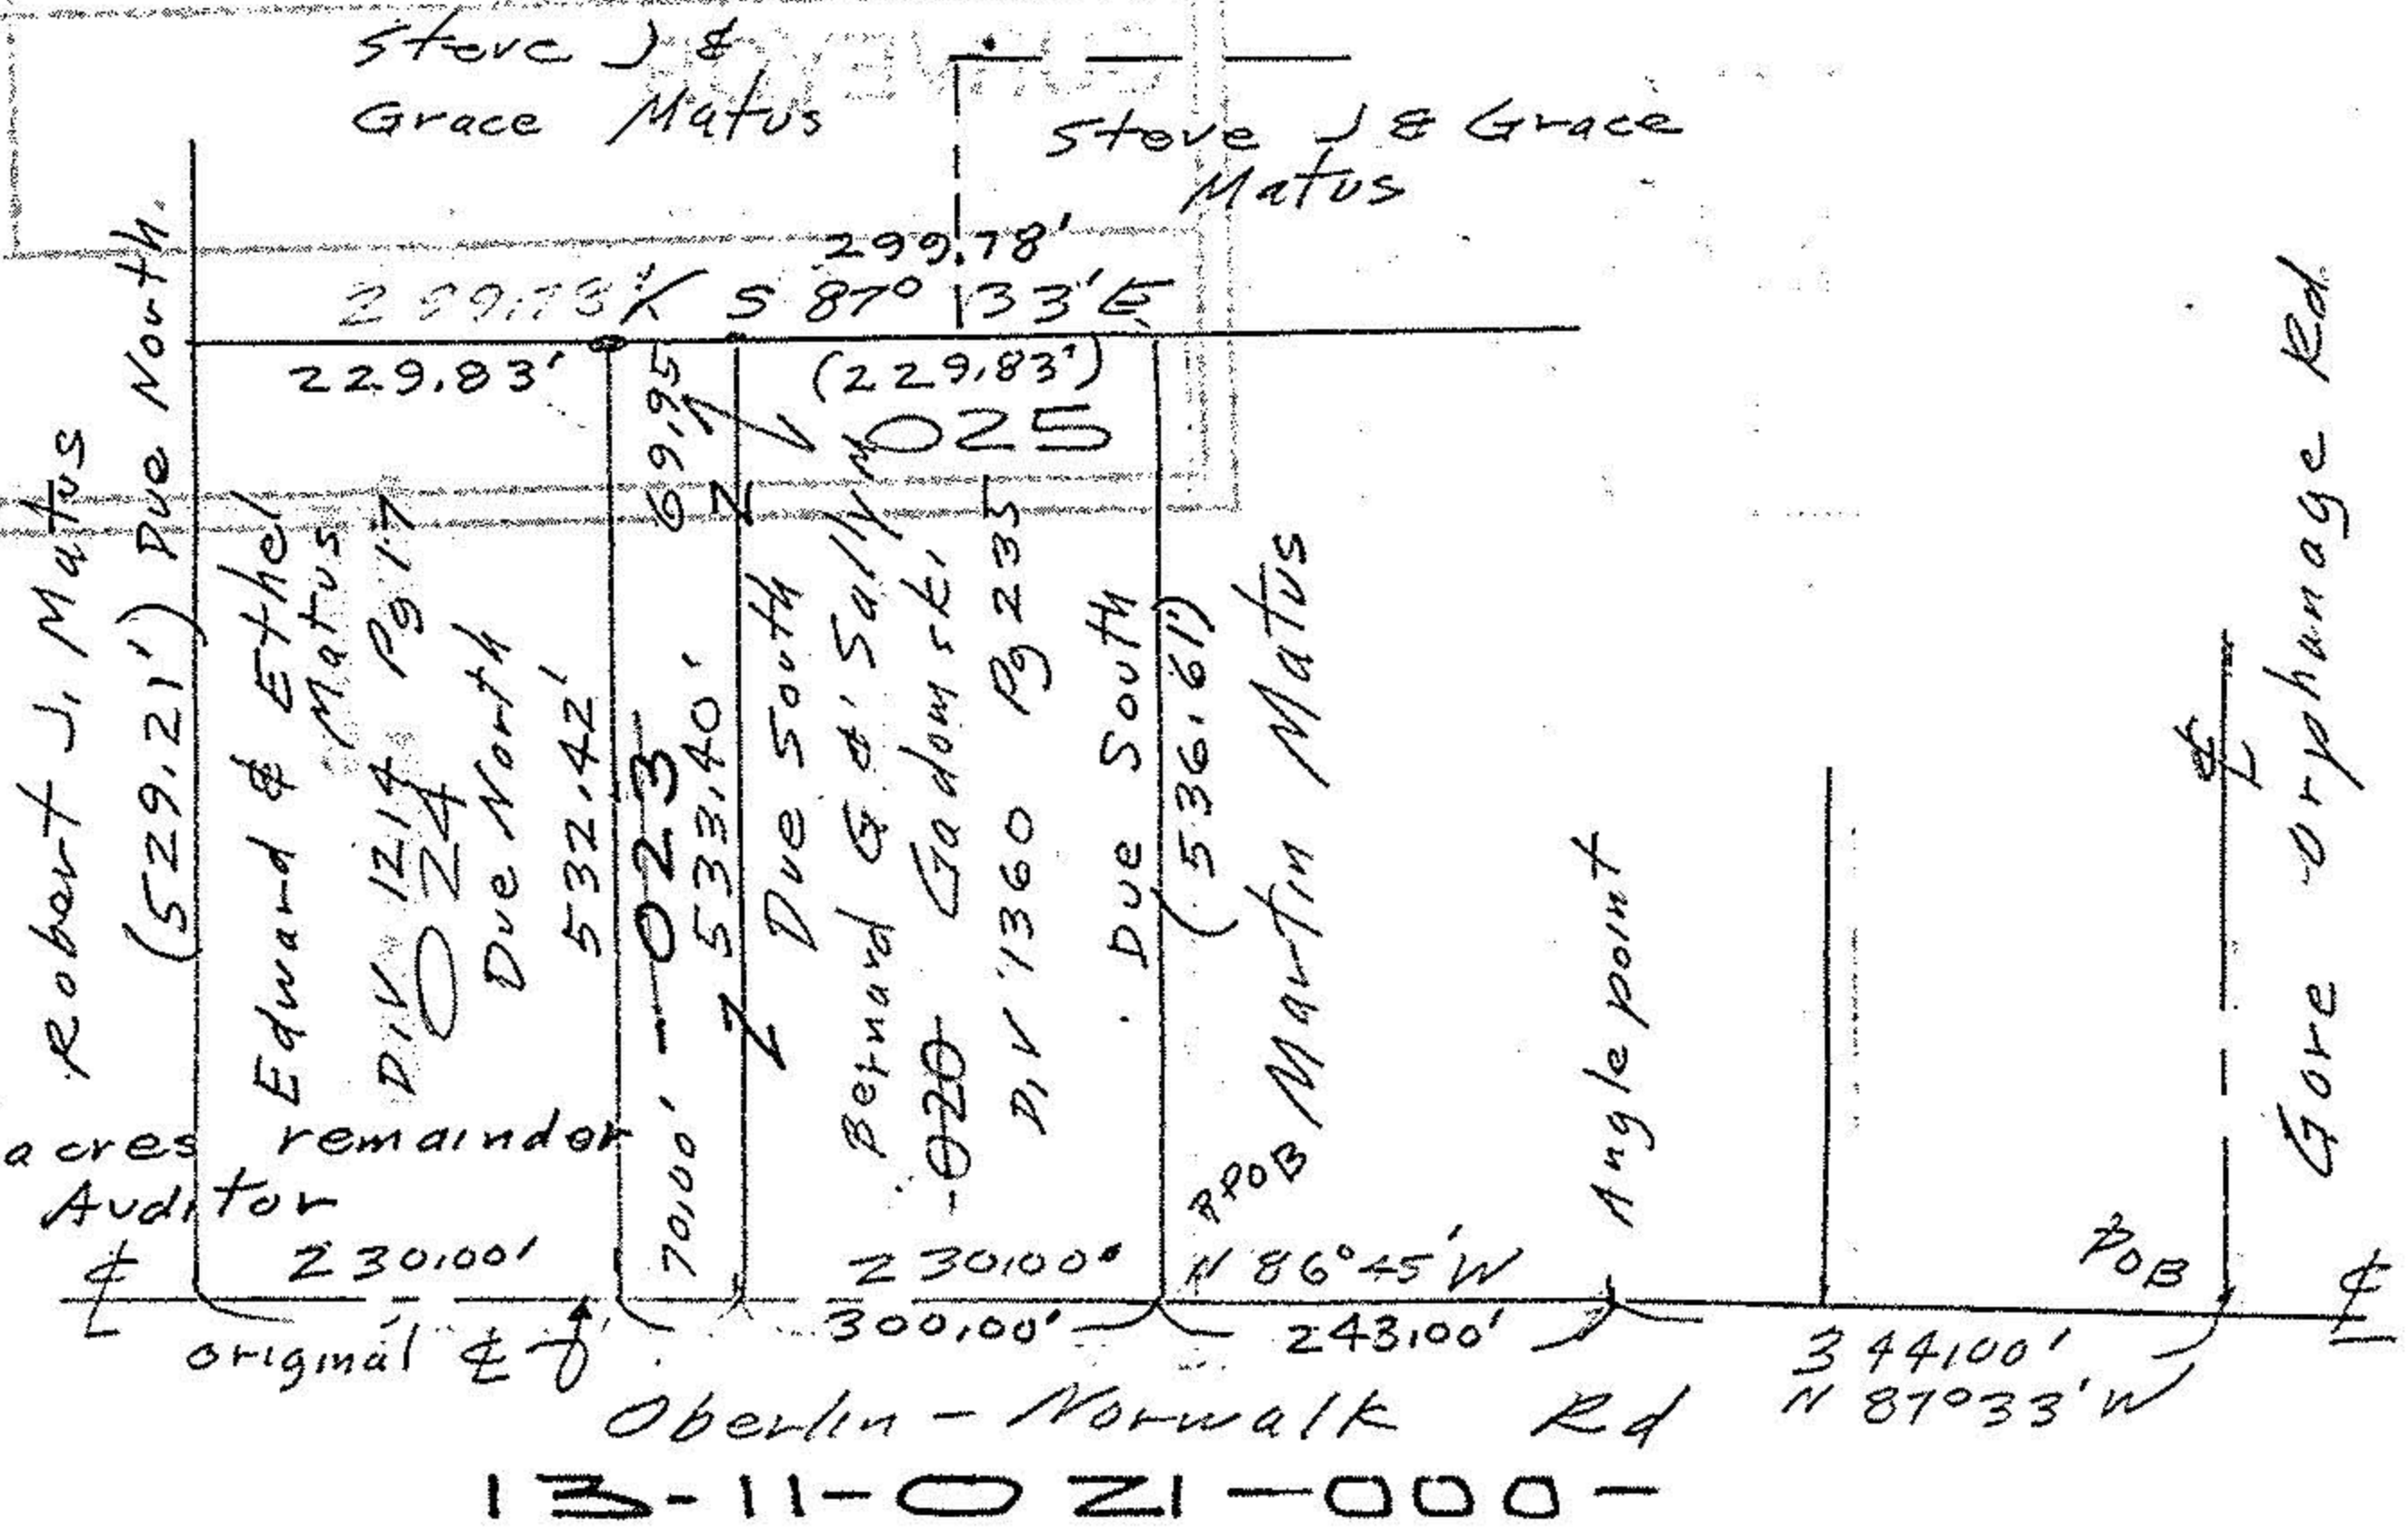


20781

APPROVED
 LORAIN CO.
 MAP DEPT.
 DATE 3-23-94
 PAGE 13 A
 BY CAROLYN FRANCIS
 VOID AFTER # 20781

(Deed)
 0 iron pipes fd
 6 iron pipes set

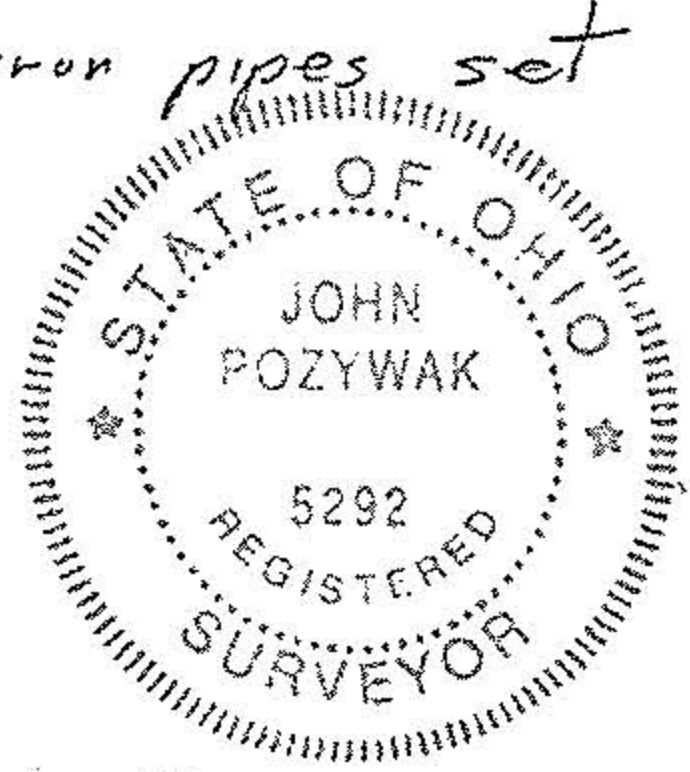

Total 3,675 Acres
 area of split.
 0.855 Acre

subject to easement
 recorded in Div. 1360 Pg 235

John Pozywak
 Reg Surveyor 5292

Parcel split for Ed Matus

Original Lot 21 Tract 11
 Camden Township
 Lorain County Ohio
 scale 1" = 200' Oct 1993
 Dec 1993