14-00-101-000 14-H #13914 14-00-101-000-009 010

MICHAEL G. HURA & ASSOCIATES

3409 LIBERTY AVE. VERMILION, OHIO

SUBLOT _____ of _____

_____ as recorded in Plat Vol. _____ Page _____

PART of Original Lot 101, Tract _____ Section _____

PITTSFIELD Township LORAIN County of _____

OHIO

City of _____

drawn P.L.R.

date 11.4.80

scale 1" = 300 ft

PERIMETER SURVEY

perm. parcel _____

acreage 23.916
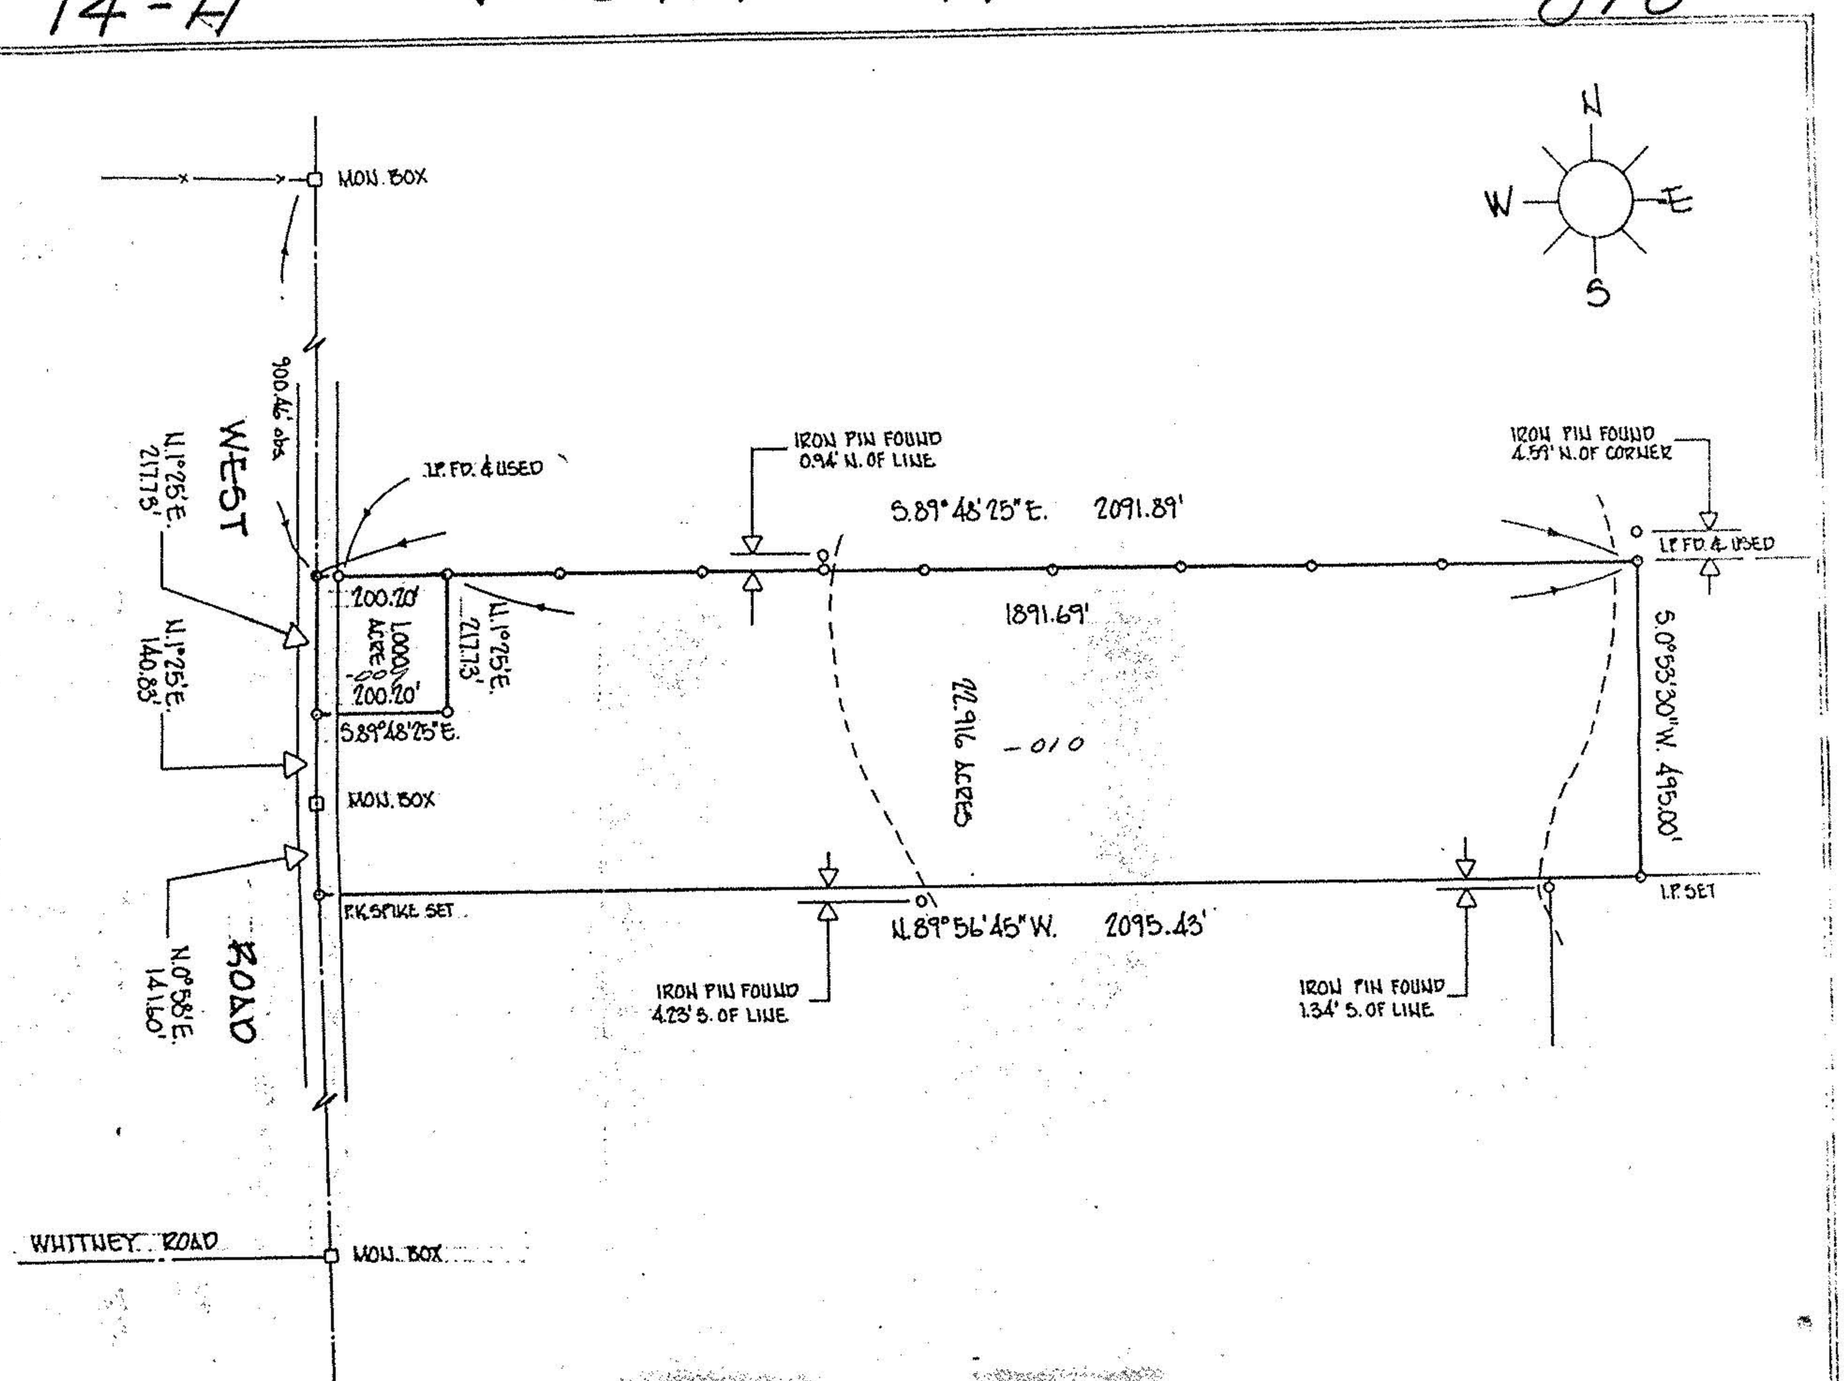
STATE OF OHIO
MICHAEL G. HURA
No. 4712
REGISTERED SURVEYOR