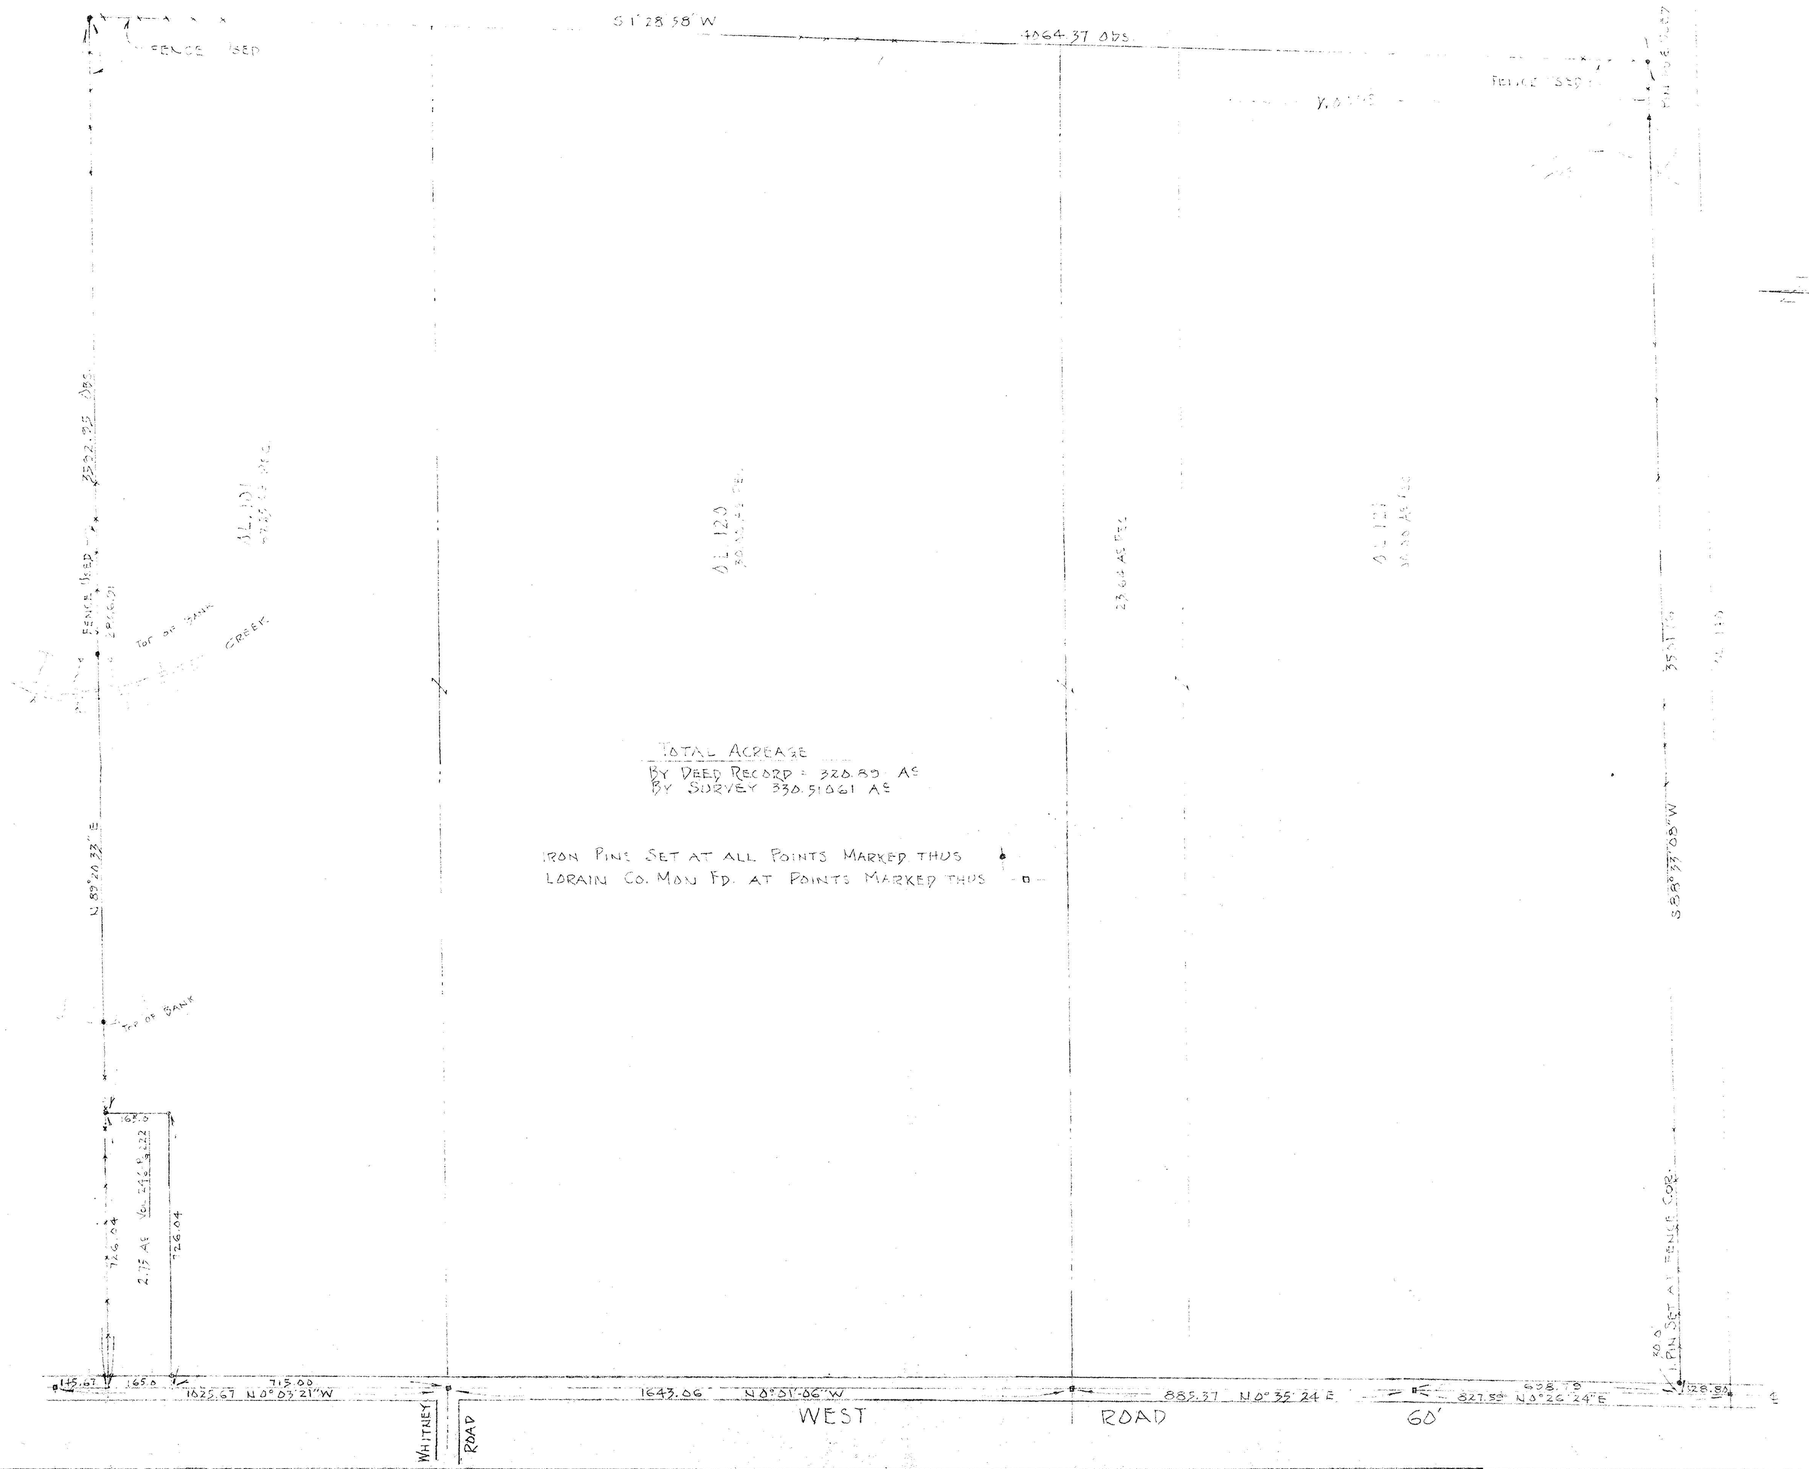

REVISED 1-7-77 - JLM.

LORAIN COUNTY METROPOLITAIN PARK DISTRICT
CALEY WOODS
PITTSFIELD TOWNSHIP

Enviro Tech Consultants
ENGINEERS • SURVEYORS • LAND PLANNERS
4858 OBERLIN AVENUE
LORAIN, OHIO 44053

WCR
1

ORIGINAL LOT	101-120-121	DATE	8-27-76
TOWNSHIP	PITTSFIELD	SCALE	1" = 200'
CITY OF	PITTSFIELD TWP	FIELD BOOK	230 - PG. 83
COUNTY OF	LORAIN	DRAWN BY	J.L.M
STATE OF	OHIO	CHECKED BY	JRS
R. O.	S-1094	FILE NO.	C 14-101