



6993

170  
x 5  
850  
191  
1091

12-00-114

WHITNEY

ROAD 60'

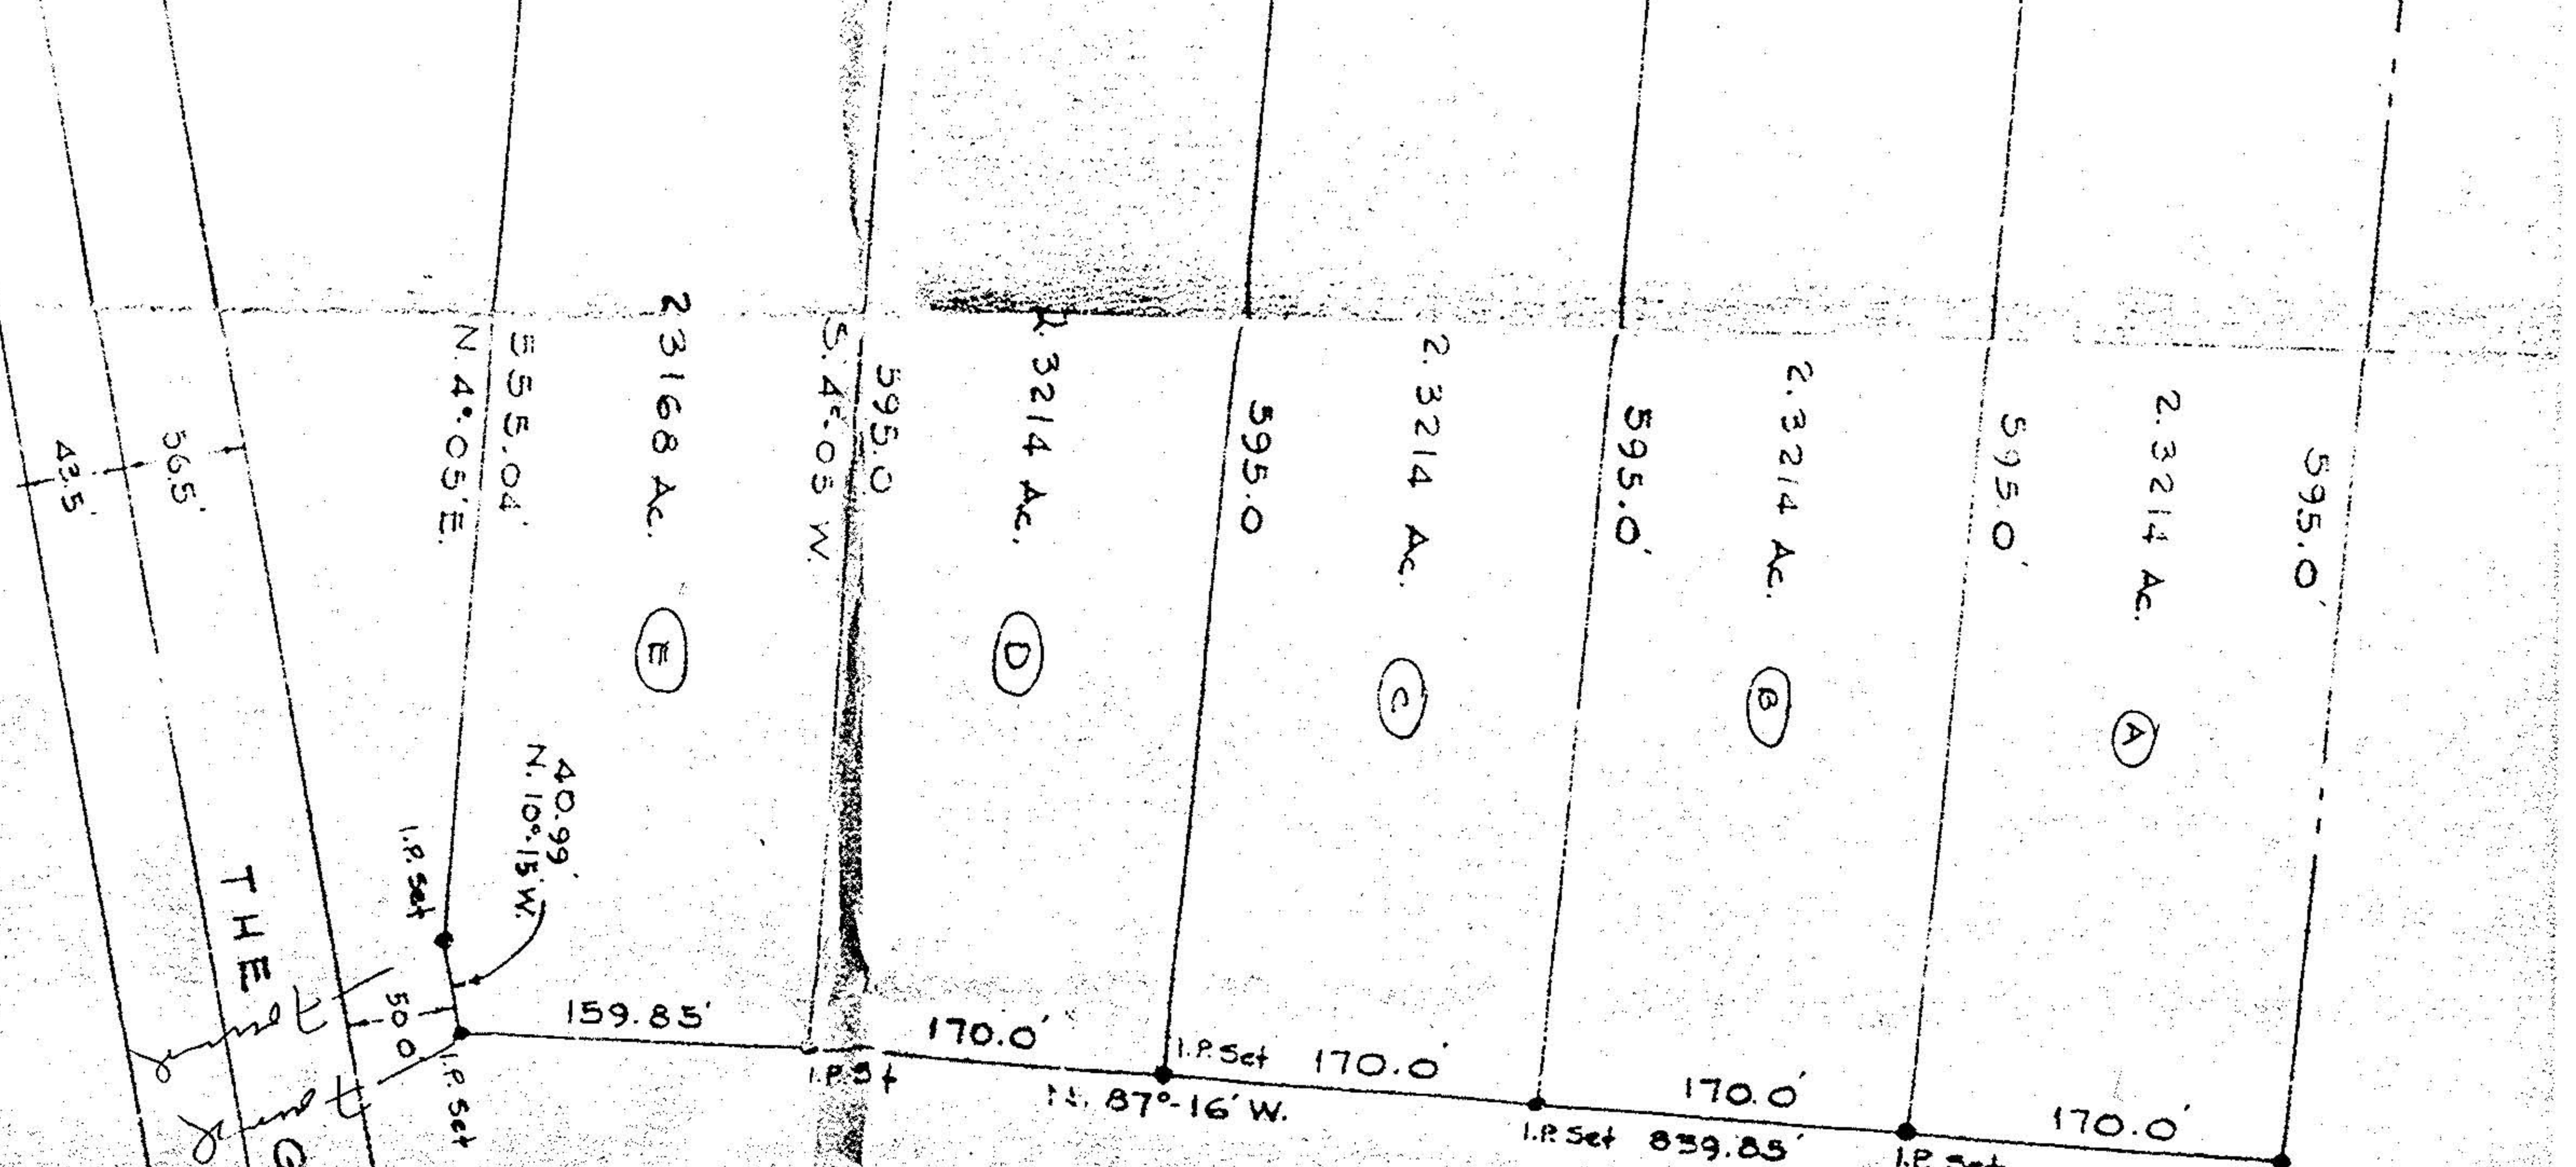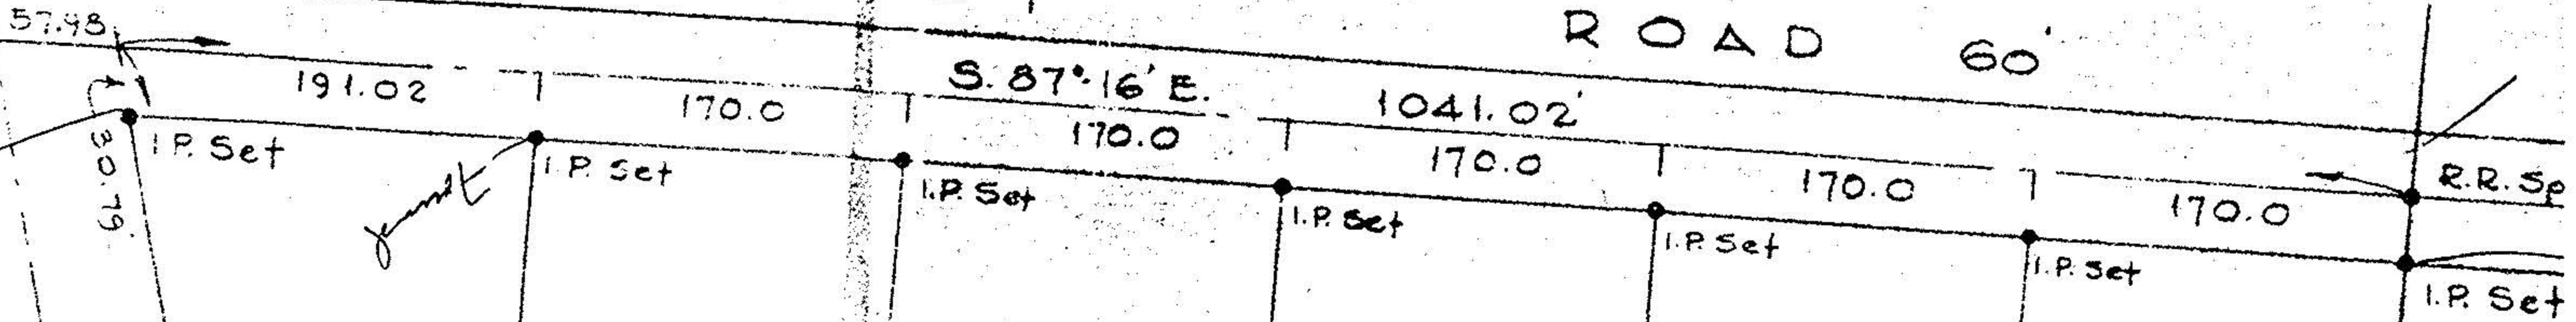

THE

40.99'  
N. 10° 15' W.

565  
43.5

E 55.04'  
N. 4° 05' E.

S. 4° 03' W.

S. 87° 16' E.

595.0'






595.0'

57.48

30.79

191.02

170.0

S. 87° 16' E.

170.0

1041.02

170.0

170.0

170.0

R.R. Sp

I.P. Set

I.P. Set

I.P. Set

I.P. Set

I.P. Set

I.P. Set

I.P. Set






I.P. Set

I.P. Set

I.P. Set

I.P. Set

I.P. Set

170.0'

170.0'

170.0'

170.0'

N. 87° 16' W.

839.85'

159.85'