MAP OF SURVEY, LOT SPLIT AND ASSEMBLY

PREPARED FOR

DALE AND JANEY SUE JACKSON

SITUATED IN THE TOWNSHIP OF PITTSFIELD, COUNTY OF LORAIN, STATE OF OHIO
AND BEING KNOWN AS PART OF ORIGINAL PITTSFIELD TOWNSHIP LOT 115

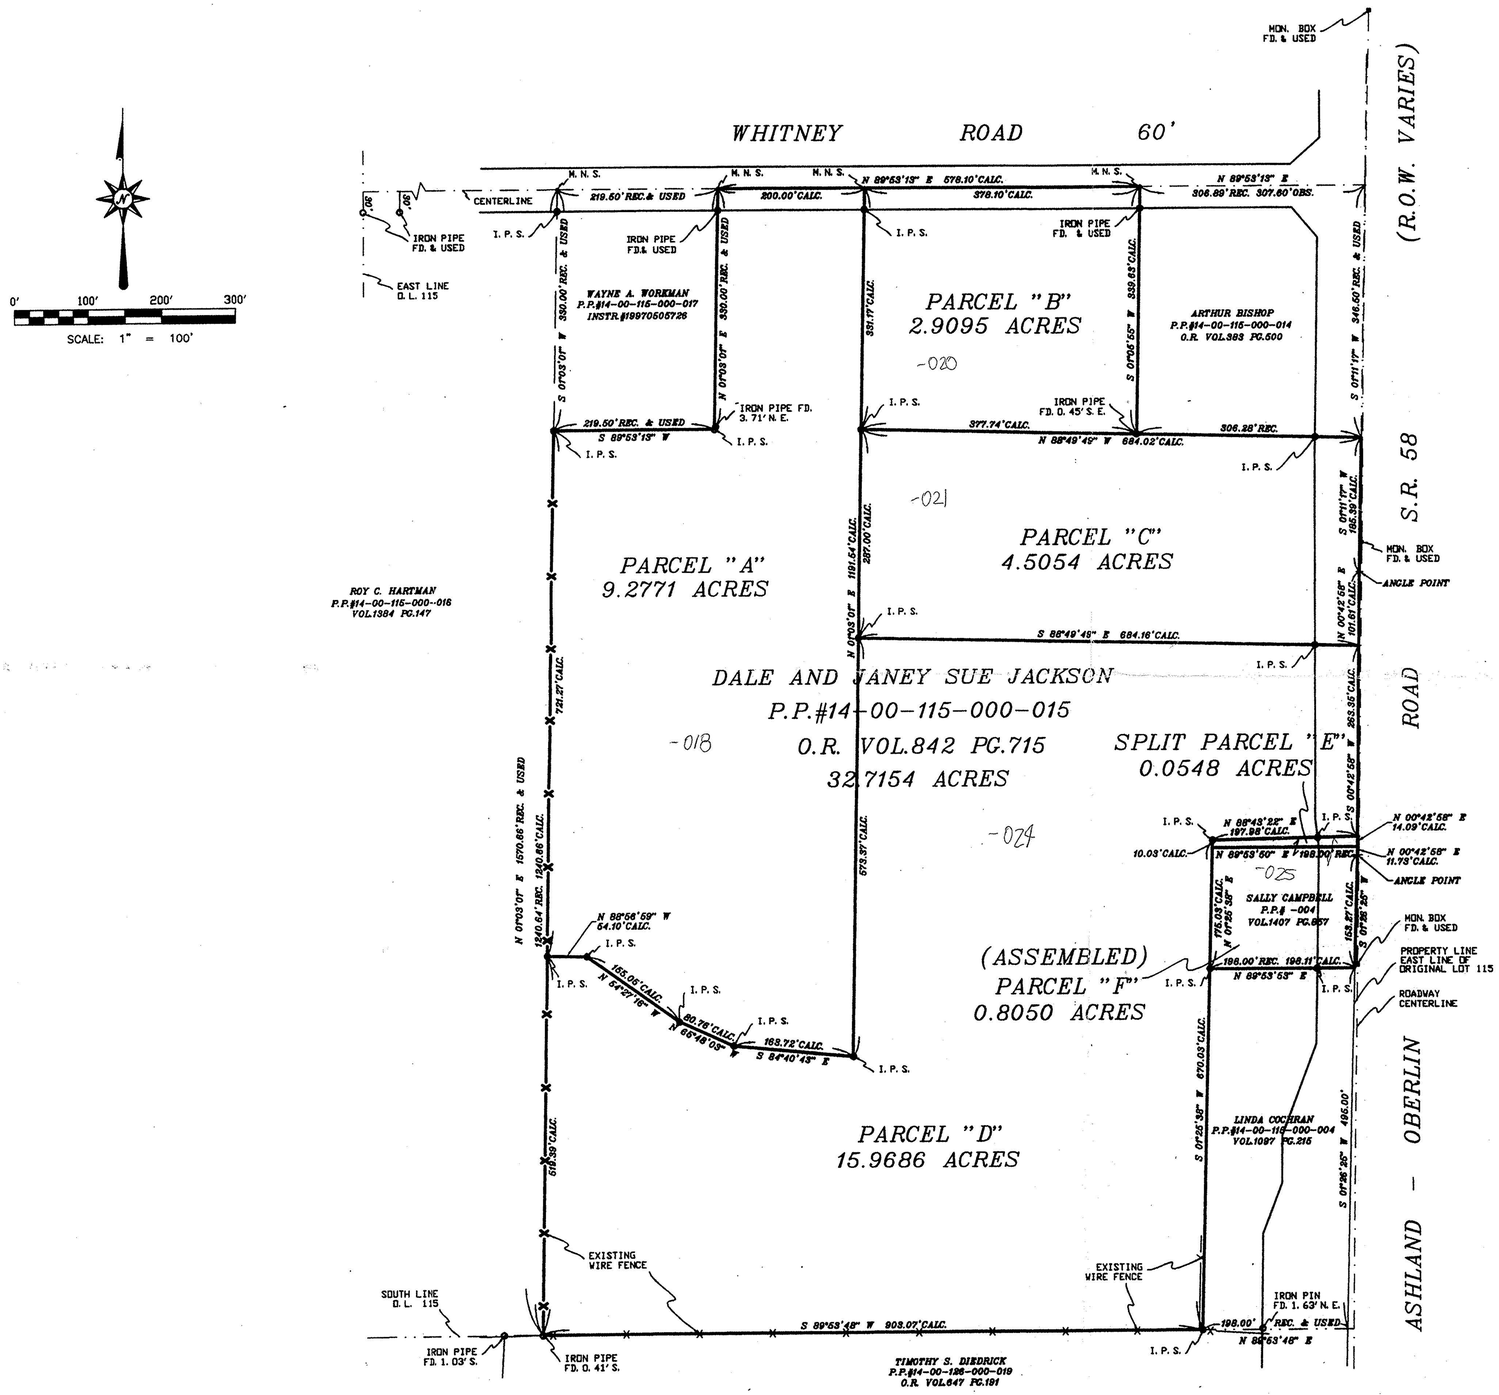

SURVEYOR'S STATEMENT

DISTANCES ARE ARE EXPRESSED IN FEET AND DECIMAL PARTS THEREOF. BEARINGS ARE BASED AN ASSUMED MERIDIAN AND ARE USED TO INDICATE ANGLES ONLY. PERMANENT MONUMENTS WERE FOUND OR SET AS INDICATED HEREON. —o— I.P.S. INDICATES A 5/8" IRON PIN WITH IDENTIFICATION CAP SET. —•— M.N.S. INDICATES A MAGNETIC NAIL SET. ALL OF WHICH I DECLARE TO BE CORRECT TO THE BEST OF MY ABILITY AND BELIEF.

Thomas M. Snezek

THOMAS M. SNEZEK, R.L.S. No. 7051

STATE OF OHIO — THOMAS M. SNEZEK S-7051 — SURVEYOR

11-21-02
DATE

No 01285

APPROVED LORAIN CO. MAP DEPT
DATE 12-31-02
PAGE 14-F
BY JHatfield
02-0128S

PREPARED BY:

THOMAS M. SNEZEK, P.S.

PROFESSIONAL LAND SURVEYOR NO. 7051
3496 COLLETTA LANE
(216) 671-4902

DATE: 11/22/02
CLEVELAND, OHIO
44111

PROJECT NO. 0215