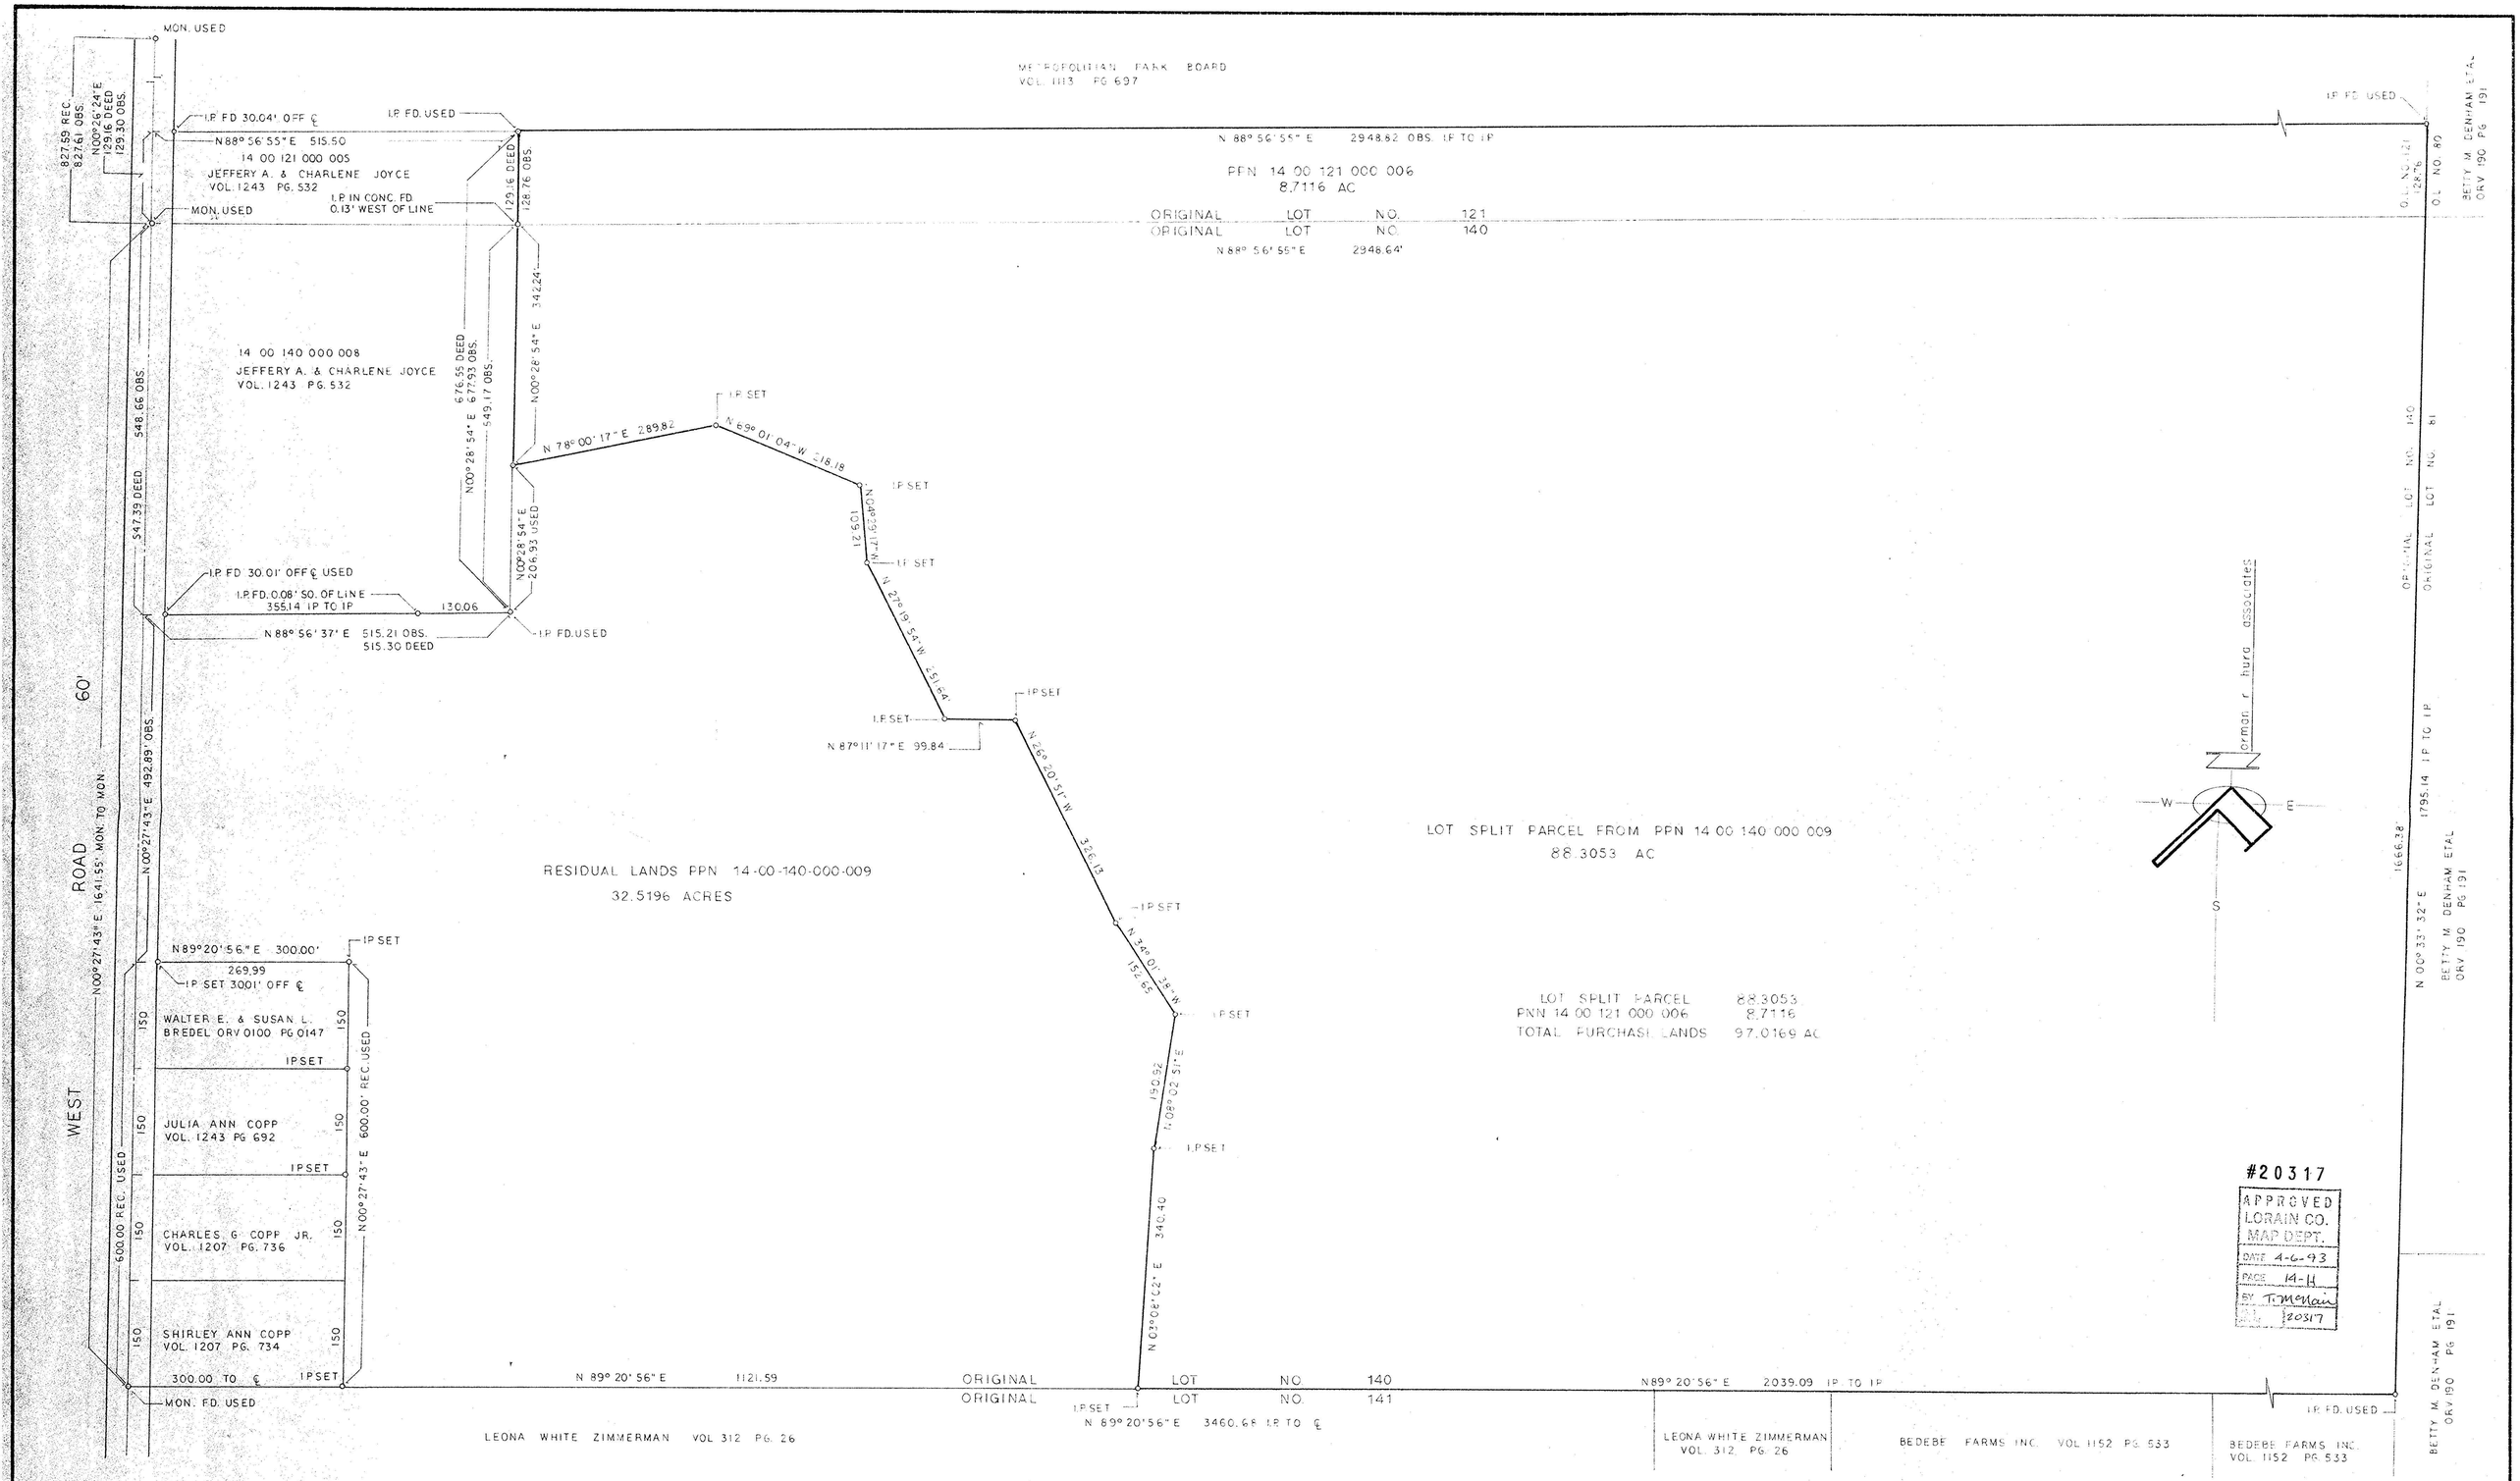

LORAIN COUNTY METROPOLITAN PARK DISTRICT	LOT SPLIT FROM PPN 14-00-140-000-009 & 14-00-121-000-006 CHARLES G. COPP JR. & SHIRLEY ANN COPP VOL 1050 PG. 243	PART OF ORIGINAL LOTS 121 AND 140 PITTSFIELD TOWNSHIP LORAIN COUNTY - OHIO	FEBRUARY 1993	STATE OF OHIO H. R. HURA 5203 REGISTERED PROFESSIONAL SURVEYOR

5021