




| | | |
|------------------------|------------------|------------------------------|
| Orig. Lot No. 122 | City of | Date 7/12/00 Scale 1" = 100' |
| Orig. Sec No. | Village of | Dwn. by R.G.S. Chkd. by R.C. |
| Tract | County of LORAIN | Job No. 00-3259 F.B. - |
| Township of PITTSFIELD | State of Ohio | Printed |

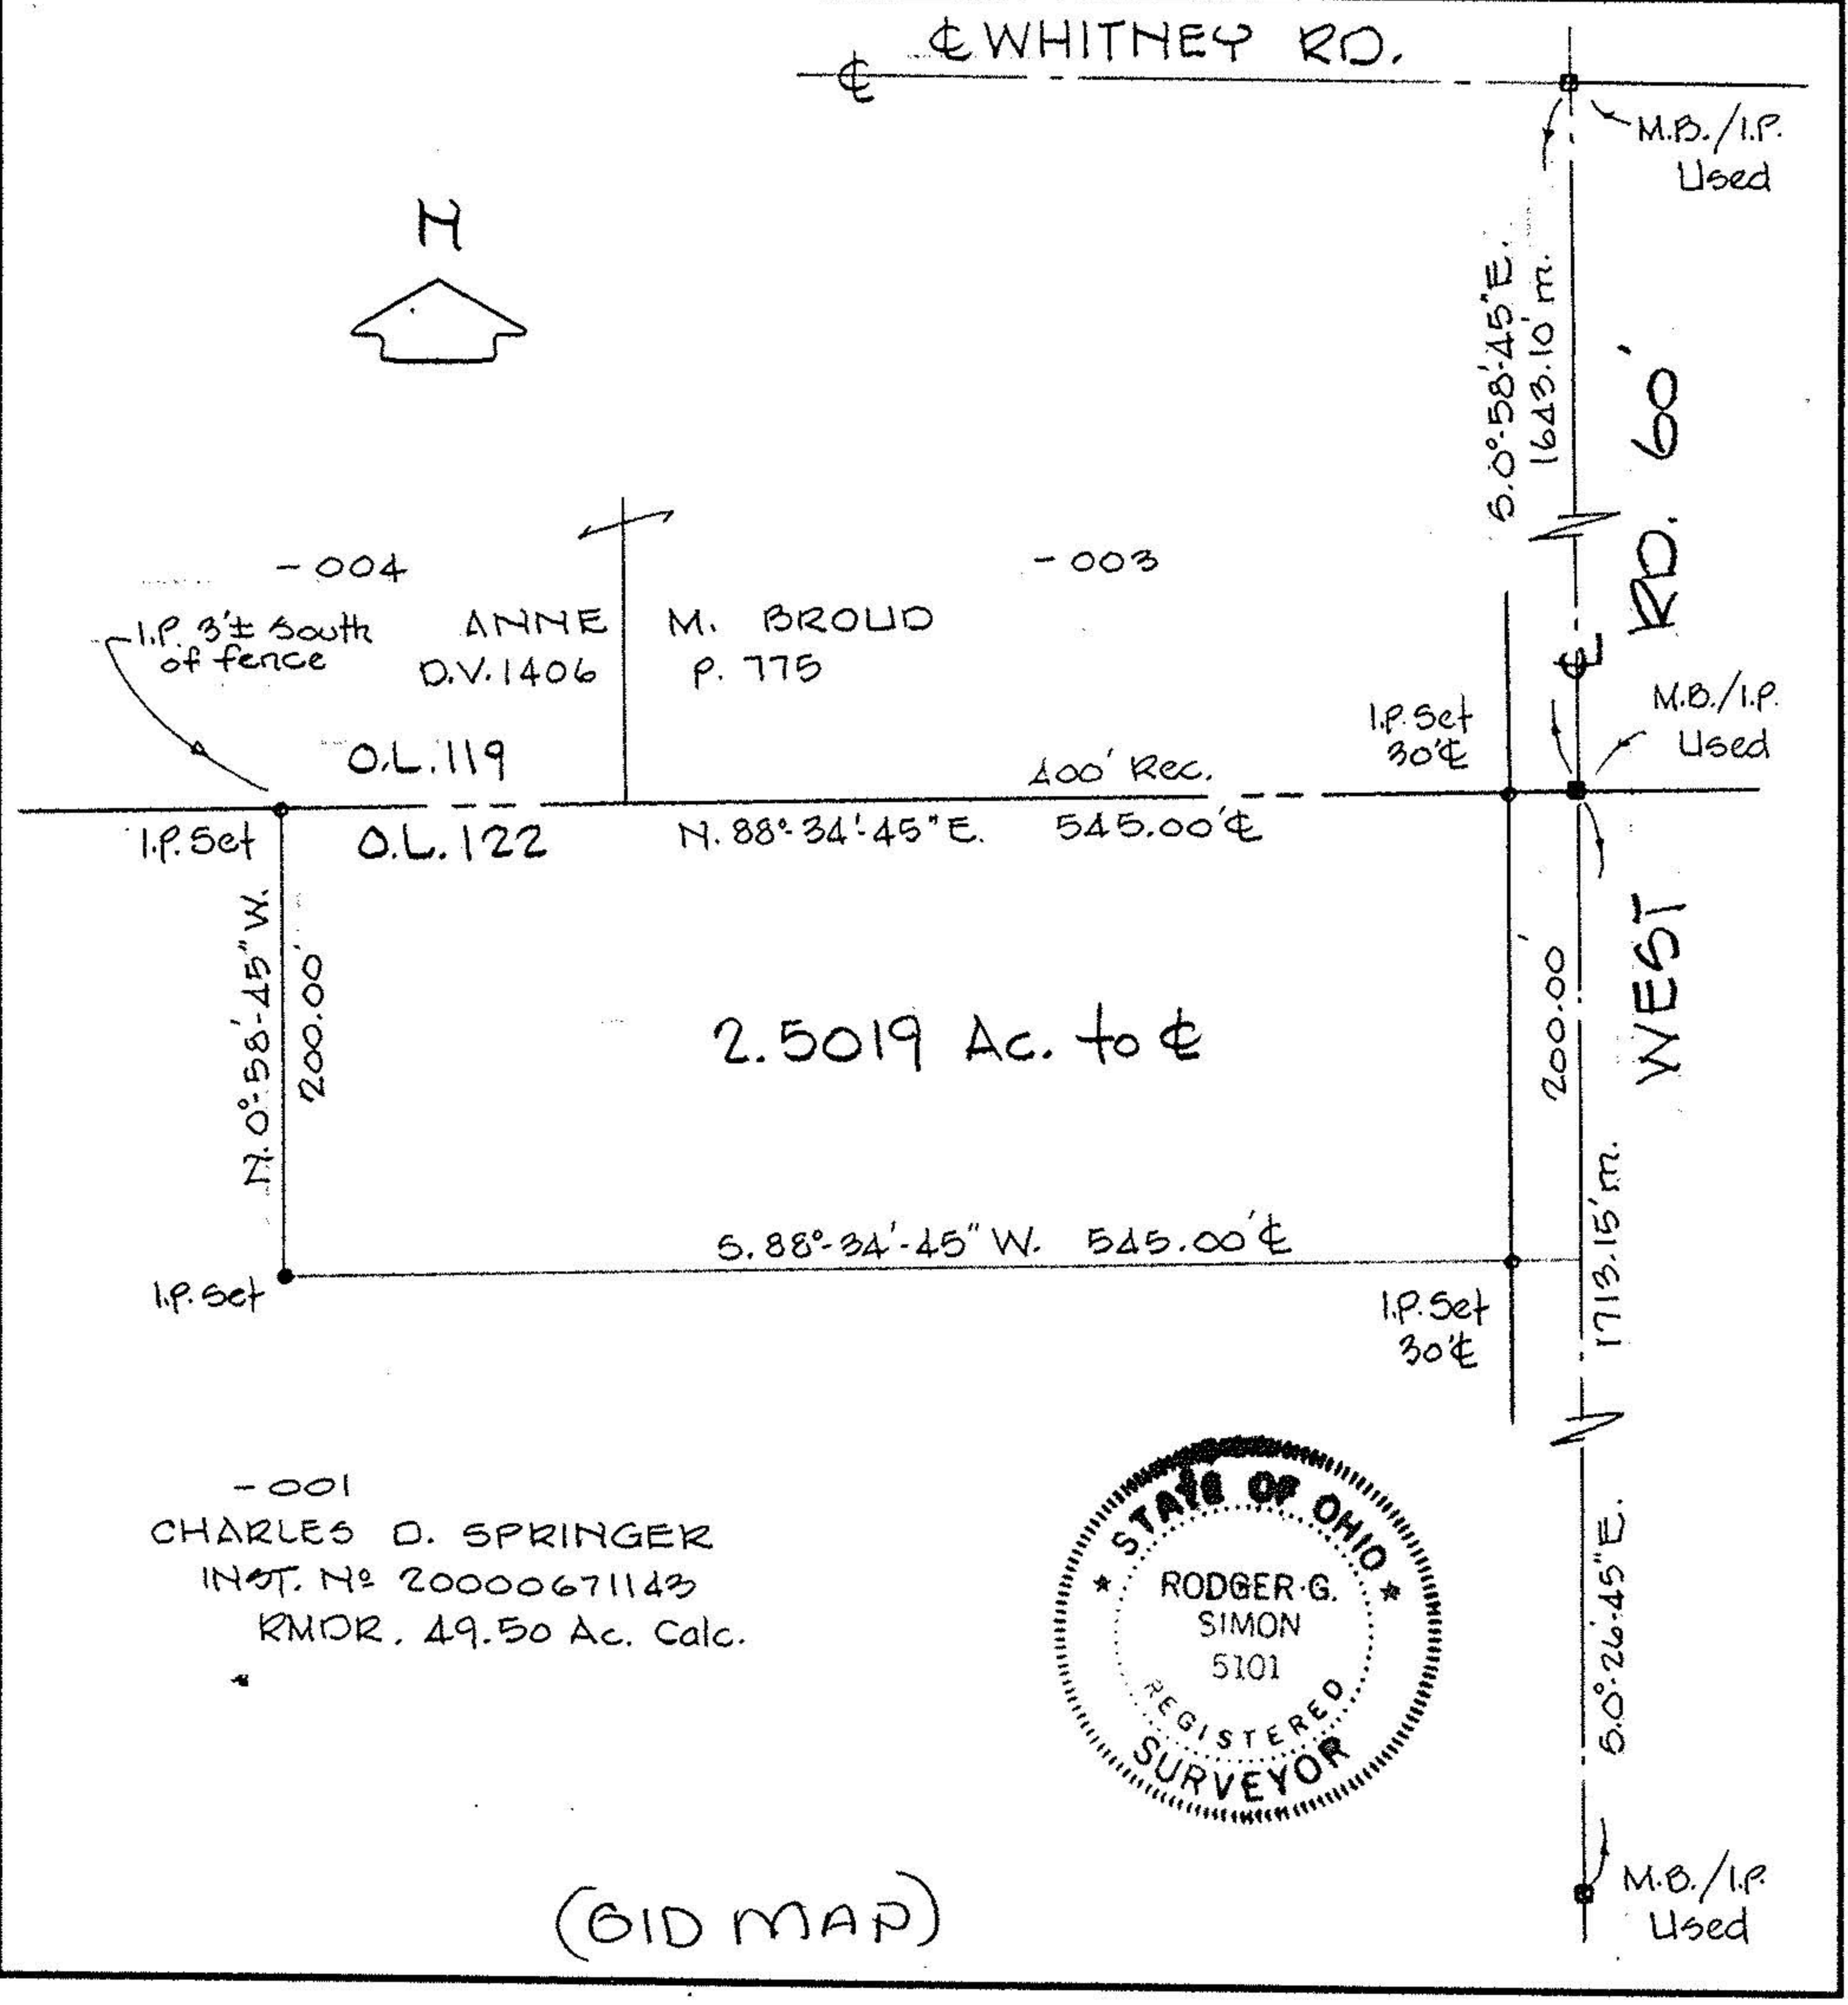

| | | |
|------------------------|------------------|------------------------------|
| Orig. Lot No. 122 | City of | Date 7/12/00 Scale 1" = 100' |
| Orig. Sec No. | Village of | Dwn. by R.G.S. Chkd. by R.C. |
| Tract | County of LORAIN | Job No. 00-3259 F.B. - |
| Township of PITTSFIELD | State of Ohio | Printed |

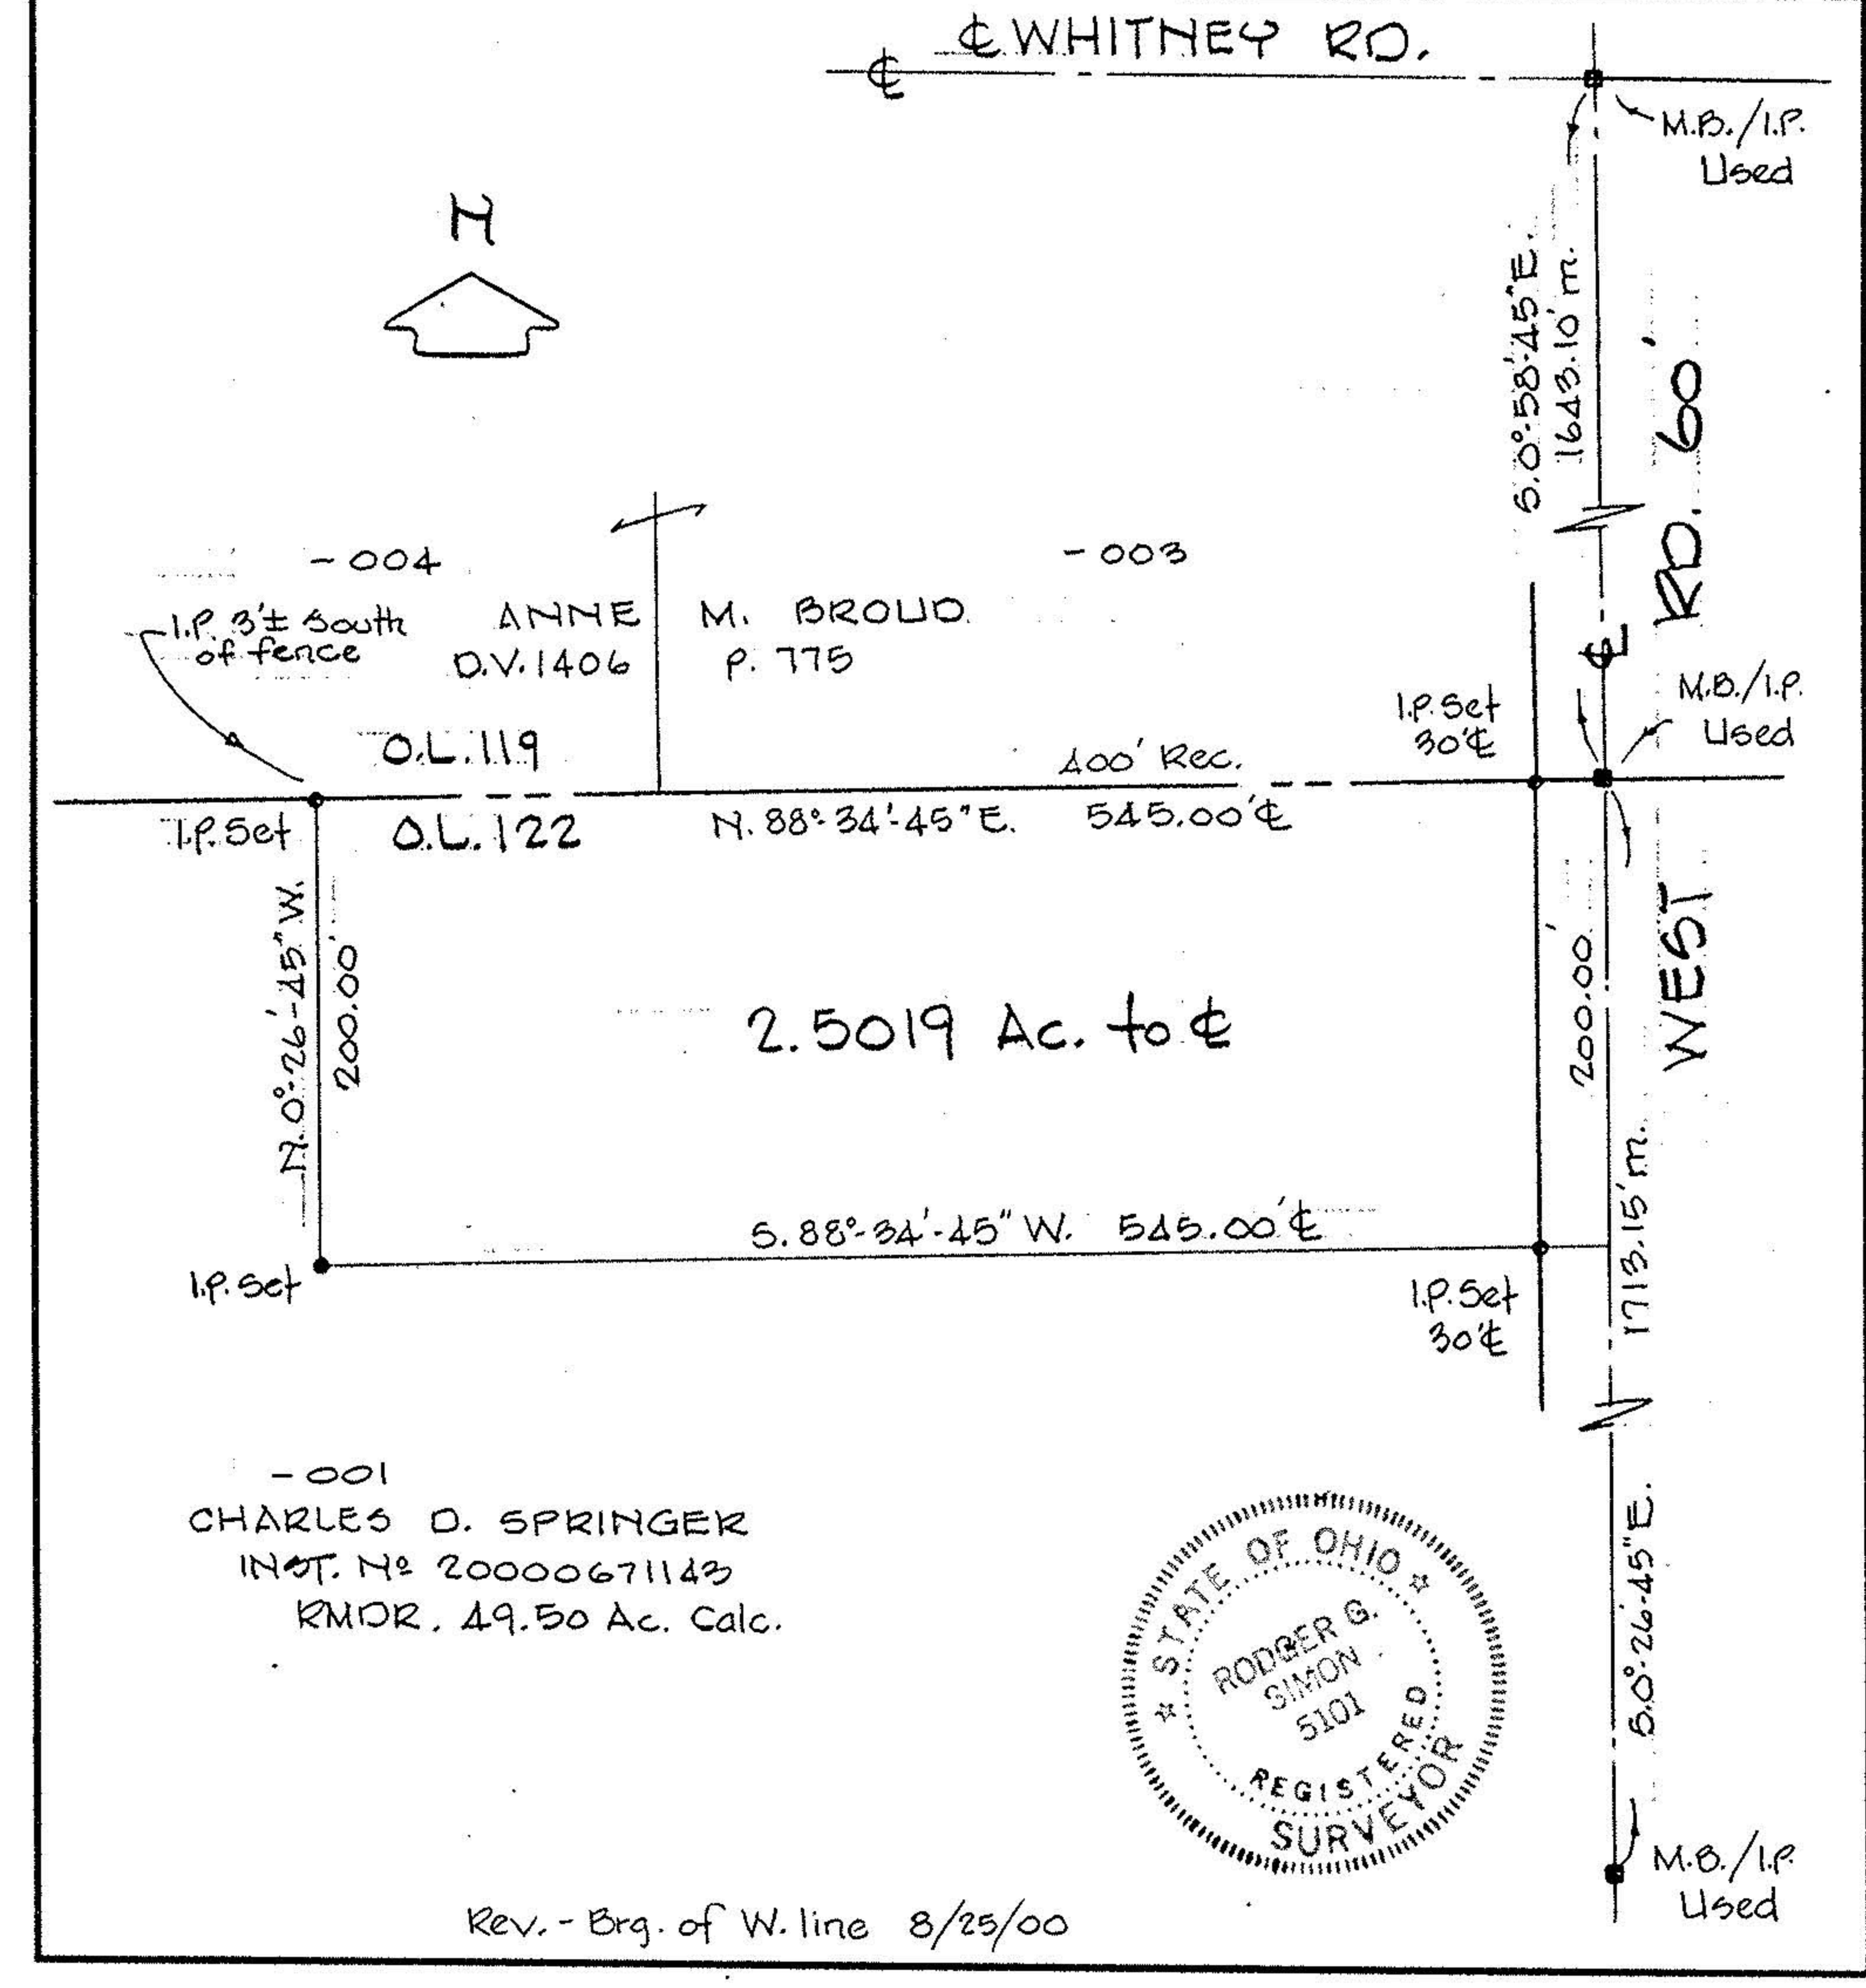

| | | |
|------------------------|------------------|------------------------------|
| Orig. Lot No. 122 | City of | Date 7/12/00 Scale 1" = 100' |
| Orig. Sec No. | Village of | Dwn. by R.G.S. Chkd. by R.C. |
| Tract | County of LORAIN | Job No. 00-3259 F.B. - |
| Township of PITTSFIELD | State of Ohio | Printed |

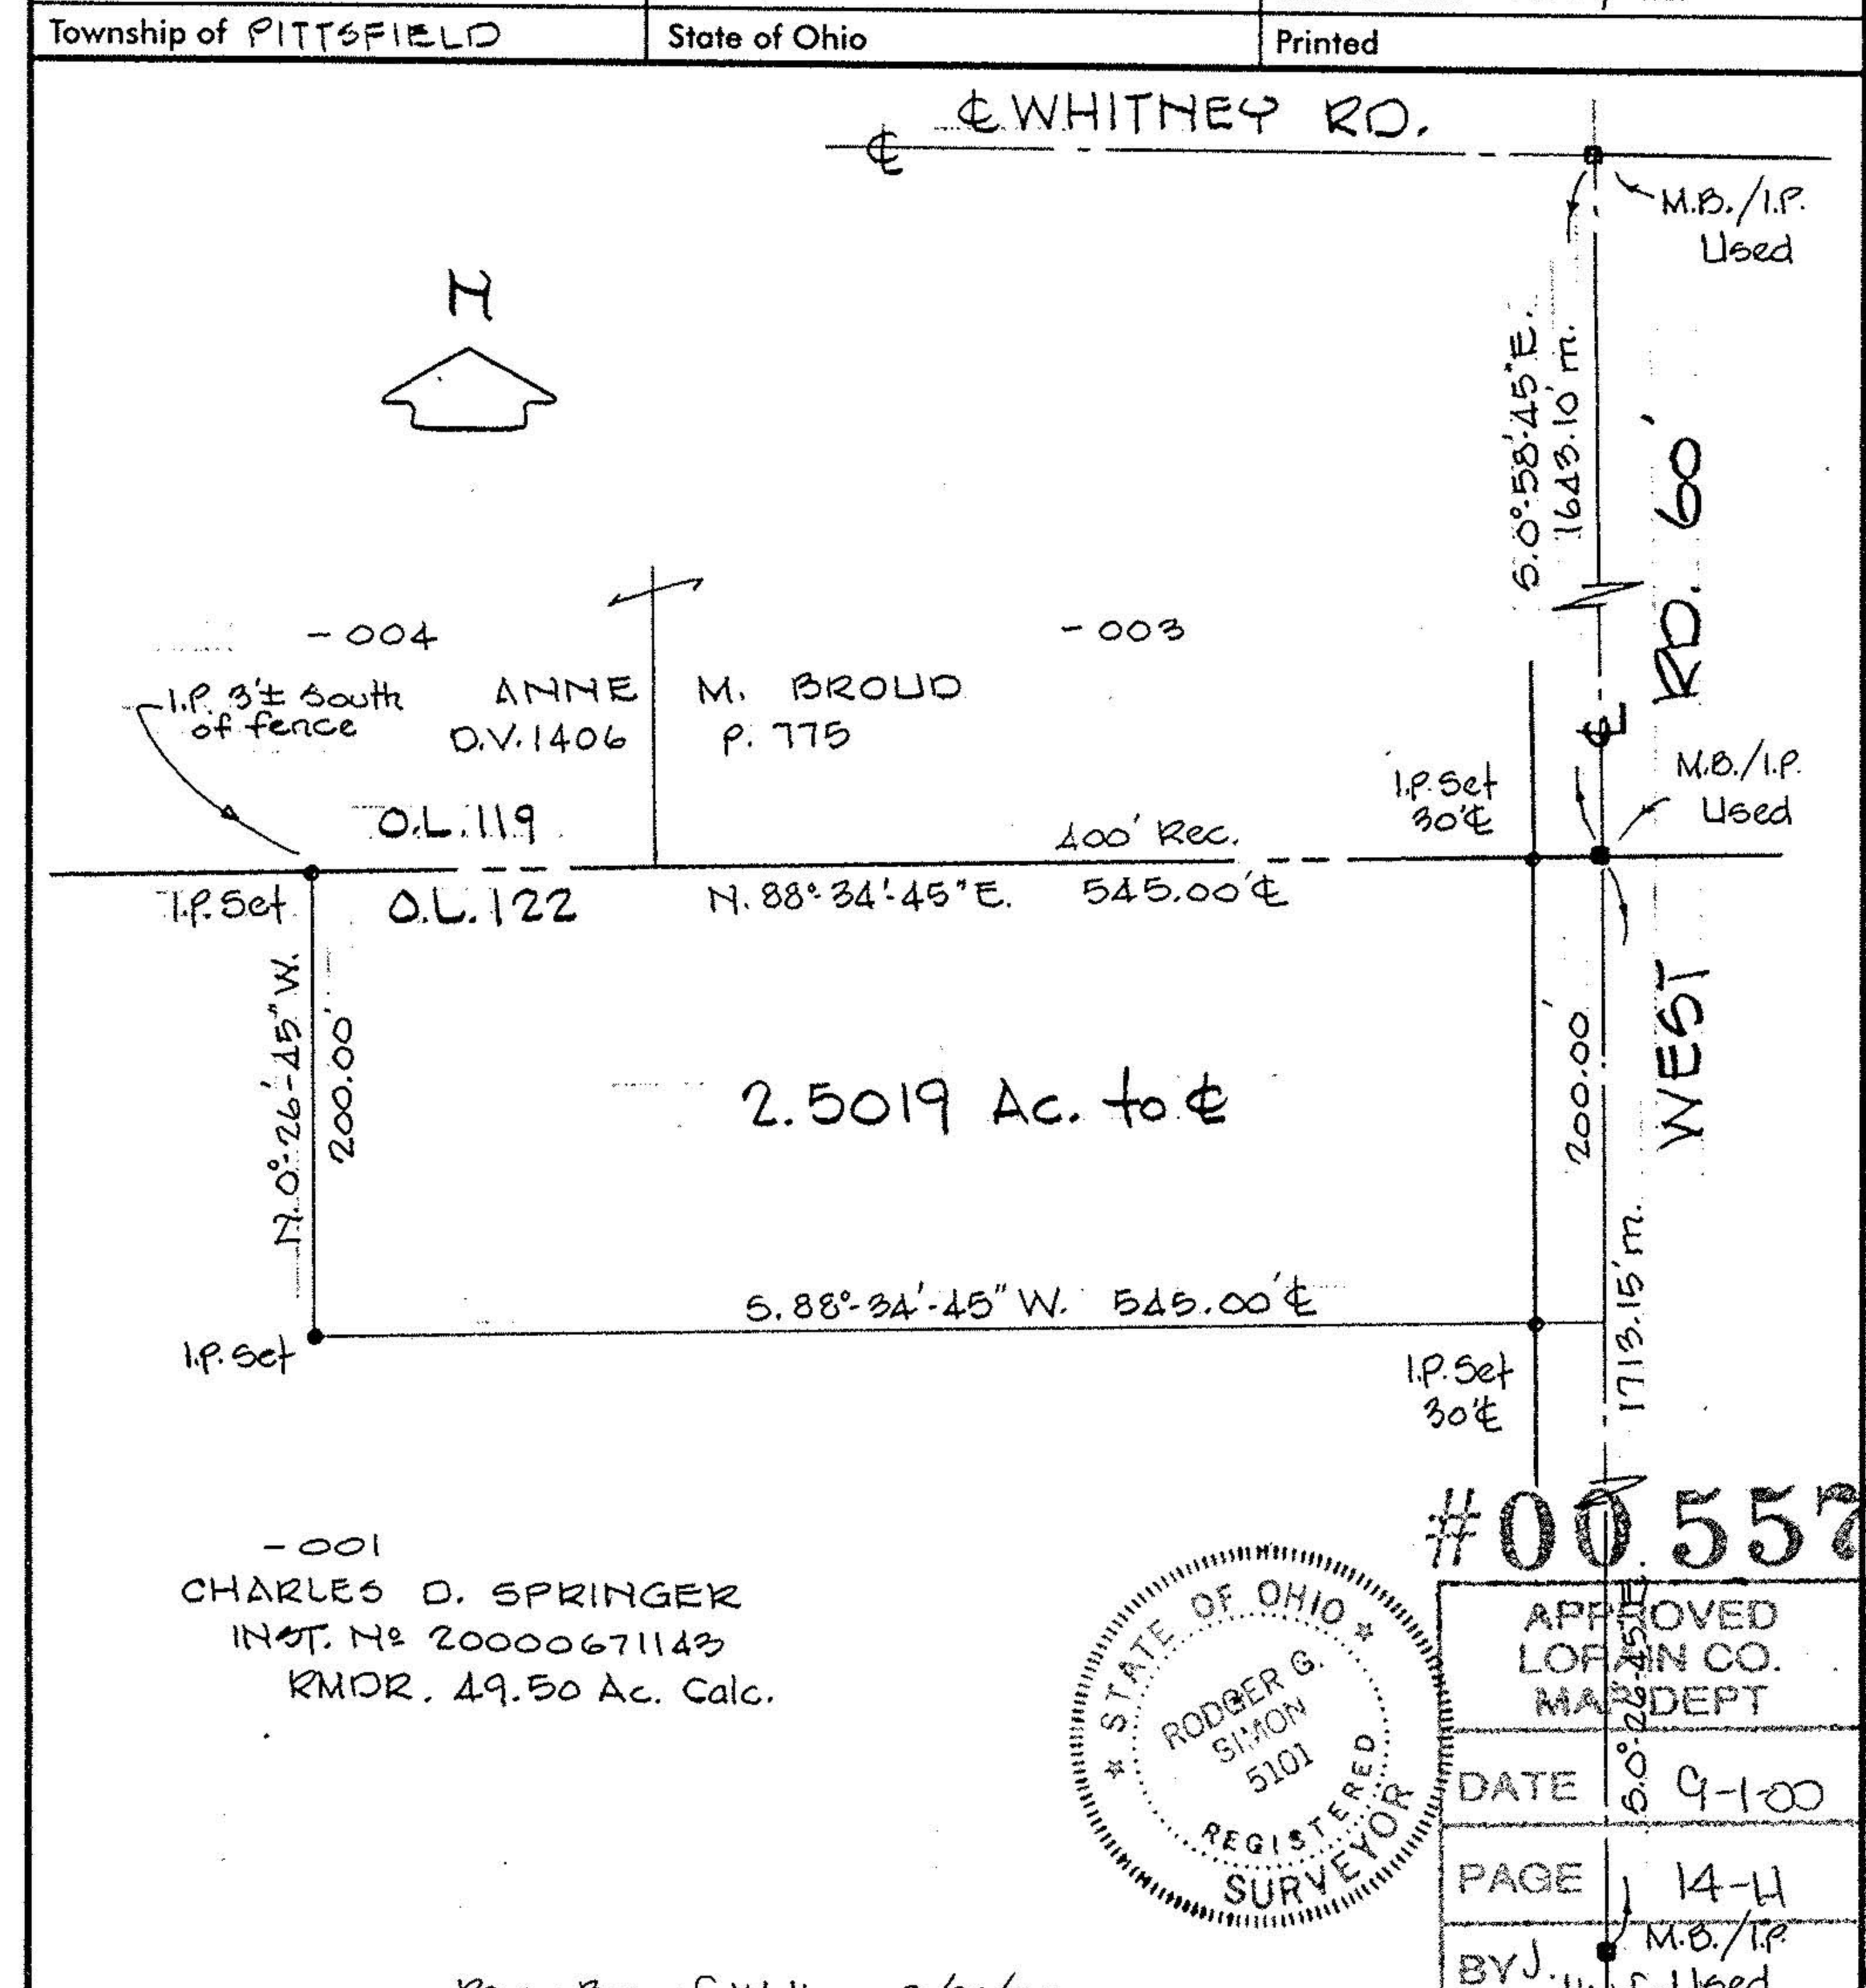

#00557

| | |
|-----------|-----------------------|
| DATE | 9-1-00 |
| PAGE | 14-11 |
| BY | J. M.B./I.P. Hatfield |
| #00-00557 | |