


#00430-A  
 APPROVED  
 LORAIN CO. MAP DEPT.  
 FEB 9/1999  
 14-G  
 T. SPILLMAN  
 100430-A

SURVEY FOR  
**JAMIE C. BRASEE ETAL**  
 PART OF O.L. 125 TOWNSHIP OF PITTSFIELD  
 COUNTY OF LORAIN STATE OF OHIO  
 FEBRUARY 1999 SCALE 1"=100'  
 BY  
 LAUNDON • SIMON • CAHL & ASSOC.  
 PROFESSIONAL LAND SURVEYORS  
 JOB NO. 98-2101 FB. 244 P. 77-79

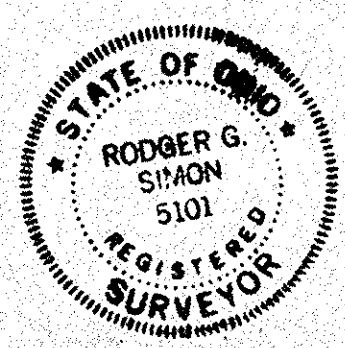

REV. 4-13-00 Corr of Pl's 1 & 2 (Error in Orig. Calcs.)