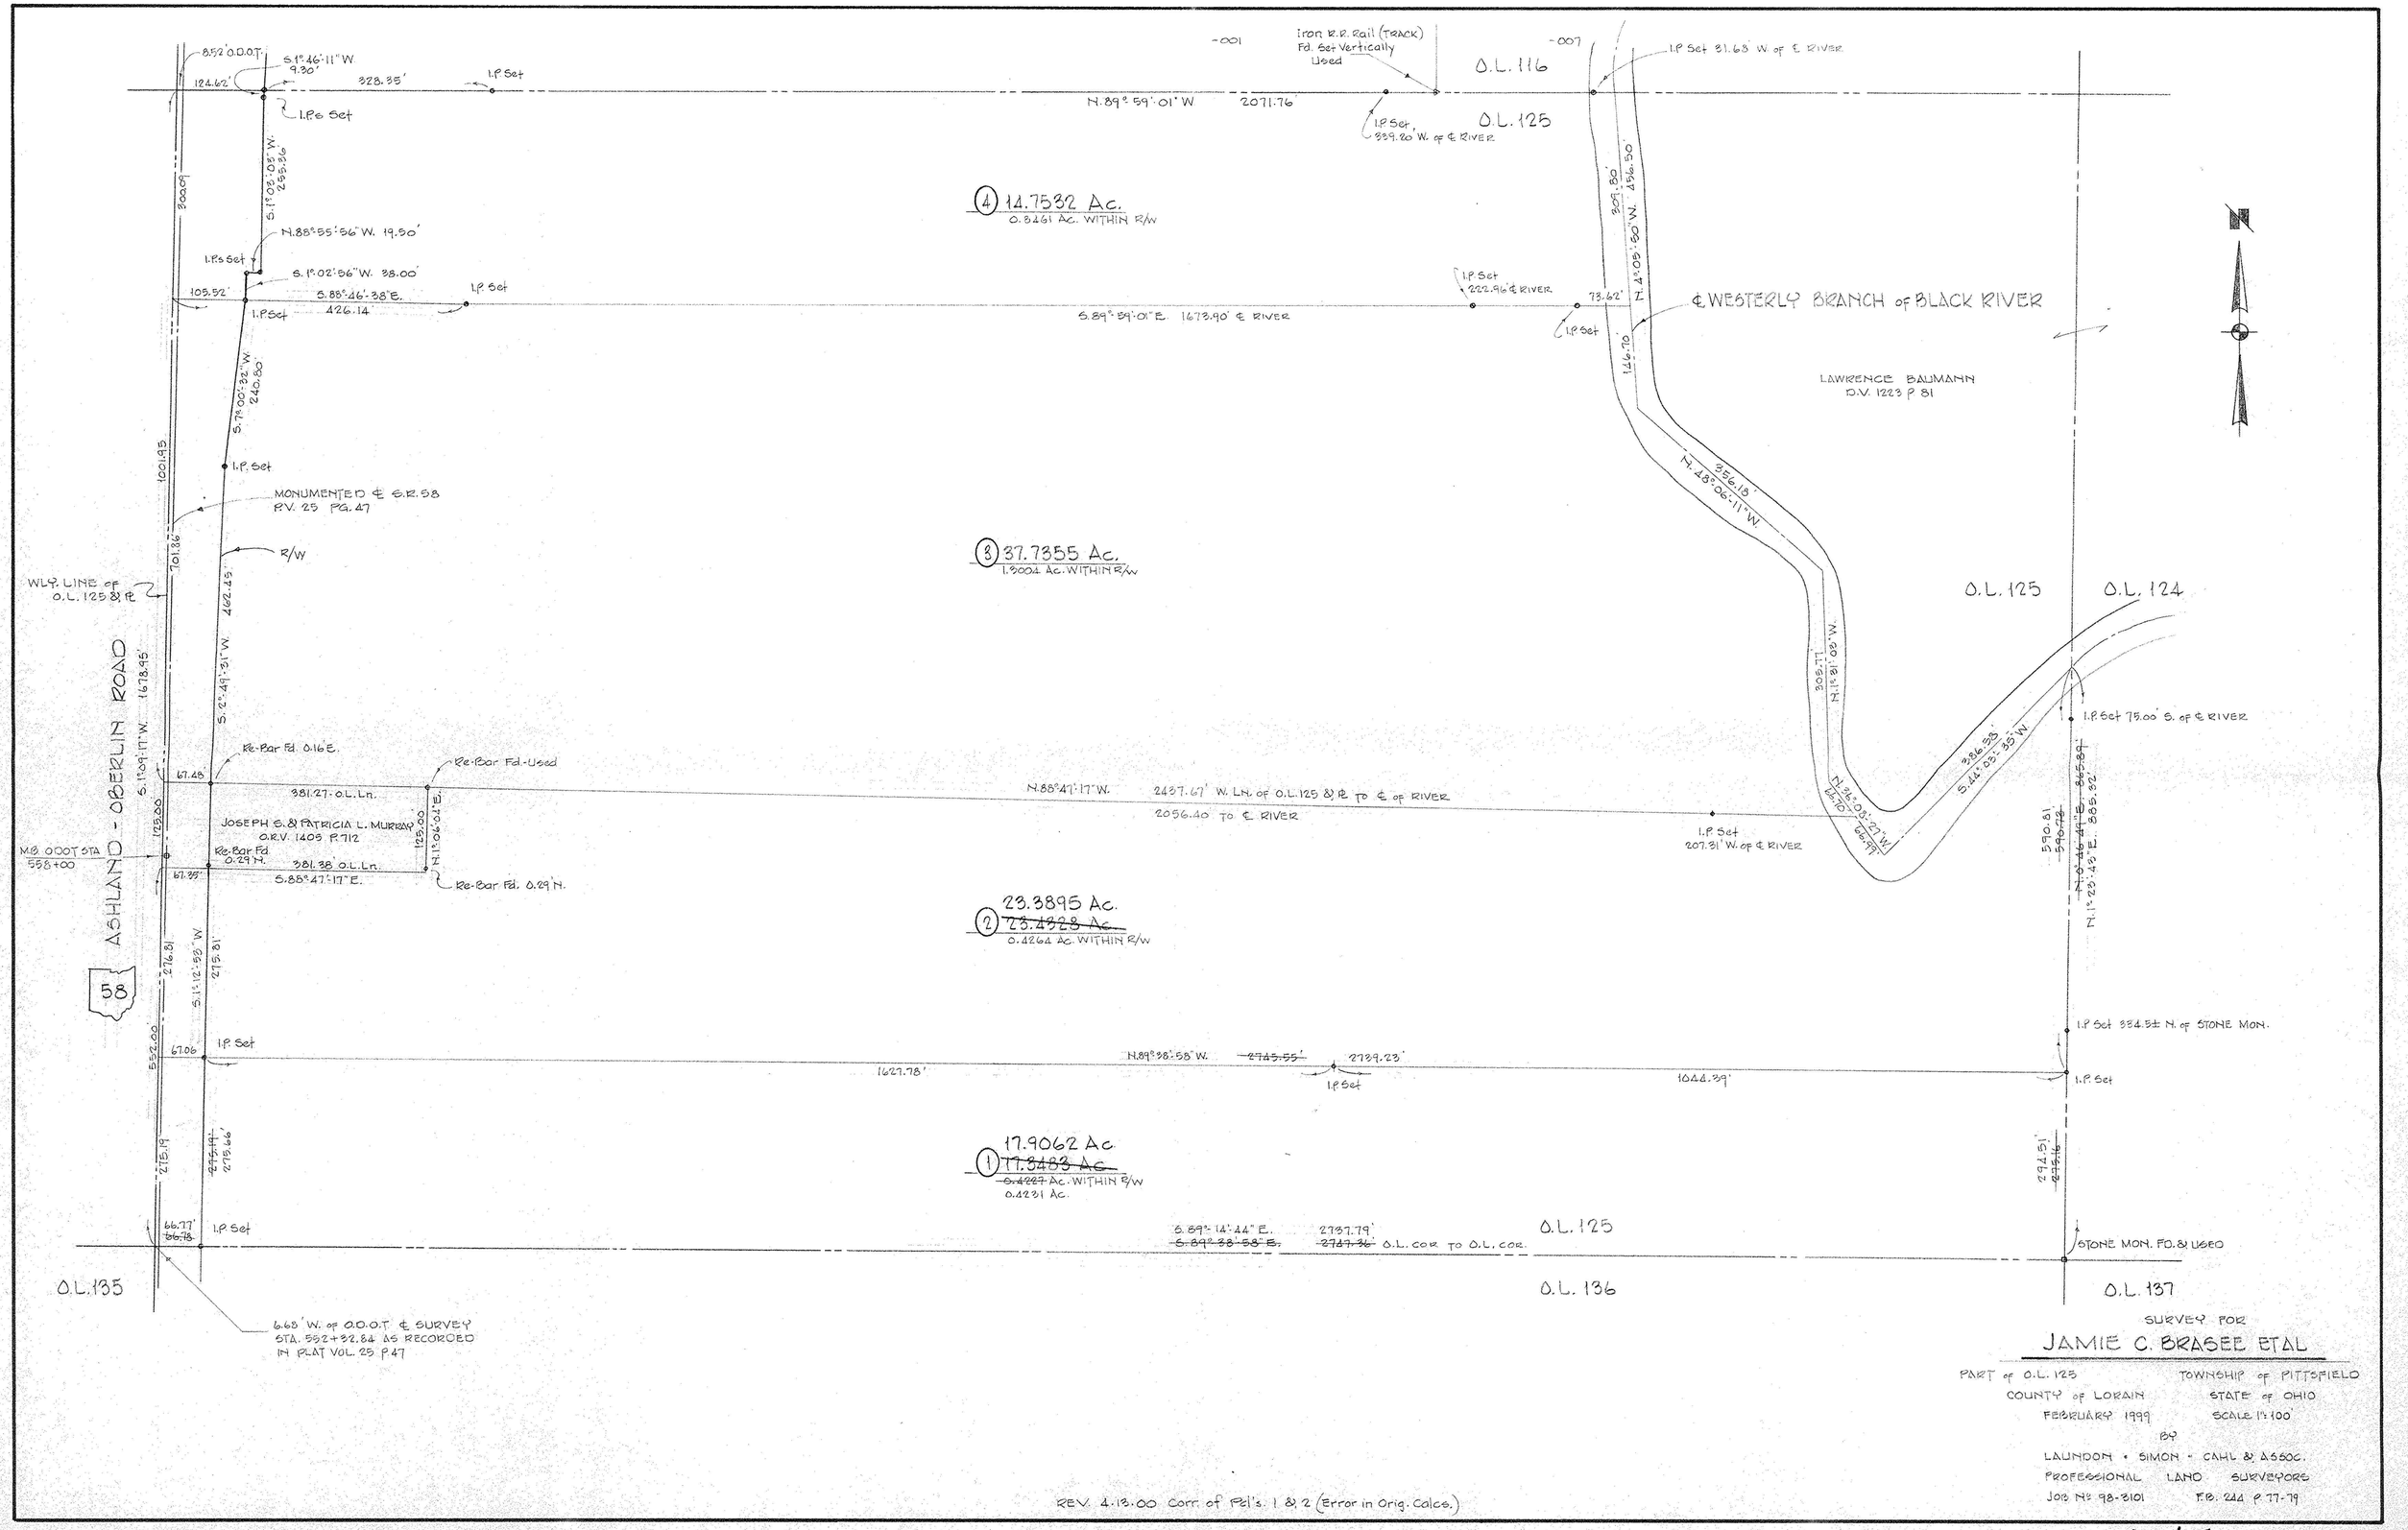

SURVEY FOR

JAMIE C. BRASEE ETAL

PART of O.L. 125 — TOWNSHIP of PITTSFIELD
COUNTY of LORAIN — STATE of OHIO
FEBRUARY 1999 — SCALE 1"=100'

BY

LAUNDON • SIMON • CAHL & ASSOC.
PROFESSIONAL LAND SURVEYORS
JOB No. 98-3101 — F.B. 244 P. 77-79

REV. 4.13.00 Corr. of Pcl's. 1 & 2 (Error in Orig. Calcs.)

#-00430-A T.M. Pg. 14-G 14.00-125-000-010/012 363