


MAP OF PART OF LOTS 129 & 130 FIELD TWP. 1 RANGE 5 CHIO
 SCALE 1"=200' SEPT 17, 1988 BY A.F. KEEFE SURVEYOR
 Rev Oct 27-82 1.29 AC ±

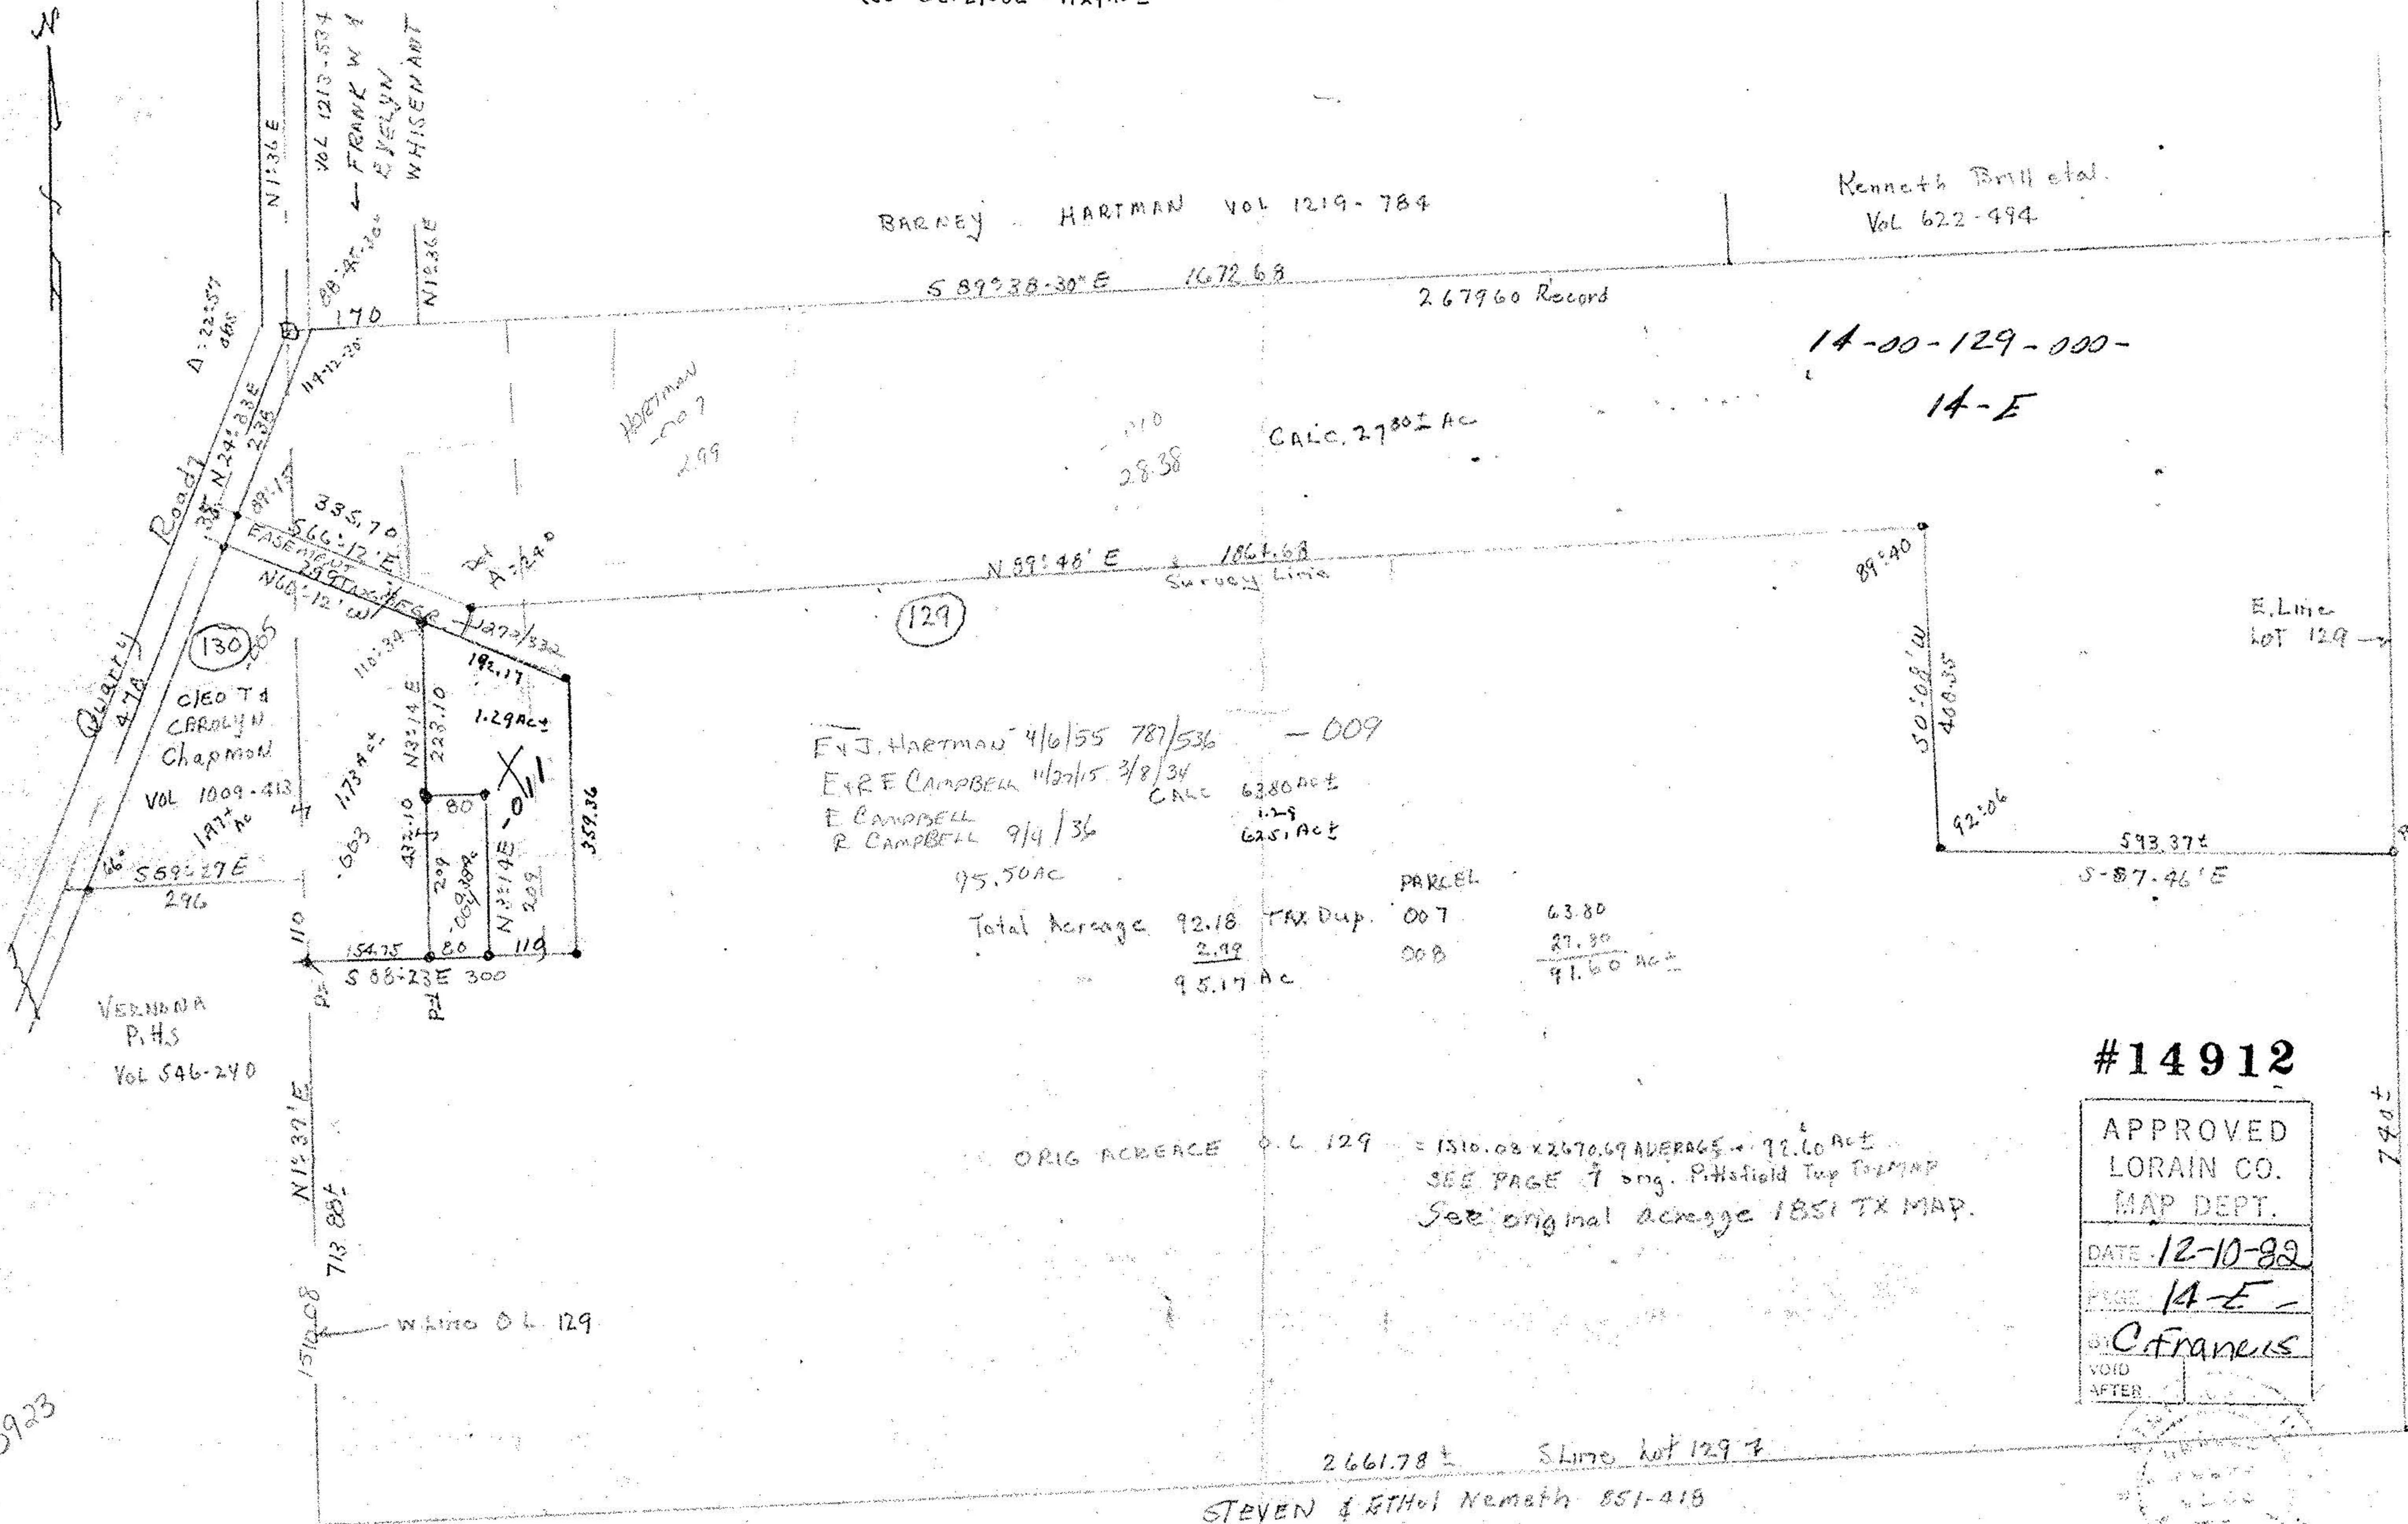

BARNEY HARTMAN VOL 1219-784

Kenneth Brill et al.
 Vol 622-494

S 89° 38' 30" E 1672.68
 2.67960 Record

14-00-129-000-
 14-E

Calc. 27.30 ± Ac

N 89° 48' E 1864.68
 Survey Line

(129)

E & J. Hartman 4/6/55 787/536 - 009
 E & R Campbell 11/27/5 3/8/34
 E Campbell 1-29
 R Campbell 9/4/36 625.1 AC ±

Total Acreage	92.18	Tax Dup.	007	63.80
	2.99	008		27.30
	95.17 AC			91.60 AC ±

ORIG ACRESAGE O.L. 129 = 1510.08 x 2670.69 AVERAGE = 92.60 AC ±
 SEE PAGE 7 Orig. Pittsfield Topog MAP
 See original acreage 1851 TX MAP.

#14912

APPROVED LORAIN CO. MAP DEPT.	
PAGE	14-E
BY	C. Francis
VOID AFTER	

2661.78 ± S Line Lot 129 ±
 STEVEN & Ethel Nemeth 851-418

13923