


Scale 1" = 200'


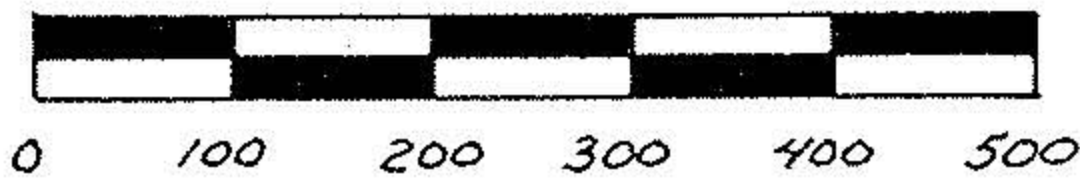


November 2001
Job No. 1401-08

Ex. Fence line



SURVEY FOR
FRED McCONNELL
PITTSFIELD TWP. O.L. 136 & 137
LORAIN COUNTY STATE OF OHIO
CARLSON SURVEYS
440-926-0200

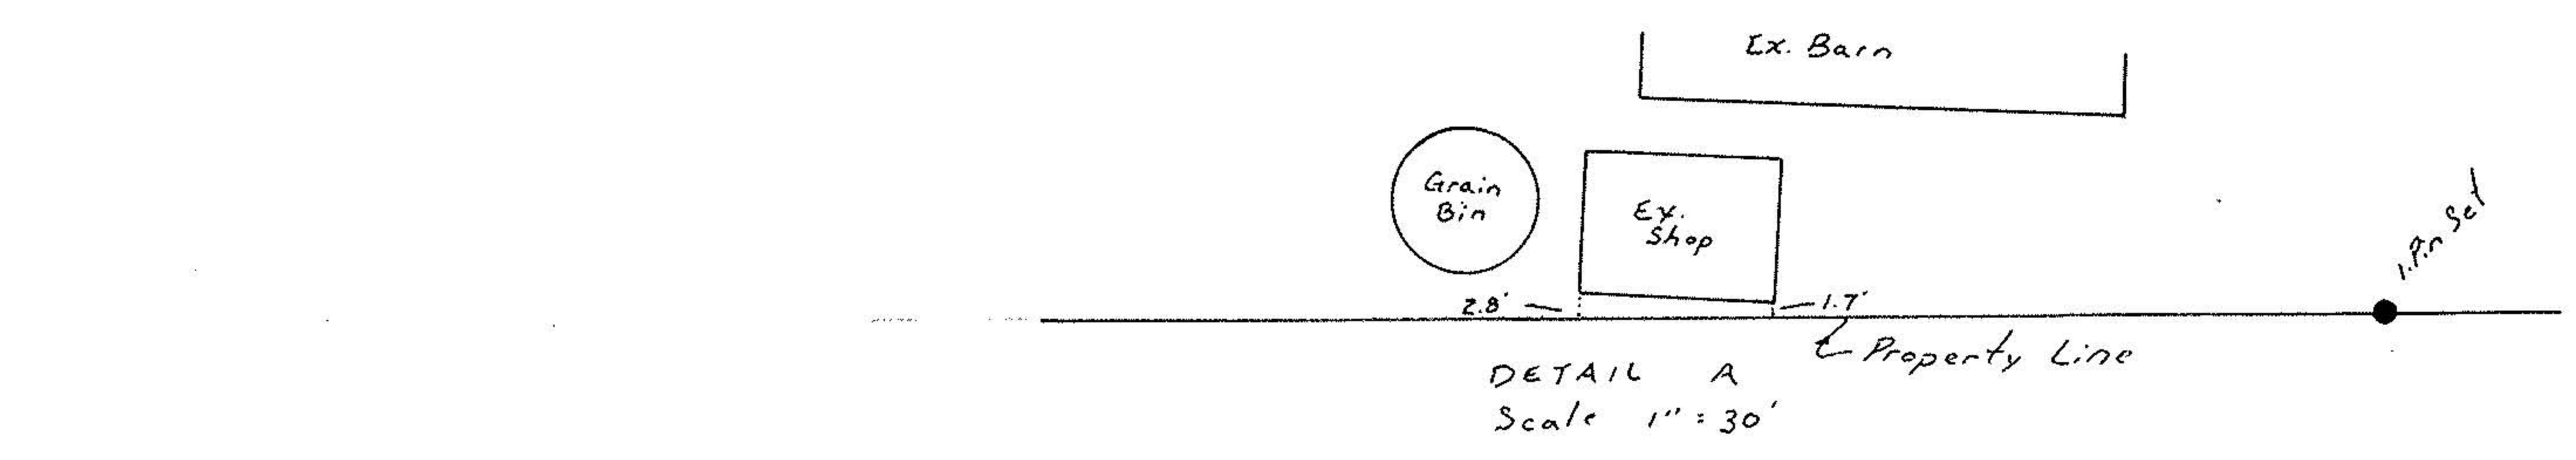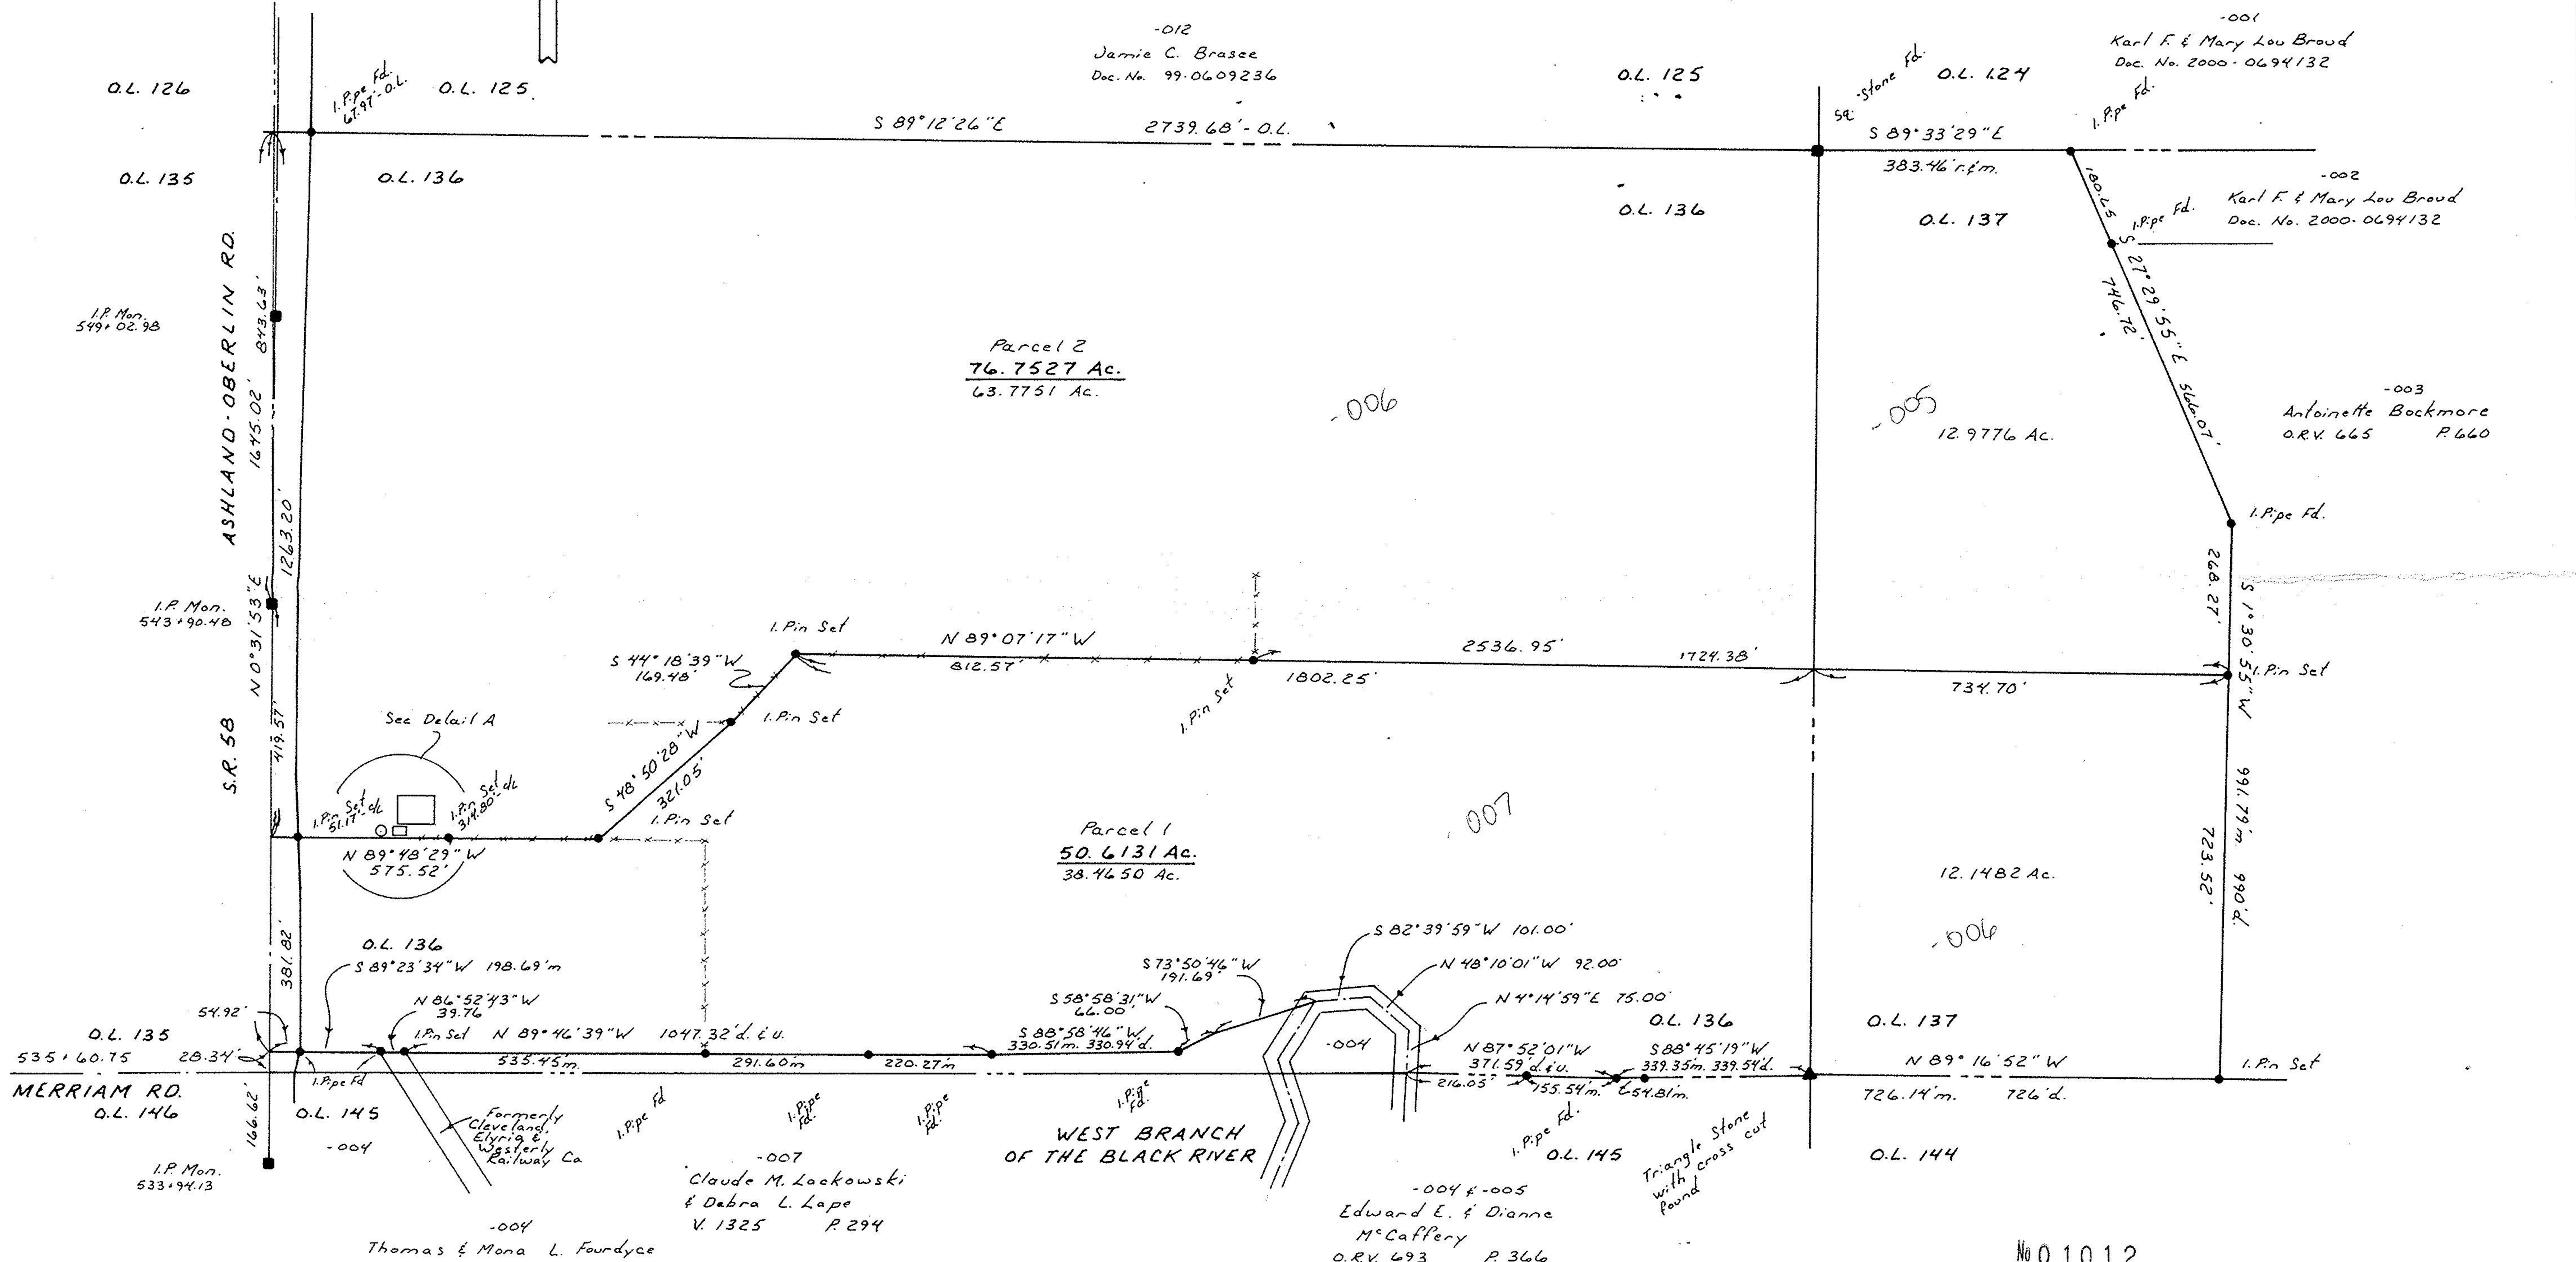

No 01012
APPROVED
LORAIN CO.
MAP DEPT
DATE 3-18-02
PAGE 14-G
BY JHATFIELD
02-01012

