MAP OF SURVEY AND LOT SPLIT

PREPARED FOR

PAULINE B. HAYES

SITUATED IN THE TOWNSHIP OF PITTSFIELD, COUNTY OF LORAIN, STATE OF OHIO
AND BEING PART OF ORIGINAL PITTSFIELD TOWNSHIP LOT NO. 148, 153, AND 154

N
W — E
S

SCALE : 1" = 100'

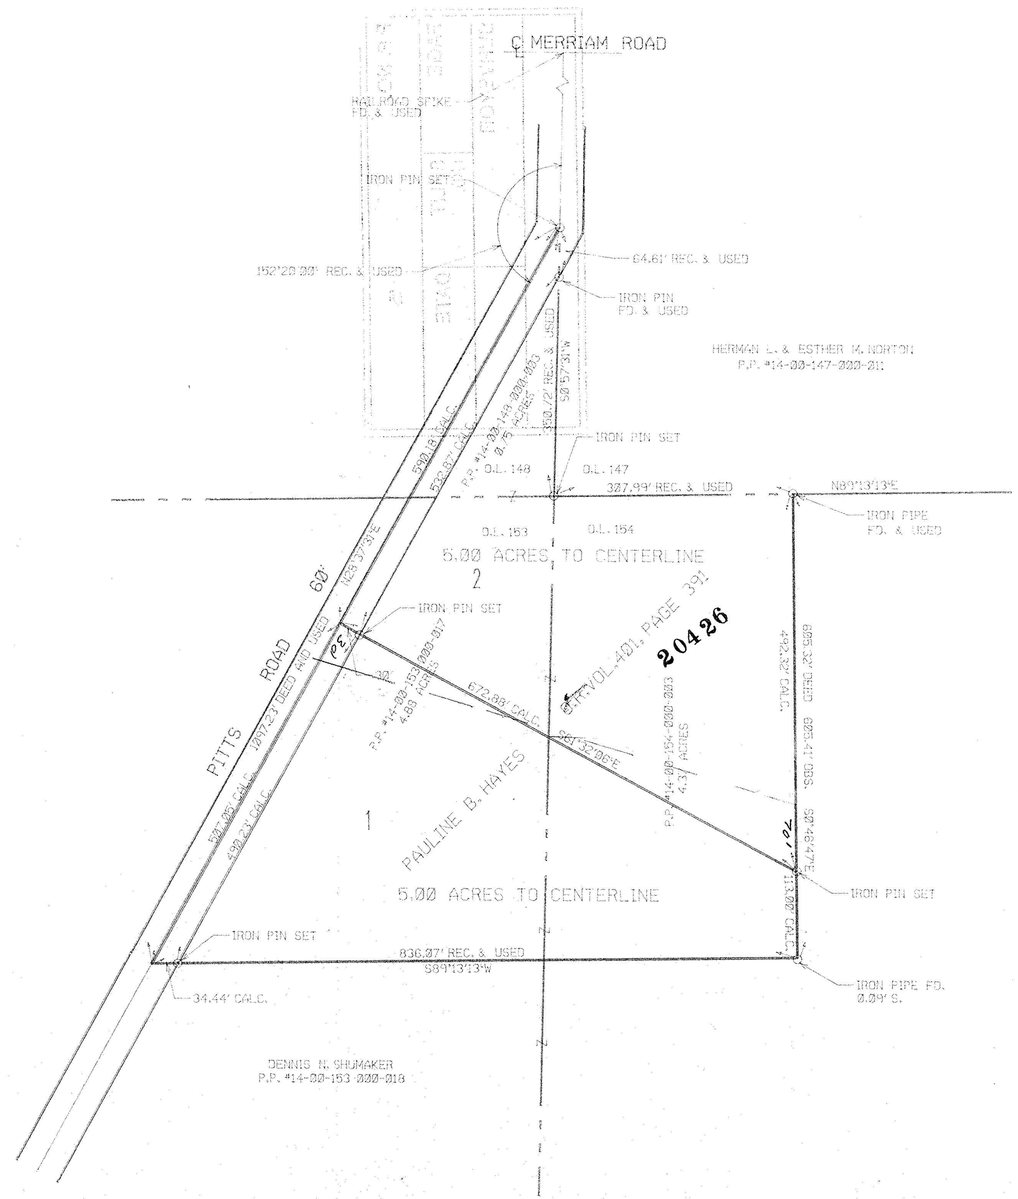

SURVEYOR'S STATEMENT

DISTANCES ARE EXPRESSED IN FEET AND DECIMAL PARTS THEREOF. BEARINGS ARE TO AN ASSUMED MERIDIAN AND ARE USED TO INDICATE ANGLES ONLY. PERMANENT MONUMENTS WERE FOUND OR SET AS INDICATED HEREON. ALL OF WHICH I DECLARE TO BE CORRECT TO THE BEST OF MY ABILITIES AND BELIEF.

Thomas M. Snezek 8-4-93
THOMAS M. SNEZEK, P.E.,P.S. 7051 DATE

STATE OF OHIO
THOMAS M. SNEZEK
S-7051
SURVEYOR

20526

APPROVED
LORAIN CO.
MAP DEPT.
DATE 10-5-93
PAGE 14-F
BY CAROLYN FRANCIS
VOID AFTER 11 20526

14-00-148
153
154

9315